

SANITARY SEWER FOR KOCH INDUSTRIES INC.
 BUILT BY: W.B. CARTER CONST. CO.
 PROJ. N^o 468-76-245-80000-000-008
 BOOKED 3-19-82 FROM DCD 163


SCALE 1" = 300'

SANITARY SEWER FOR CARGILL INC.
 BUILT BY: PEARSON EXCAVATING INC.
 PROJ. N^o 468-76-245-80000-000-008
 BOOKED 3-25-82 FROM DCD 197
 ALSO BUILT BY: UTILITY CONTR. INC.

SCALE 1" = 150'


TRAP AREA

TRAP AREA

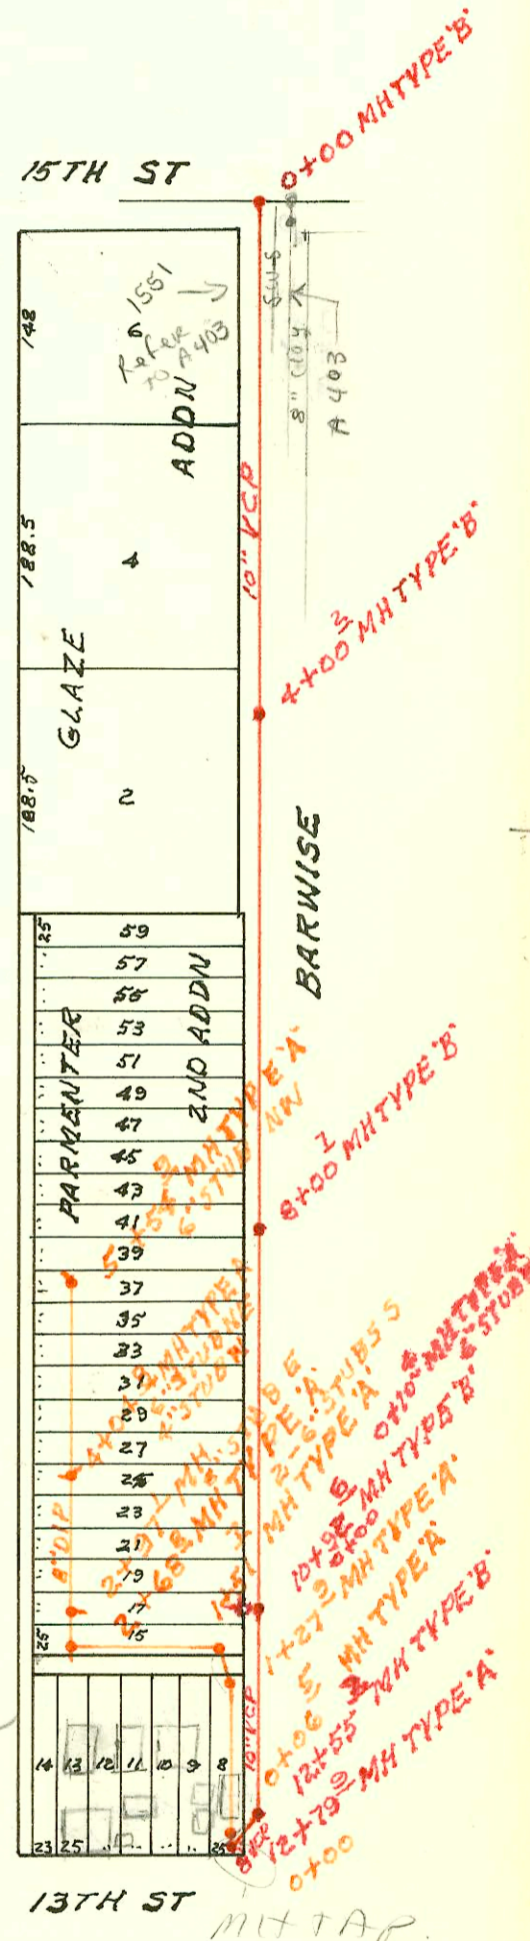

SANITARY SEWER FOR LOTS 1 & 2 JOE DRIVER ADDN
 BUILT BY: TRIPLE C CONST. CO.
 PROJ. N^o 468-76-245-80000-000-008
 BOOKED 3-25-82 FROM DCD 80-1-3

SCALE 1" = 150'

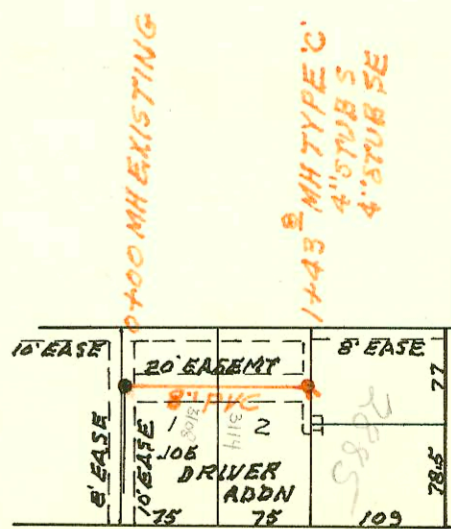

CONAMORE

HILLSIDE

H281

CONSTRUCTION RECORD							SERVICE RECORD					
STATION	ELEVATION		Depth	MANHOLE	4-INCH "Y" BRANCHES		No. of Permit		House Number		DATE OF PERMITS	
	Ground	Grade			North West	South East	North West	South East	North West	South East	North West	South East
SAN SEWER KOCH IND. (CONT'D)												
11+00	174.6	158.60 162.11	6.0 12.5	11+14.3	4" 50# 35 12+05.3 tap		21749		4121 37th NO	810 G		10-24-88
12+00		162.45			6" 50# 35 92' 100' 114			PR 251017	4121 # G 37th NO	4111 # F 37th # F		8-31-92
13+00		162.85			4" 50# 35 13+87.5 tap		21774		4121 # G 37th NO			10-24-88
14+00		163.25 163.49			4" 50# 35 13+14.5 tap		21775		4121 37th NO	810 G		10-24-88
15+00		163.65										
16+00		164.05										
17+00		164.45										
18+00		164.85 164.88										
19+00	177.1		12.2	18+05.7								
20+00		165.25										
21+00		165.65										
21+00	176.2	166.05 166.27	9.9	21+54.4	4" STUB NW	4" STUB NE						
SAN SEWER FOR CARGILL INC.												
0+00	117.3	107.87	9.4	0+00								
1+00	116.8	108.11	8.7									
2+00	116.6	108.35	8.3									
3+00	116.5	108.59	7.9									
4+00	116.8	108.83	8.0	4+00.2								
5+00	116.8	109.07	7.7									
6+00	116.8	109.31	7.5									
7+00	117.0	109.55	7.5									
	117.2	109.79	7.4	8+00.7								
9+00	116.9	110.03	6.9									
10+00	117.0	110.27	6.7									
	116.6	110.50	6.1	10+92.6								
11+00	116.6	110.51	6.1									
12+00	116.3	110.75 110.88 111.07	5.6 5.2 5.0	12+55.2								
	116.2	111.25 111.28	5.0 4.9	12+79.9								
0+00	116.2	111.28 111.30 111.33	4.9 4.9 4.9	0+06.5	0+00= 12+79.9							
1+00	116.8	111.88 112.05 112.08	4.9 5.4 5.3	1+27.9								
	117.4	112.27 112.30	4.9 4.7	1+51.7								
2+00	117.8	112.65 113.15 113.18	5.2 4.5 4.4	2+68.8								
	117.6	113.31 113.34	5.4 5.4	2+97.1								