


H282A


SANITARY SEWER FOR BOSTON PARK
BUILT BY: JIM & DAVE CONST. CO.
PROJ. NO 468-76-245-80805-000-000-008
BOOKED 3-26-82 FROM DCD 197

San Map

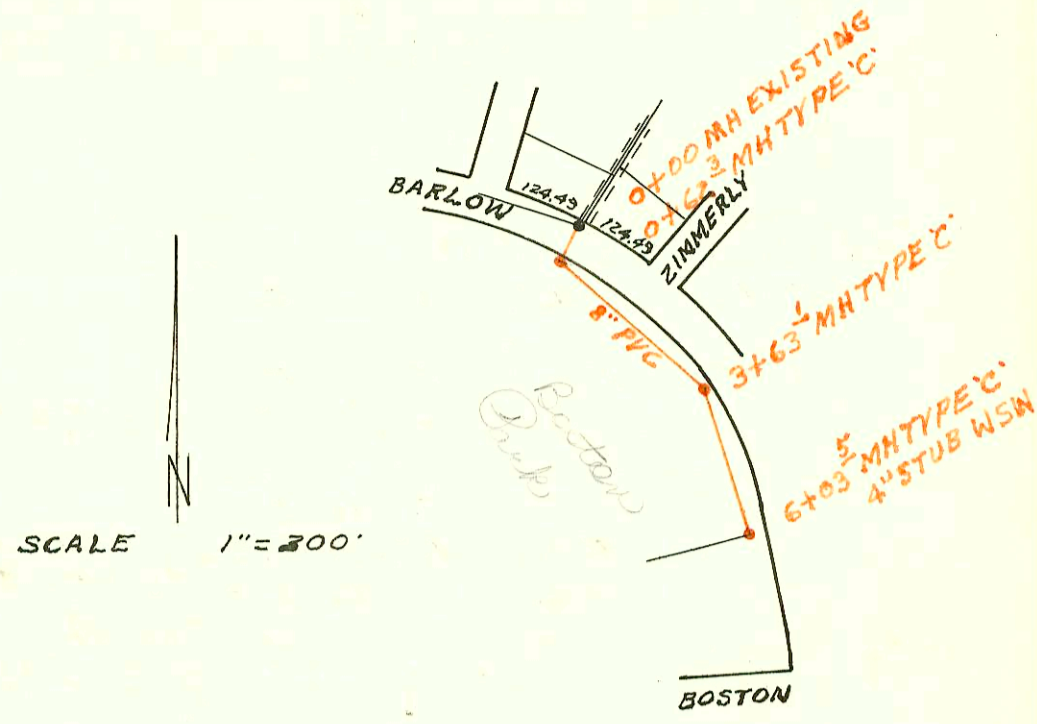


SANITARY SEWER FOR WICHITA MANOR
BUILT BY: UTILITY CONTR. INC.
PROJ. NO 468-76-245-80000-000-000-008
BOOKED 3-29-82 FROM BR58

San Map

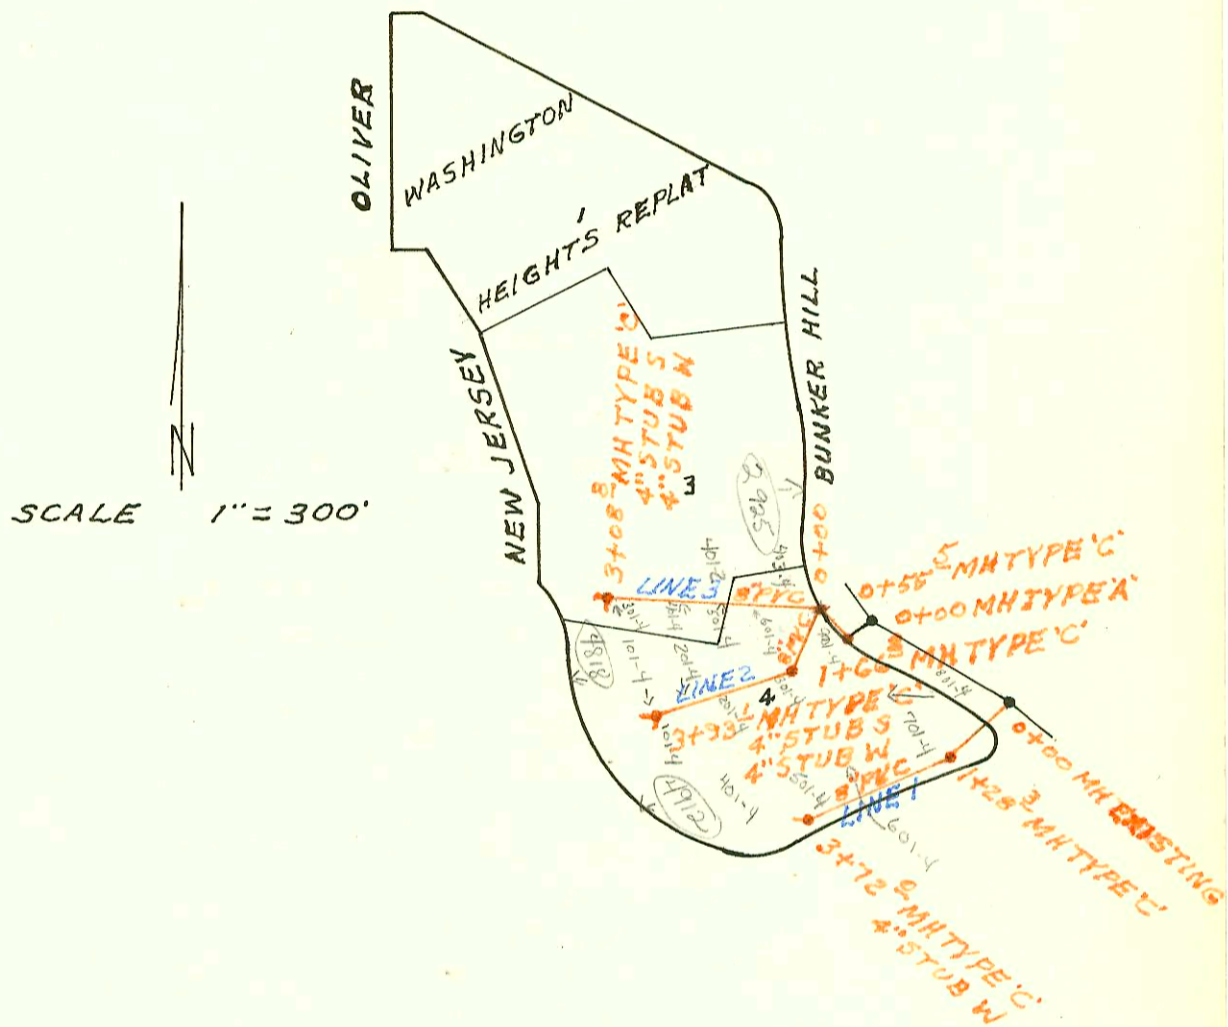

SANITARY SEWER FOR PT OF LT1 BLK 1
REPLAT OF BLK 1 SUNNYBROOK ADDN.
BUILT BY: UTILITY CONTR. INC.
PROJ. NO 468-76-245-80000-000-000-008
BOOKED 3-30-82 FROM

San Map

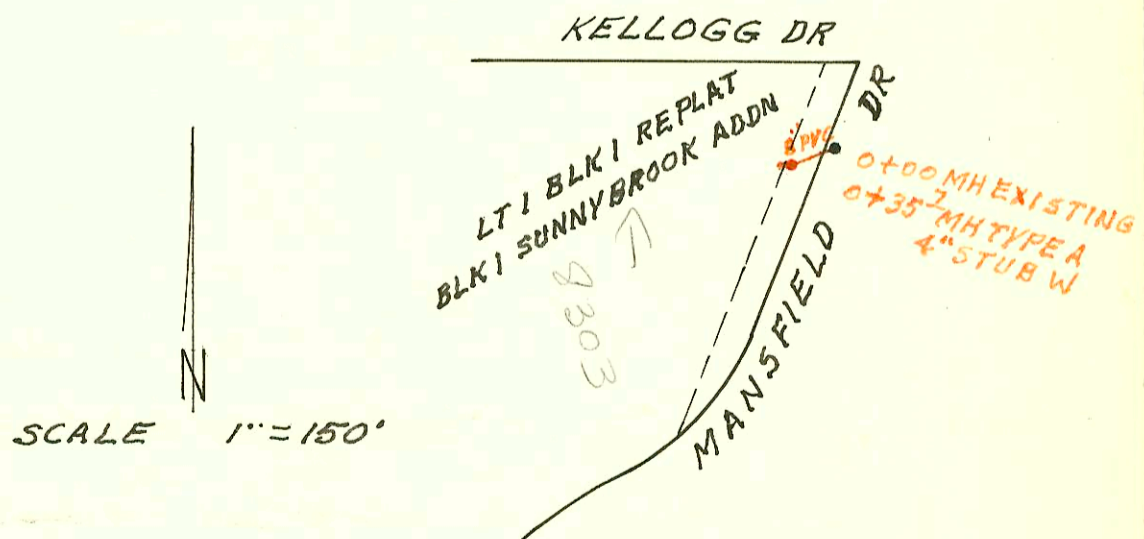

CONSTRUCTION RECORD							SERVICE RECORD					
STATION	ELEVATION		Depth	MANHOLE	4-INCH "Y" BRANCHES		No. of Permit		House Number		DATE OF PERMITS	
	Ground	Grade			North West	South East	North West	South East	North West	South East	North West	South East
SAN SEWER FOR CARGILL (CONT'D)												
3+00	119.0	113.36	5.6									
4+00	119.2	114.08	5.1									
	119.1	115.70	3.7	4+04.8	4" STUB W	6" STUB NE						
5+00	119.1	116.10	3.0									
	119.3	116.51	2.8	5+54.9	6" STUB W							
0+00	116.6	110.67	5.9	0+00=10+98.6								
	116.7	110.72	6.0	0+10.4	6" STUB W							
SAN SEWER FOR LOTS 1 & 2 JOE DRIVER ADDN												
0+00	103.6	94.63	9.0	EXISTING								
1+00	104.5	95.03	9.5									
	104.5	95.21	9.3	1+43.8	4" STUB S	4" STUB SE	2822	2823	2814	2823	3-11-81	3-11-81
SAN SEWER FOR BOSTON PARK												
0+00		138.22		EXISTING								
	148.0	138.84	9.2	0+62.3								
		139.04	9.0									
1+00		139.42			115.1		3942		6555 E	Zimmerly	8-18-81	
2+00		140.42										
3+00		141.42										
	152.5	142.05	10.5	3+63.1								
		142.25	10.3									
4+00		142.62										
5+00		143.62										
6+00		144.62										
	150.6	144.66	5.9	6+03.5								
SAN SEWER FOR WICHITA MANOR												
0+00	139.26	129.63	9.6	EXISTING								
1+00		130.03										
	144.5	130.14	14.4	1+28.3								
		132.88	11.6									
2+00		133.17										
3+00		133.57										
	143.5	133.86	9.6	3+72.0	4" STUB W							
LINE 2												
0+00	138.2	126.08		EXISTING	4" STUB W	4" STUB SE	4651	4650	4912	4914	11-13-81	11-13-81
	137.6	126.25	11.4	0+55.5								
		128.30	9.3									
1+00		128.48										
	144.0	128.75	15.3	1+66.8								
		128.85	15.2									
2+00		128.98				2+07.7	4318		4912	4914	10-12-81	10-12-81
					3+43.1	2+95.8	4150	4317	4912	4914	9-21-81	10-12-81
3+00		129.38			3+60.1		4151		4912	4914	9-21-81	
	137.5	129.75	7.8	3+93.1	4" STUB W	4" STUB S	4319	4316	4912	4914	10-12-81	10-12-81
LINE 3												
0+00	137.6	126.34	10.9	EXISTING								
				0+00=0+53.5								
				LINE 2								
1+00		126.64				0+49.5	4153		4912	4914	9-21-81	
						0+85.5	4152		4912	4914		
2+00		126.94										
3+00		127.24										
	136.5	127.27	9.2	3+08.8	4" STUB W	4" STUB SW						
SAN SEWER FOR RT 1 BLK 1 REPLAT BLK 1 SUNNYBROOK ADDN												
0+00	143.5	132.15	11.4	EXISTING								
	144.1	135.03	9.1	0+35.7	4" STUB W		3968		8303 E	Kelly	9-30-81	