



LATERAL 11 MAIN 22 WAR INDUSTRIES SEWER  
BUILT BY: MID STATES CONST. CO.  
PROJ. NO 468-76-245-80979-000-000-001  
BOOKED 4-9-82 FROM AG 21

on map 13-34

SCALE 1" = 200'

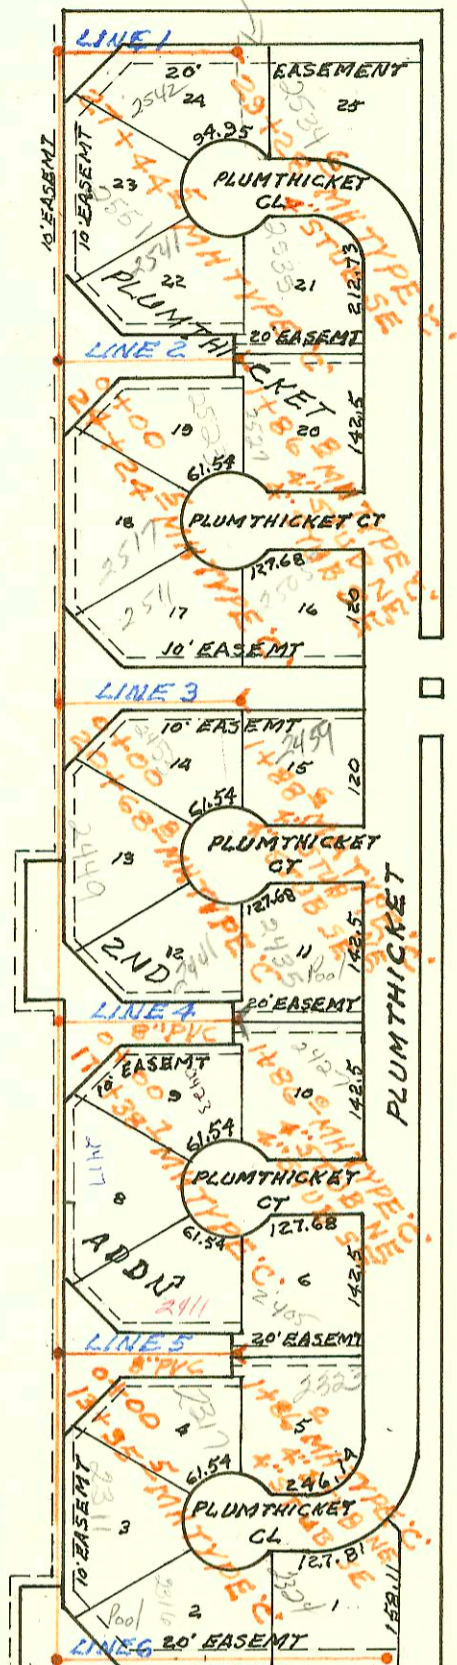


WEBB RD

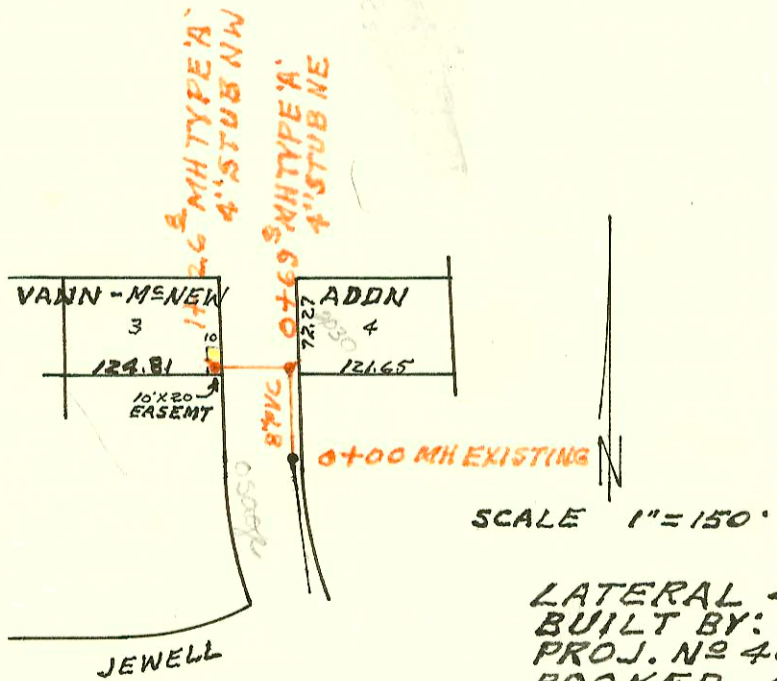

SCALE 1" = 150'

LATERAL 47 MAIN 2 SAN SEWER NO 22  
BUILT BY: UTILITY CONTR. INC.  
PROJ. NO 468-76-245-80792-000-000-001  
BOOKED 4-12-82 FROM KW 13

on map

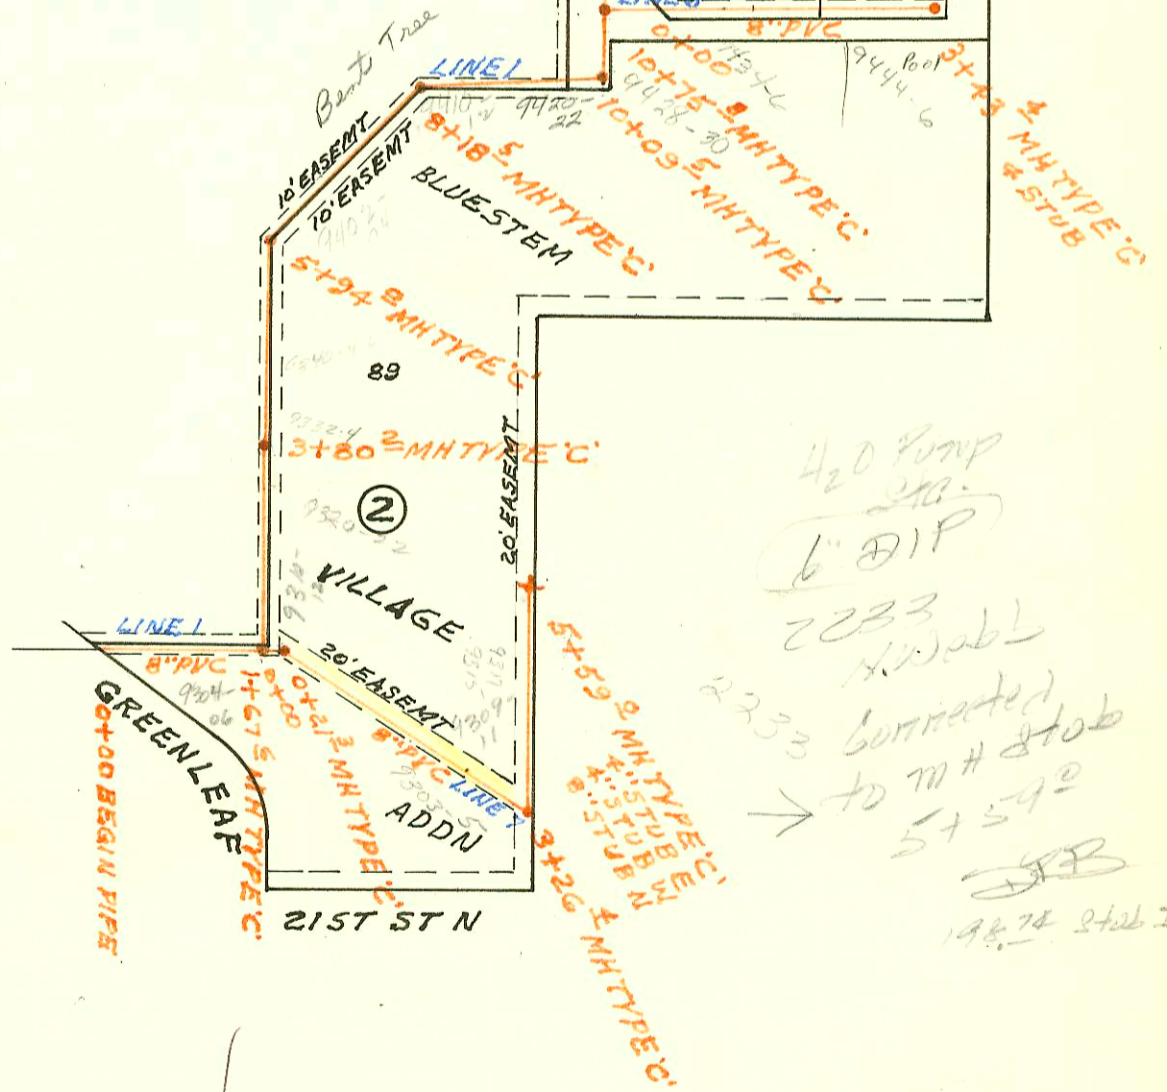

420 Pump  
200' 6" DIP  
2233  
2233 connected  
to MH #106  
57542  
19874 2nd Tr

CONSTRUCTION RECORD						SERVICE RECORD						
STATION	ELEVATION		Depth	MANHOLE	4-INCH "Y" BRANCHES		No. of Permit		House Number		DATE OF PERMITS	
	Ground	Grade			North West	South East	North West	South East	North West	South East	North West	South East
LAT 11 MAIN 22 WIS (CONT'D)												
LINE 1 CONT'D	29+00	221.9	212.80	9.1								
		221.7	212.92	8.8	29+28.6	4" STUB SE		9016		2534 Plumthick		8-12-83
LINE 2	0+00	224.4	210.90	13.5	0+00=24+24.5	LINE 1						
	1+00	224.8	211.90	12.9				4670		2523 Plumthick		11-16-83
		225.3	212.77	12.5	1+86.8	4" STUB NE 4" STUB SE	8340	9204	2535 Plumthick	2527 Plumthick	2-17-83	9-16-83
LINE 3	0+00	225.4	211.38	14.0	0+00=20+28.8	LINE 1						
								9224		2511 Plumthick		11-28-83
	1+00	225.8	212.86	12.9				9252		2453 Plumthick		9-22-83
		226.3	214.17	12.1	1+88.6	4" STUB NE 4" STUB SE	8739	8796	2505 Plumthick	2534 Plumthick	7-19-83	7-25-83
LINE 4	0+00	222.1	208.16	13.9	0+00=17+38.7	LINE 1						
								8797		2441 Plumthick		7-25-83
	1+00	222.1	208.56	13.5				12123		2423 Plumthick		9-26-83
		221.7	208.90	12.8	1+86.0	4" STUB NE 4" STUB SE	8063	8708	2435 Plumthick	2427 Plumthick	5-5-83	7-14-83
LINE 5	0+00	216.7	204.24	12.5	0+00=13+35.5	LINE 1						
	1+00	216.1	205.24	10.9				6418		2317 Plumthick		8-26-83
		215.5	206.10	9.4	1+86.0	4" STUB NE 4" STUB SE	1010	8774	2405 Plumthick	2322 Plumthick	11-17-82	7-22-83
LINE 6	0+00	212.1	200.70	11.4	0+00=10+75.8	LINE 1						
								13731		2424 Plumthick		5-2-85
	1+00	211.0	201.70	9.3				13722		2430 Plumthick		5-9-85
								8663	14678	2316 Plumthick	2437 Plumthick	7-8-83
	2+00	212.7	202.70	10.0				14679		2436 Plumthick		9-13-85
								6066	15122	2324 Plumthick	2442 Plumthick	6-28-82
	3+00	213.8	203.70	10.1				15143		2446 Plumthick		12-4-85
		214.3	204.13	10.2	3+43.4	4" STUB						
LINE 7	0+00	207.2	195.72	11.5	0+00=1+27.6	LINE 1						
		206.8	195.81	11.0	0+21.3	0+73.7 0+77.3	10276	10275	7310 Rent tree	7306 Rent tree	2-22-84	2-22-84
	1+00	205.8	196.22	9.6								
	2+00	204.6	196.62	8.0				9234		9305 Rent tree		12-8-83
								9235		1003 Rent tree		12-8-83
	3+00	204.2	197.02	7.2								
		204.4	197.13	7.3	3+26.4	3+59.6	10272		9309 Rent tree		2-22-84	
			197.33	7.1								
	4+00	204.5	197.62	6.9				10273		9311 Rent tree		2-22-84
								10332		9315 Rent tree		2-22-84
	5+00	205.0	198.02	7.0				10332		9317 Rent tree		2-22-84
		205.7	198.26	7.4	5+59.0	4" STUB N 4" STUB W 4" STUB E			2324 Plumthick	10262 Plumthick		4-25-83
LATERAL 47 MAIN 2 5.5 N <sup>o</sup> 22												
	0+00	99.61	95.65	4.4	0+00 EXISTING							
		100.11	96.00	4.1	0+69.0	4" STUB NE		5302		2030 S Osage		3-5-84
			96.11	4.0								
	1+00	99.8	96.25	3.6								
		100.70	96.38	4.3	1+26.8	4" STUB NW						