
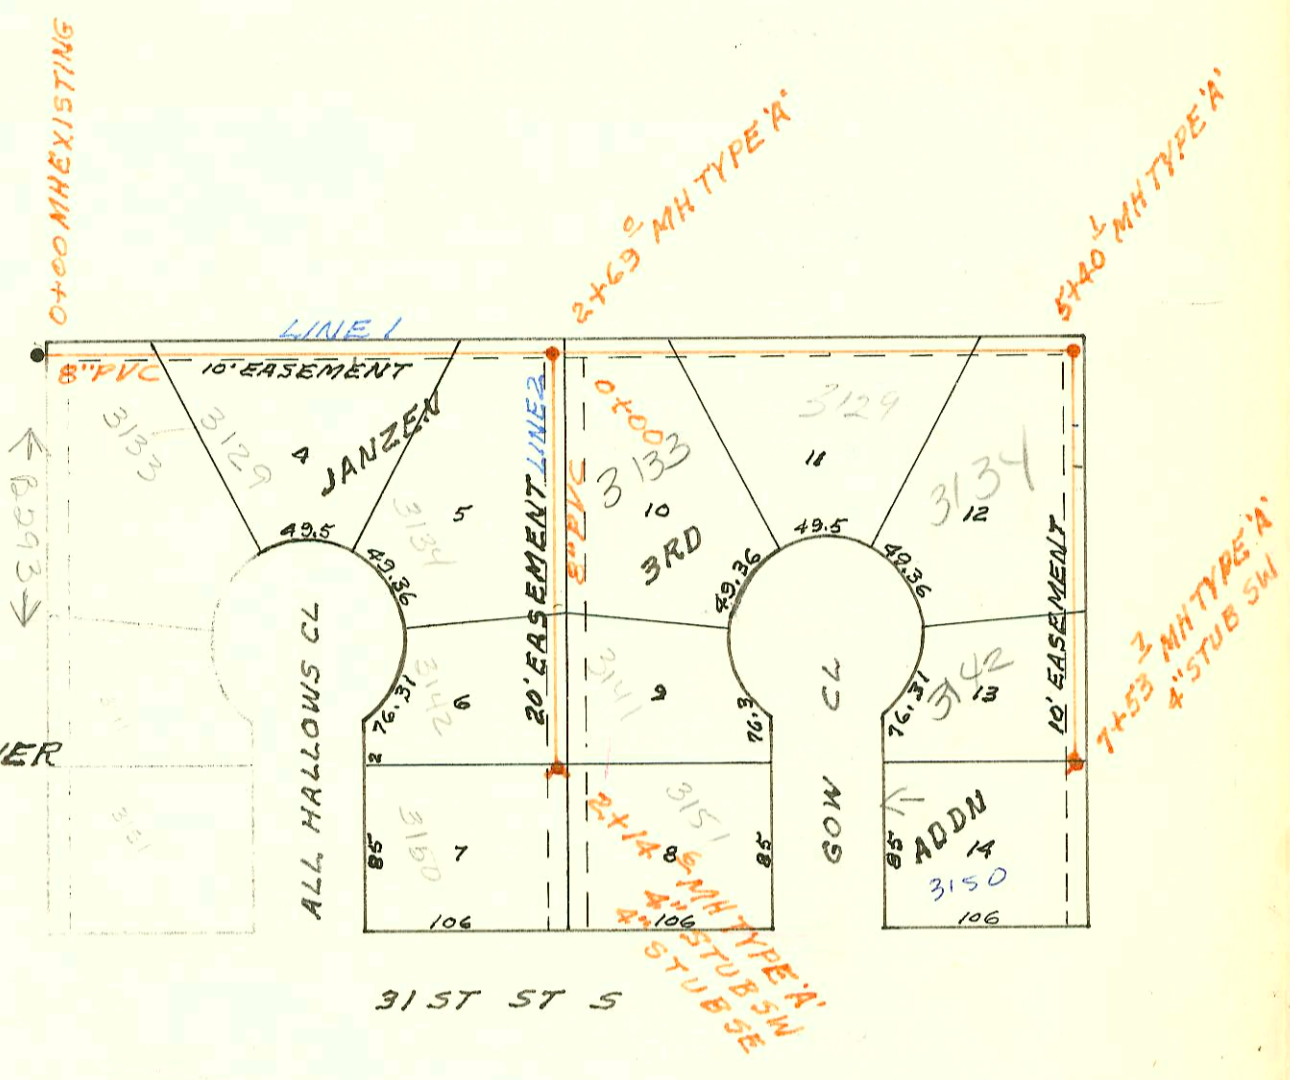


LATERAL 170 SOUTHWEST INTERCEPTOR SEWER
BUILT BY: MID STATES CONST. CO.
PROJ. N^o 468-76-245-81089-000-000-001
BOOKED 4-15-82 FROM DLK 453

on map
5-39

SCALE 1"=150'

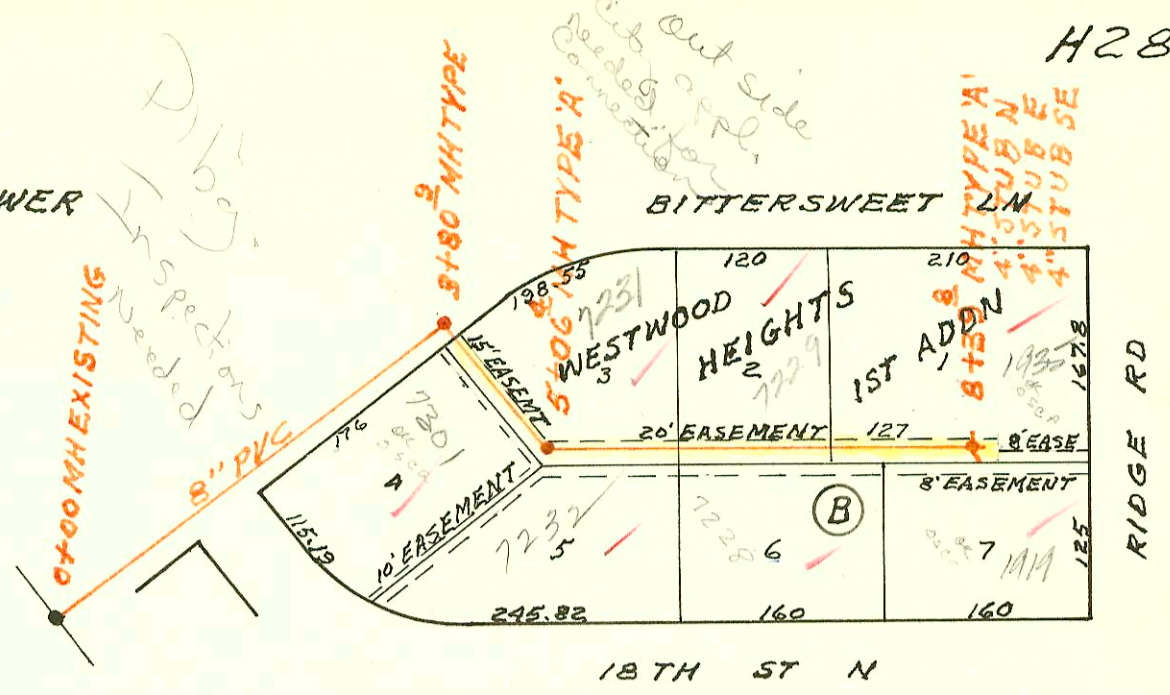

SCALE 1"=100'

LATERAL 169 SOUTHWEST INTERCEPTOR SEWER
BUILT BY: DULING CONST. CO. INC.
PROJ. N^o 468-76-245-81090-000-000-001
BOOKED 4-21-82 FROM TCD 51

on map
7-71


Easements
in folder
in bottom
file drawer
for Lat. 170

SCALE 1"=150'

See
D299

LATERAL 8 MAIN 22 WAR INDUSTRIES SEWER
BUILT BY: W.B. CARTER CONST. CO.
PROJ. N^o 468-76-245-80841-000-000-001
BOOKED 4-23-82 FROM CG 24

on map
13-22

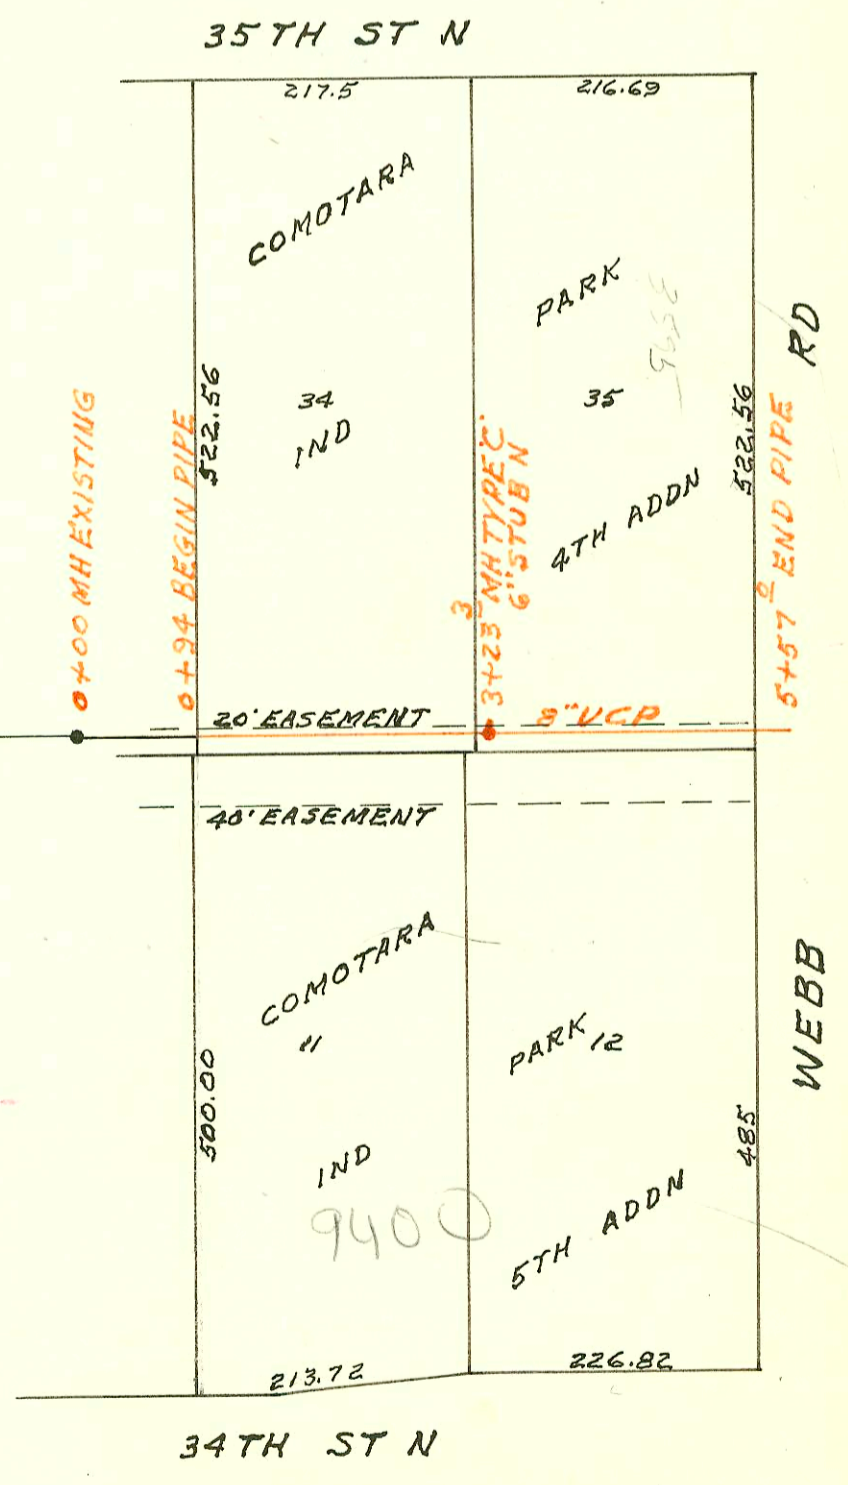

CONSTRUCTION RECORD							SERVICE RECORD					
STATION	ELEVATION		Depth	MANHOLE	4-INCH "Y" BRANCHES		No. of Permit		House Number		DATE OF PERMITS	
	Ground	Grade			North West	South East	North West	South East	North West	South East	North West	South East
LAT 170	SWI											
0+00	152.8	141.42	11.4	0+00 EXISTING								
1+00	151.2	141.62	9.6									
2+00	150.5	141.82	8.7									
3+00	150.3	142.02	8.3									
	150.0	143.54	6.5	3+80.9								
4+00	150.5	143.58	6.9									
5+00	150.5	143.78	6.7		5+00.4		5807		7301		5-7-88	
	151.0	143.89	7.1	5+06.4								
6+00	150.0	144.08	5.9					7697			3-2-83	
7+00	149.7	144.28	5.4		10+85.4		8249		7229		5-26-83	
8+00	149.5	144.48	5.0					6325	1328 W		3-18-82	
	149.8	144.56	5.2	8+39.8	1" stub N	4" stub SE	5880		1419		4-20-82	
					4" stub E		5881		1435		5-30-82	
LAT 169	SWI											
LIN 1 0+00	101.1	87.51	13.6	0+00 EXISTING				5345	3133		4-6-82	
1+00	100.0	87.89	12.1									
2+00	100.2	88.27	11.9									
	100.0	88.53	11.5	2+69.0								
3+00	100.0	88.66	11.3									
4+00	99.8	89.06	10.7									
5+00	100.2	89.47	10.7									
	100.5	89.63	10.9	5+40.1	5+97.1		19552		3134		11-10-87	
		89.75	10.8									
6+00	100.2	90.00	10.2									
7+00	100.4	90.42	10.0				18699		3142 S		7-15-87	
	100.0	90.64	9.4	7+53.7	4" stub SW		18474		3153 S		6-9-87	
LIN 2 0+00	100.0	88.56	11.4	0+00=2+69 LINE 1								
1+00	100.2	89.03	11.2		1+71.0		7246		3134		12-27-82	
2+00	100.1	89.49	10.6		1+81.8		7622		3192		3-8-83	
	100.2	89.56	10.6	2+14.6	4" stub SW	4" stub SE	9003	9319	3150		8-17-83	9-28-83
									3151			
LAT 8	MAIN 22 WIS											
0+00	242.8	222.80	20.0	0+00 EXISTING								
0+94	243.0	223.18	19.8									
1+00	243.0	223.20	19.8									
2+00	243.3	223.60	19.7									
3+00	243.6	224.00	19.6									
	244.2	224.09	20.1	3+23.3	6" stub N		5744		3345 N		4-2-82	
		224.21	20.0				11670		3345 S		11-21-82	
4+00	244.4	224.52	19.9									
5+00	244.4	224.92	19.5									
5+57	243.2	225.15	18.1									