



Autumn Ridge Add
Lots 7-14 Require
IN Lieu Fees Price to
issuing Sewer Permit
PR ENG. Dept
5-7-87 BF

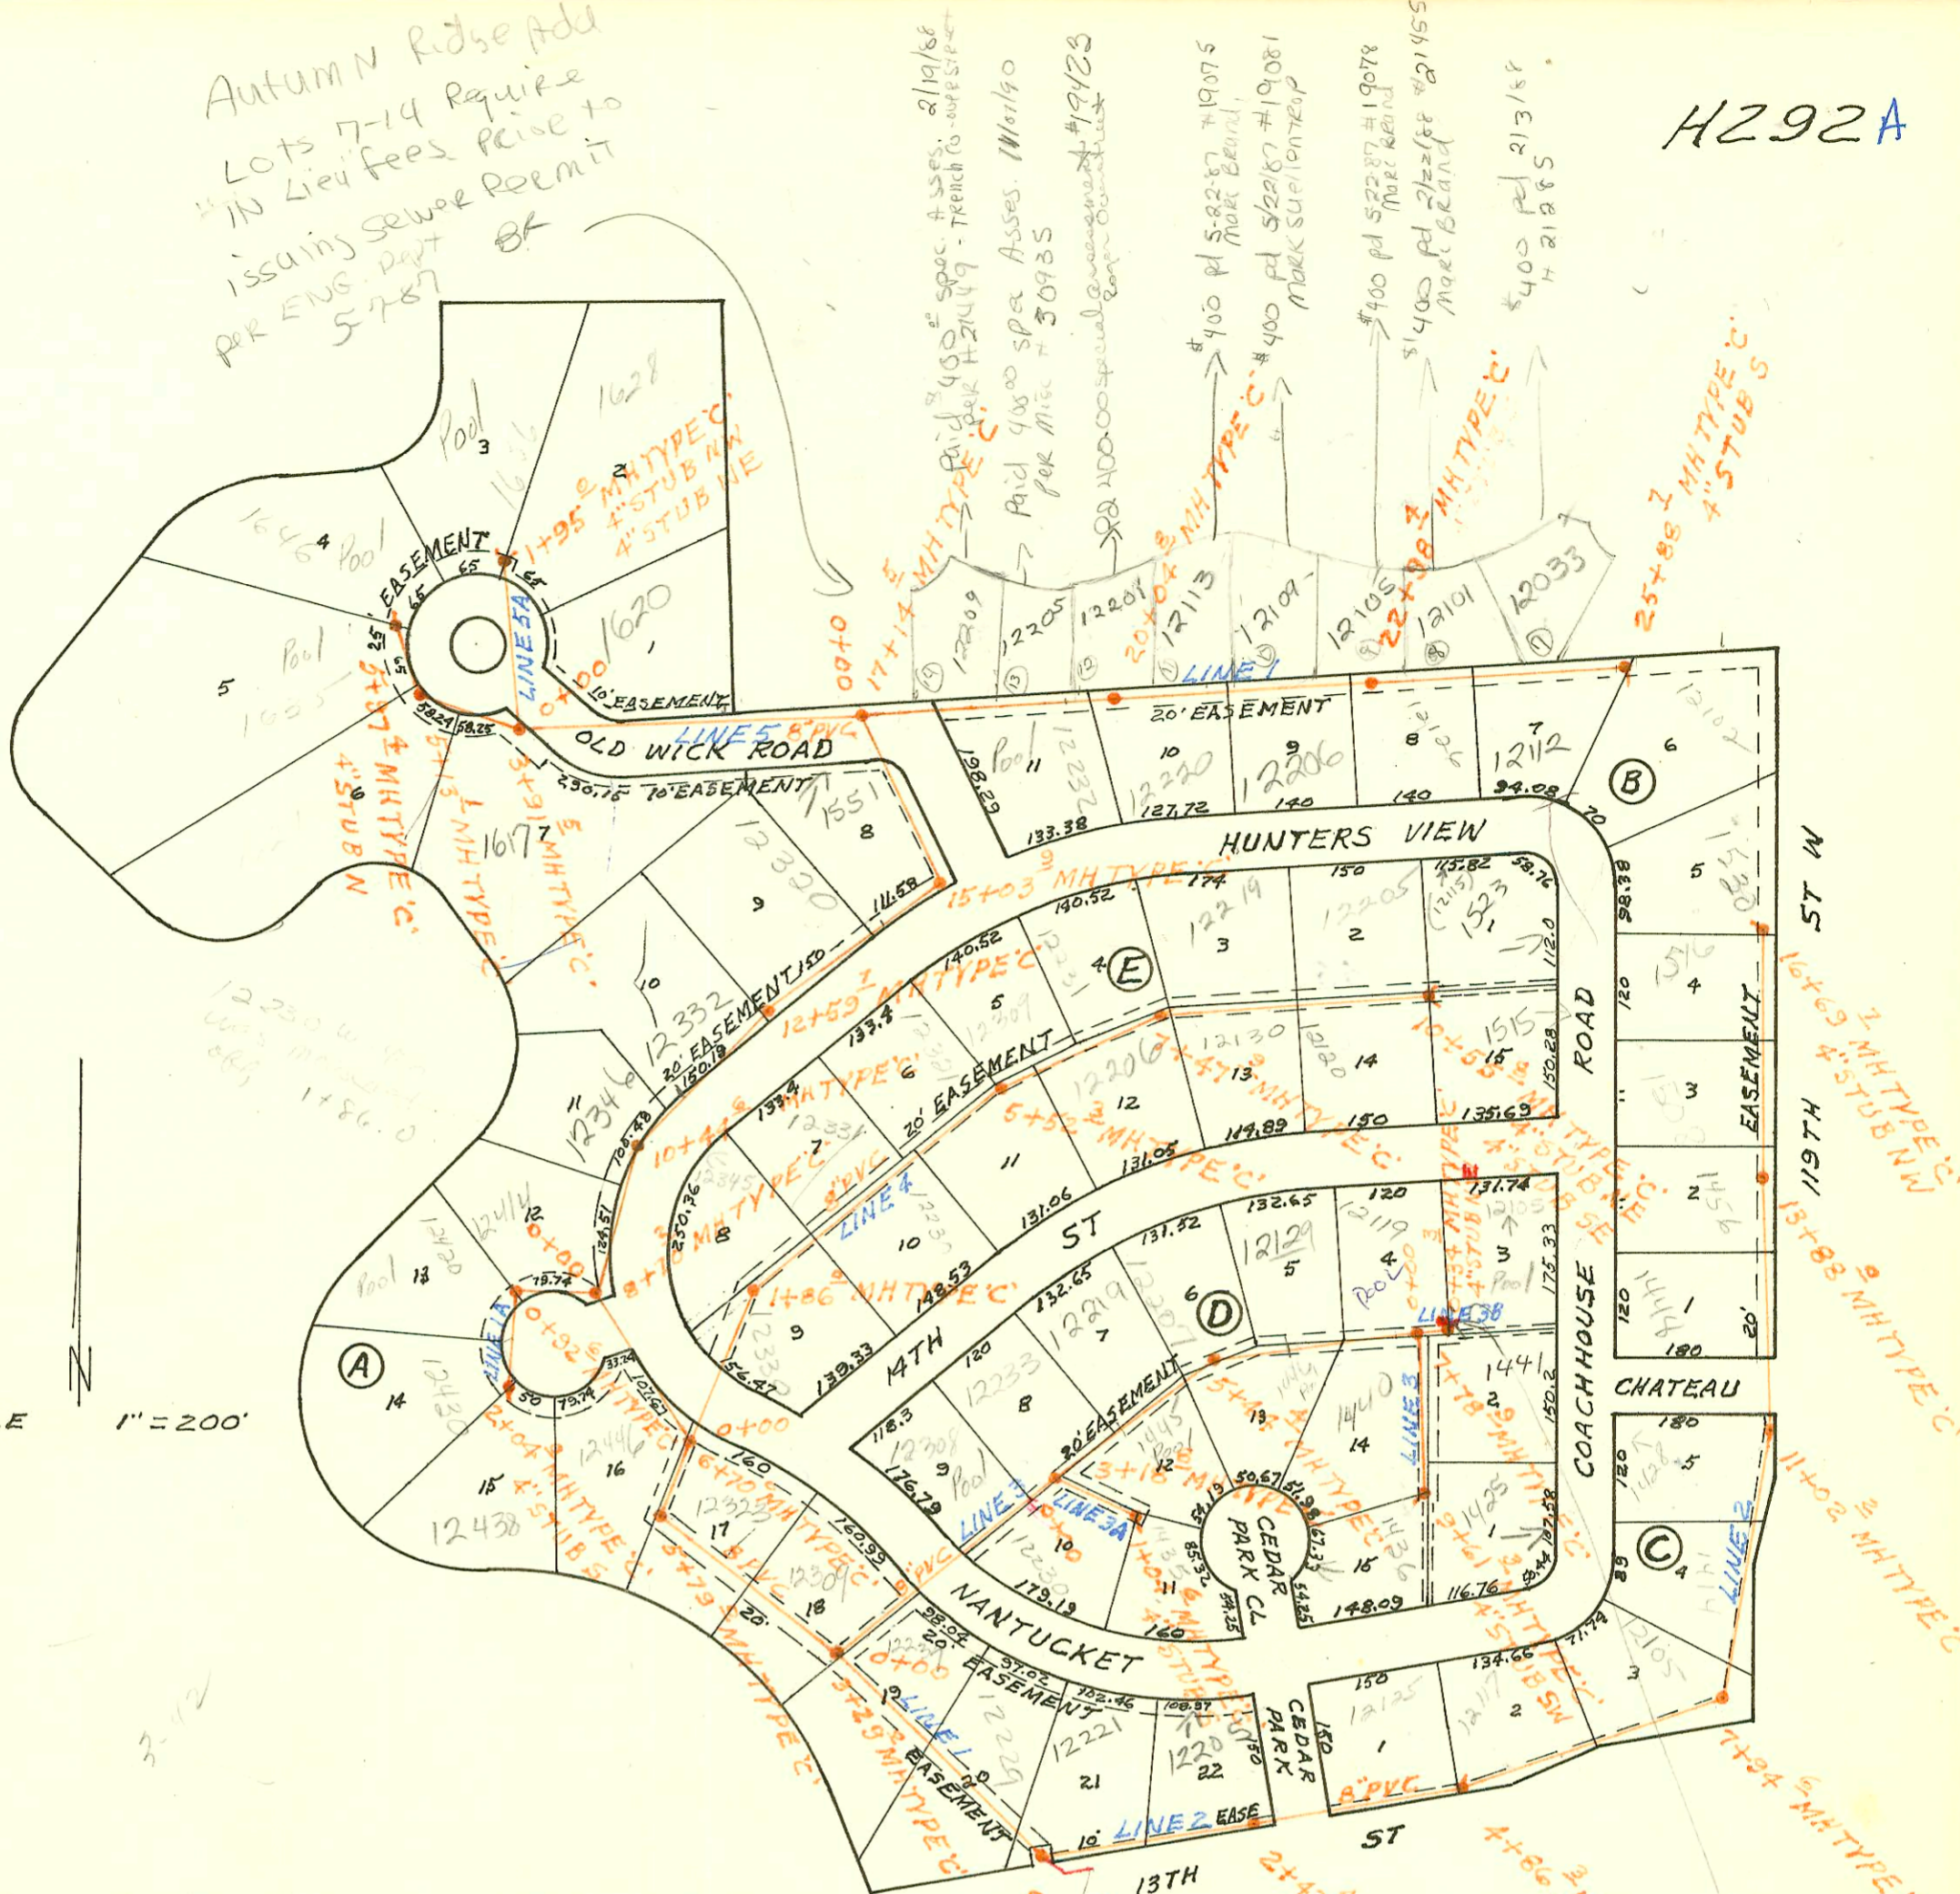

SCALE 1" = 200'

LATERAL 162 SOUTHWEST INTERCEPTOR
LIFT STATION & FORCE MAIN
BUILT BY: UTILITY CONTR. INC.
PROJ. No 468-76-245-81044-000-000-001
BOOKED 6-28-82 FROM SRL 3

on map w-112

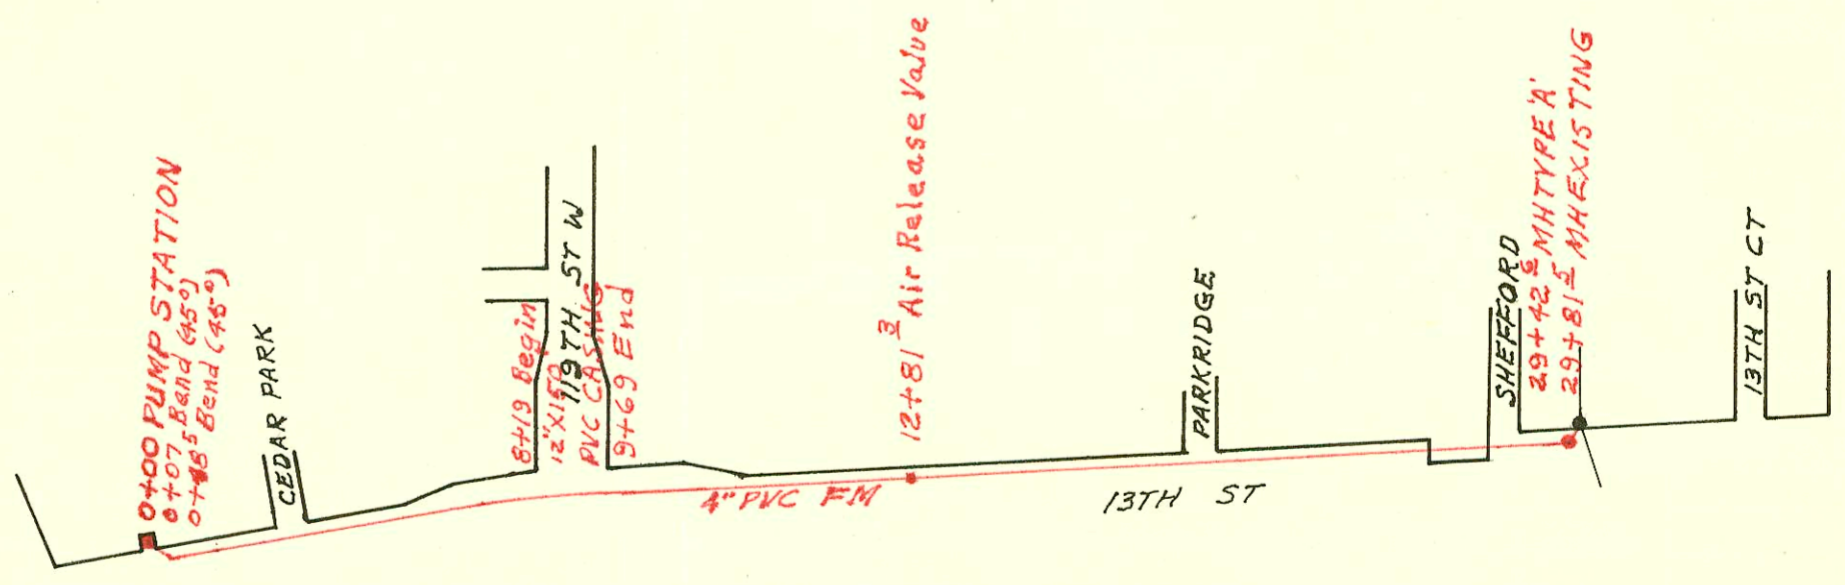

SCALE 1" = 400'

CONSTRUCTION RECORD						SERVICE RECORD						
STATION	ELEVATION		Depth	MANHOLE	4-INCH "Y" BRANCHES		No. of Permit		House Number		DATE OF PERMITS	
	Ground	Grade			North West	South East	North West	South East	North West	South East	North West	South East
LATERAL LINE 1	162	SOUTHWEST		INTERCEPTOR								
0+00	154.8	137.34	17.5	0+00 LIFT STA								
1+00	148.3	137.64	10.7		1+09.8 TAP		7846		12227 Nantucket		4-14-83	
2+00	147.7	137.94	9.8		2+29.0 TAP		10014		12237 Nantucket		1-30-84	
3+00	147.3	138.24	9.1									
	151.4	138.33	13.1									
		138.43	13.0	3+29.0	3+78.0 TAP		1734		12209 Nantucket		10-15-86	
4+00	147.7	138.64	9.1									
5+00	146.4	138.94	7.5		5+16.0 TAP				12323 W Nantucket		10-15-86	
	151.2	139.18	12.0		5+53.0 TAP		17126		12446 Nantucket		10-15-86	
		139.28	11.9	5+79.0								
6+00	146.0	139.34	6.7									
	153.6	139.52	14.1									
		139.65	14.0	6+70.0								
7+00	148.0	139.74	8.3									
8+00	147.6	140.04	7.6									
	155.2	140.25	15.0									
		140.35	14.9	8+70.2	8+87.3 TAP		17164		12474 W Nantucket		10-21-86	
9+00	147.8	140.44	7.4									
10+00	150.6	140.74	9.9		M.H. stub 4" SDR 35		1852		12346 Nantucket		1-13-92	
	157.1	140.87	16.2									
		140.97	16.1	10+44.6								
11+00	153.8	141.14	12.7		11+20 2" Riser 7" D NW							
					INSPECTOR SAND RISER 4" W-7 M							
12+00	157.1	141.44	15.7		4" PVC 40 12+19.7		23-26305-7		12322 W Nantucket		10-6-93	
	159.9	141.62	18.3									
		141.72	18.2	12+59.7								
13+00	159.6	141.84	17.8				4918		12320 Nantucket		12-15-81	
14+00	161.4	142.14	19.3		14+20 2" RISER 11" D NW		23841		1251 Nantucket		9-6-89	
15+00	162.4	142.44	20.0									
	162.1	142.45	19.7									
		142.55	19.6	15+03.9								
16+00	160.7	142.84	17.9									
17+00	161.0	143.14	17.9									
	160.8	143.18	17.6									
		148.24	14.9	17+14.5	17+99.5 TAP		20136		12209 Nantucket		2-19-88	
18+00	158.2	149.29	8.9									
19+00	160.4	149.69	10.7		19+29.8 TAP		26408	2315	12205 Nantucket	12202 Nantucket	10-29-90	5-20-89
20+00	163.0	150.09	12.9		20+43.4 TAP	20+43.8 TAP	12653	17163	12201 Nantucket	12200 W Nantucket	7-8-87	10-21-86
	163.2	150.10	13.1									
		150.20	13.0	20+04.8								
21+00	163.4	150.59	12.8		21+14.8 TAP		18394		12113 Nantucket		5-21-87	
22+00	163.8	150.99	12.8		22+01.4 TAP	22+30.7 TAP	18382	23415	12109 Nantucket	12206 Nantucket	5-20-87	6-22-89
	165.0	151.38	13.6		22+59.4 TAP		18285		12105 Nantucket		5-21-87	
		151.48	13.5	22+98.4								
23+00	164.2	151.49	12.7			23+34.4 TAP		16502	12106 Nantucket		6-24-86	
					23+81.4 TAP		20148		12101 Nantucket		2-19-88	
24+00	164.8	151.89	12.9									
25+00	165.5	152.29	13.2		24+97.7 TAP		19927		12033 Nantucket		1-5-88	11-12-89
	167.6	152.64	15.0	25+88.7	25+91.7 TAP	25+19.7 TAP	24222	24275	12029 Nantucket	12112 Nantucket	11-01-89	11-13-89
					25+82.7 TAP	4" STUB S	15872		12102 Nantucket		3-17-86	
LATERAL LINE 2	154.8	146.93	7.9	0+00 LIFT STA								
1+00	153.4	147.33	6.1		4" SDR 35 1+03		93-27403-7		12221 W Nantucket		10-15-93	
2+00	154.4	147.73	6.7		4" SDR 35 1+45.8 tap		2000-01782- 22-3568-7		12205 W Nantucket	See Below	8-7-80	3-12-92
	156.4	148.00	8.4	2+43.4								

H290 A