



Autumn Ridge Add  
 Lots 7-14 Require  
 IN Lieu Fees Permit to  
 issuing Sewer Permit  
 PR ENG. Dept  
 5-7-87 BF

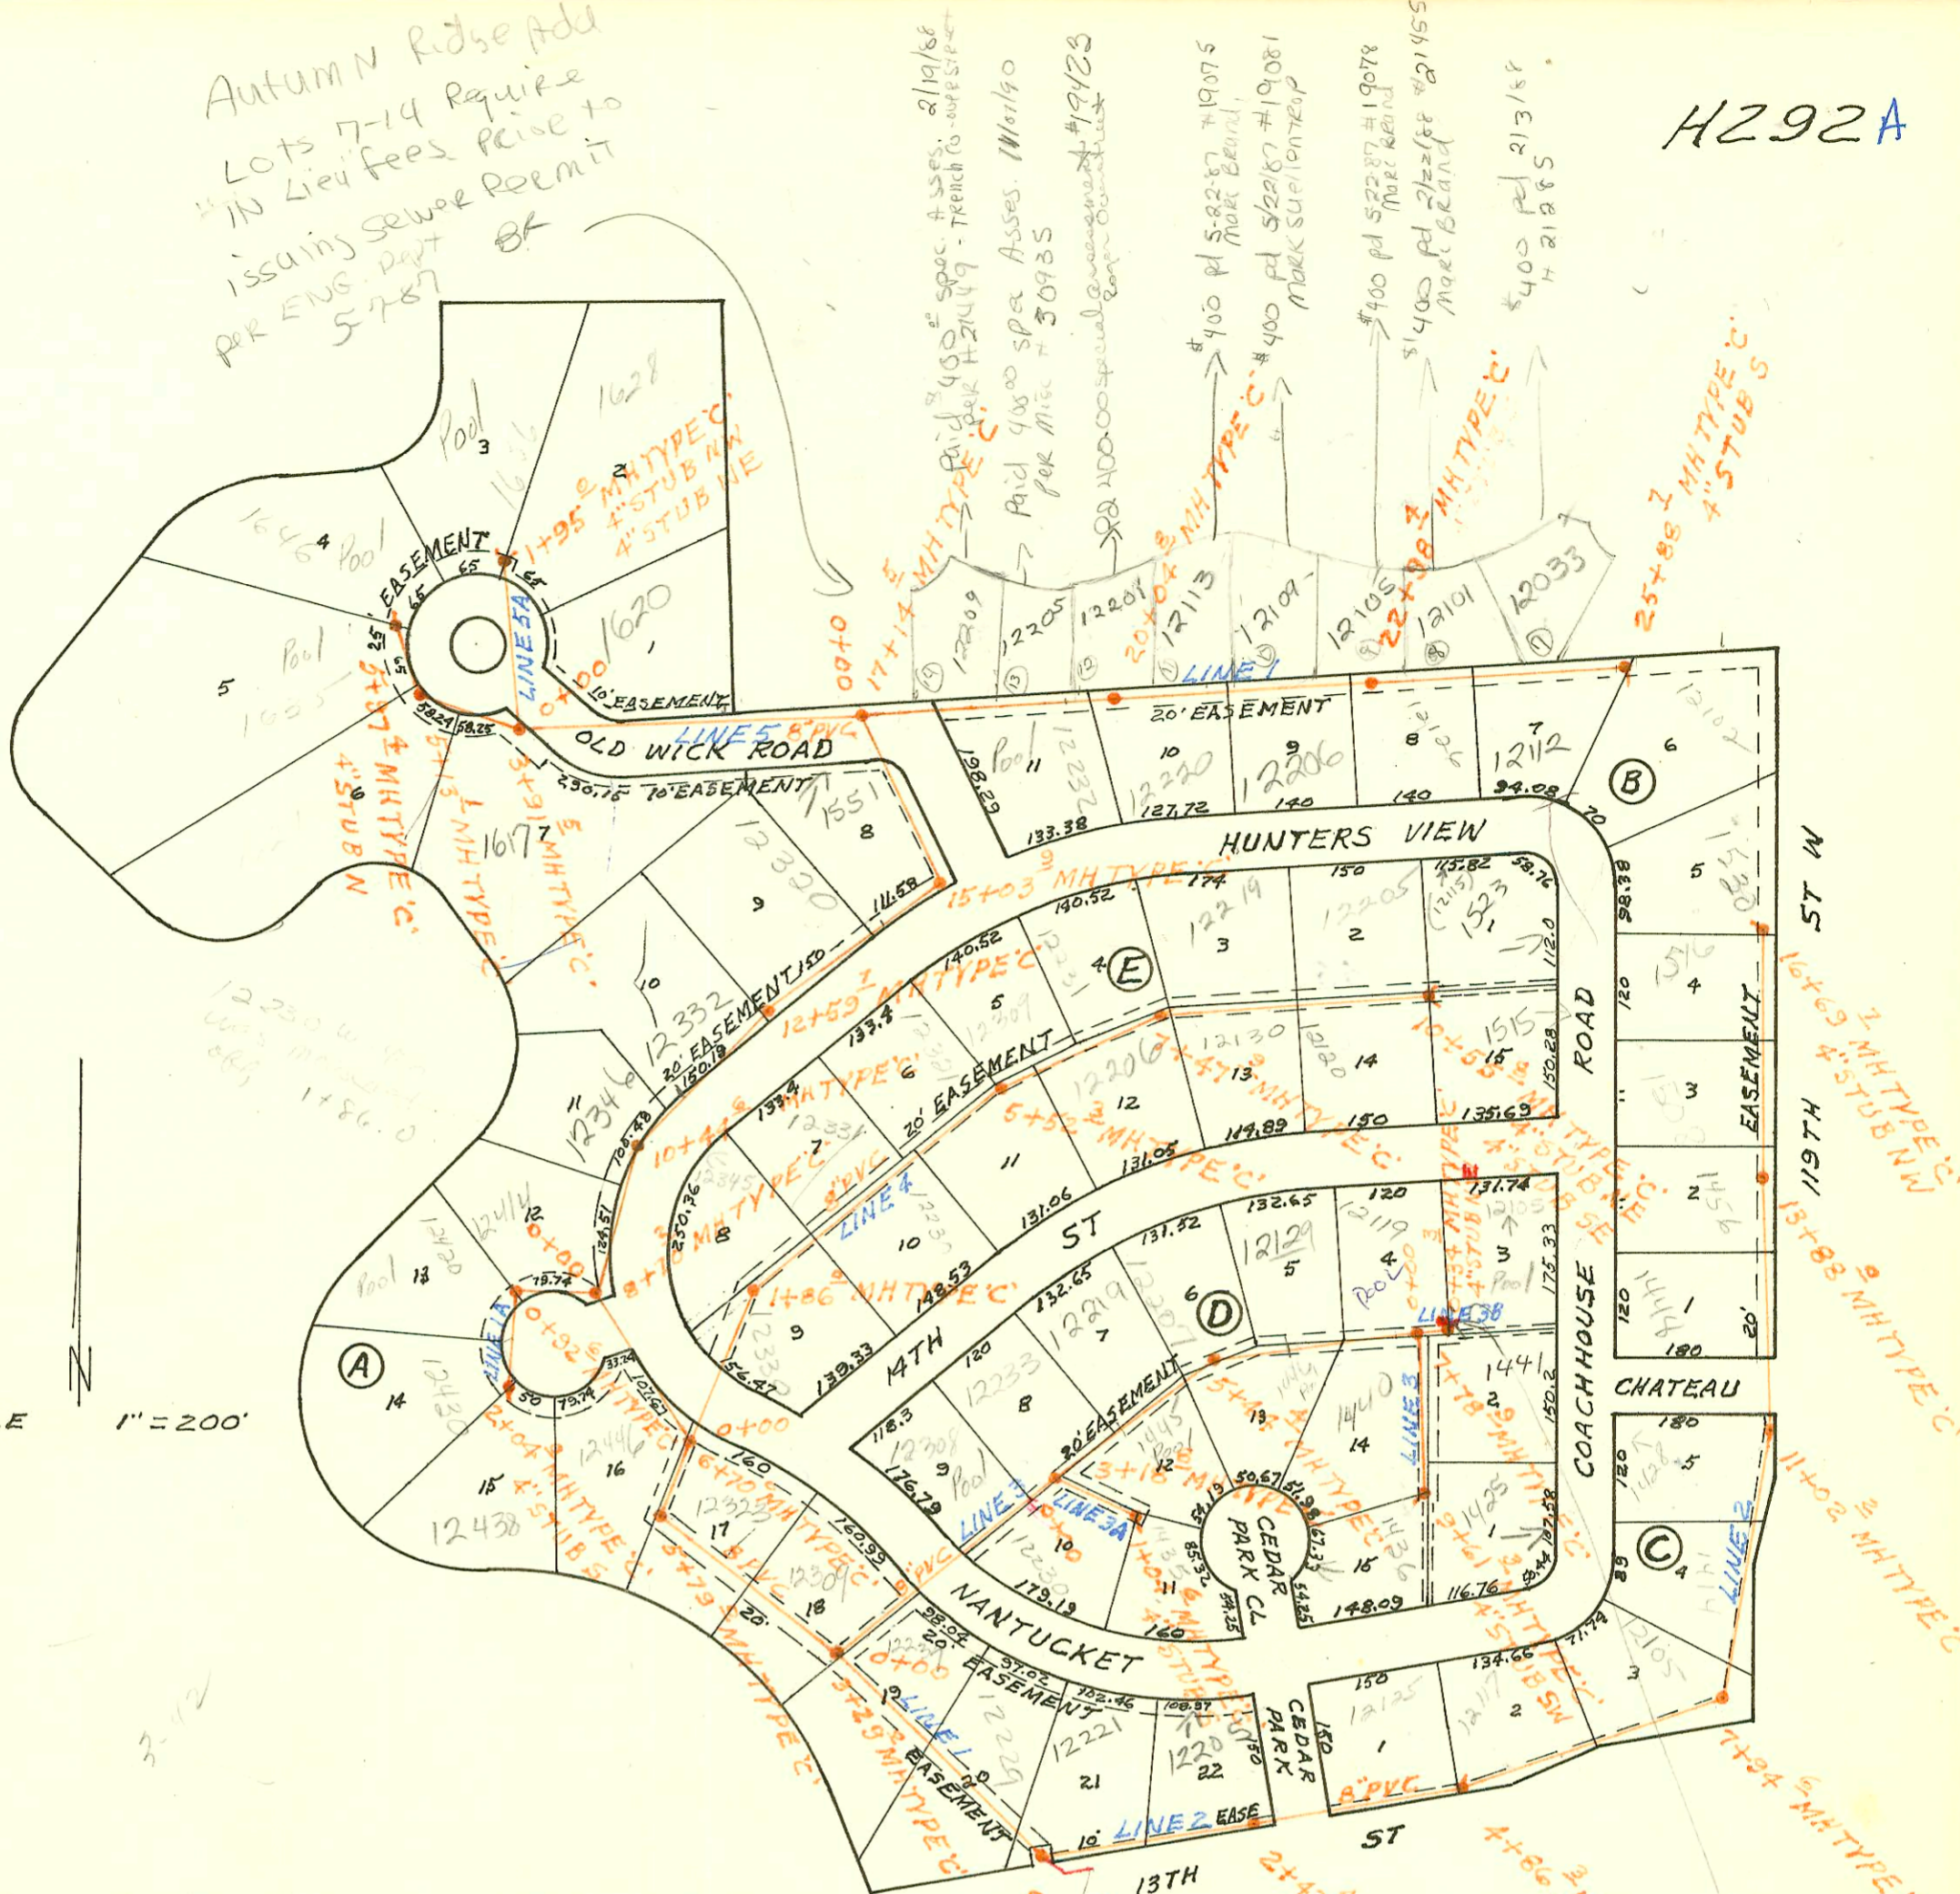





LATERAL 162 SOUTHWEST INTERCEPTOR  
 LIFT STATION & FORCE MAIN  
 BUILT BY: UTILITY CONTR. INC.  
 PROJ. No 468-76-245-81044-000-000-001  
 BOOKED 6-28-82 FROM SRL3

on map w-112

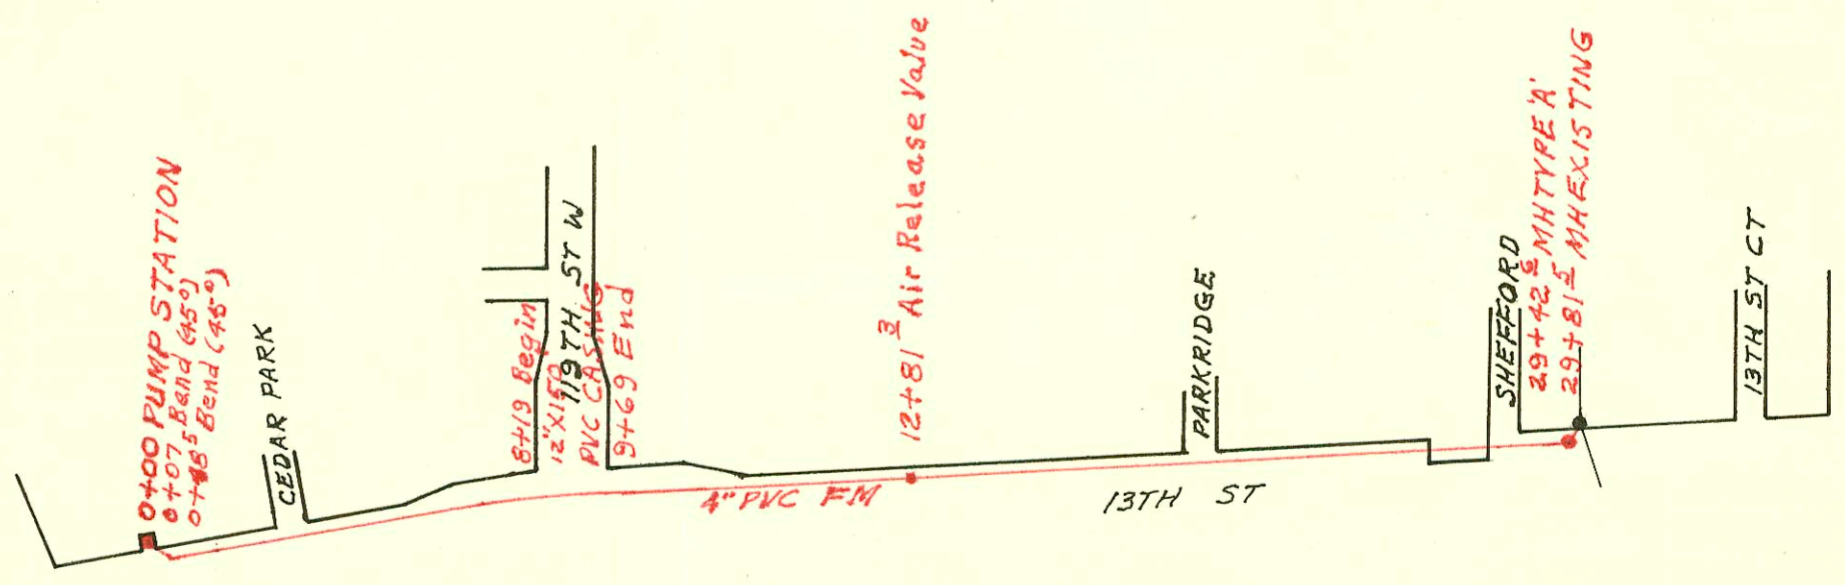





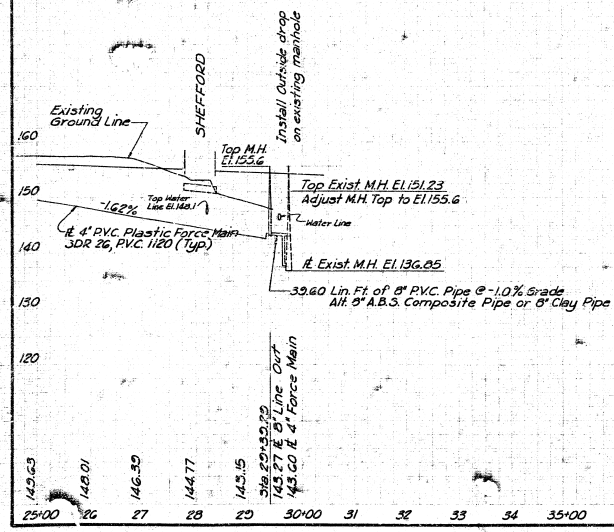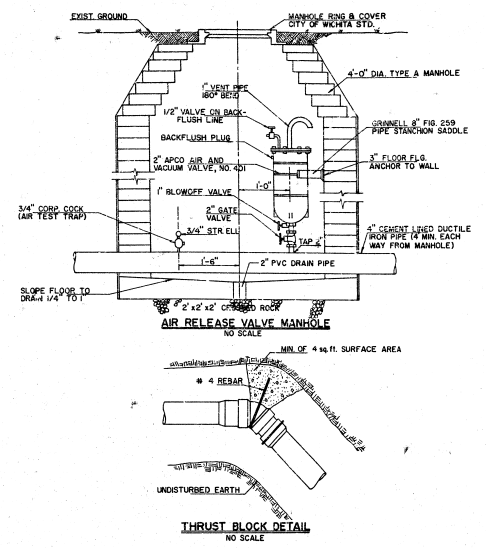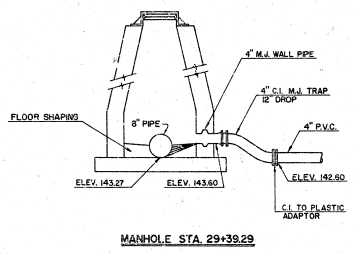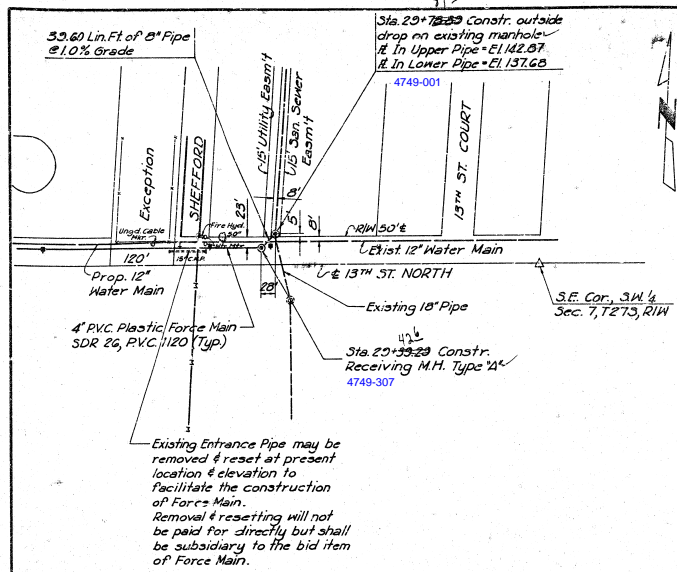

2-11-01

**LATERAL 162, SW. I.**

TEMP. LIFT STA. & FORCE MAIN

PROJ. NO. 468-76-245-81044-000-000-001

11/13

FORCE MAIN