


SAN SEWER FOR PEPSI COLA BOTTLING CO.  
 BUILT BY: UTILITY CONTR. INC.  
 PROJ. No 468-76-245-80000-000-008  
 BOOKED 7-16-82 FROM DCD 36

*on map*

H295A

SCALE 1" = 150'

*Private Line*

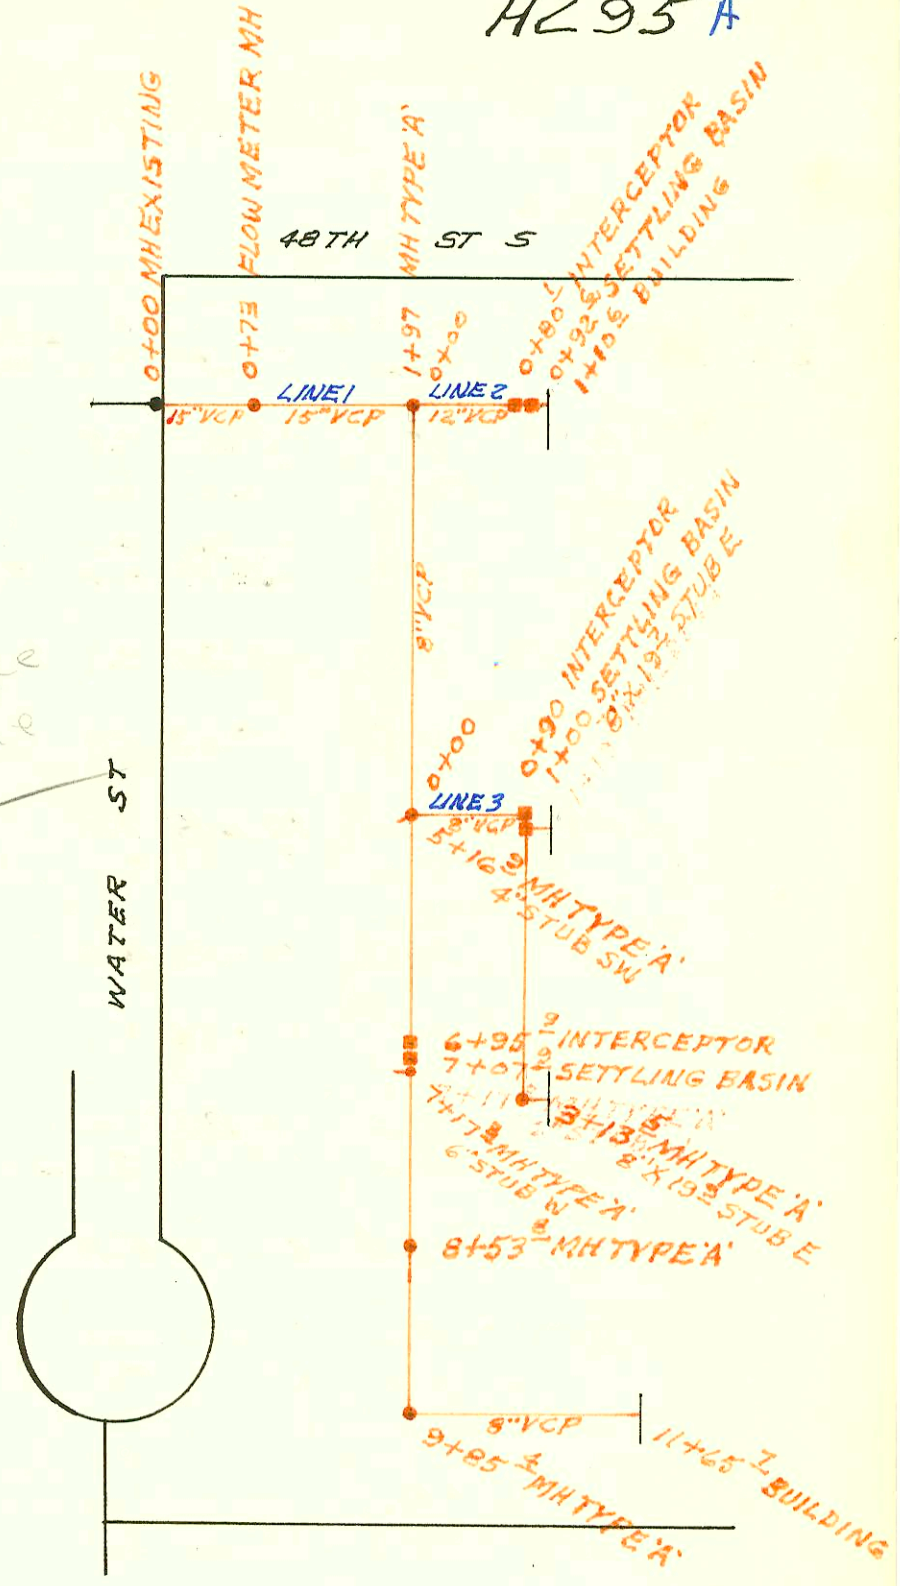

H295

CONSTRUCTION RECORD							SERVICE RECORD						
STATION	ELEVATION		Depth	MANHOLE	4-INCH "Y" BRANCHES		No. of Permit		House Number		DATE OF PERMITS		
	Ground	Grade			North West	South East	North West	South East	North West	South East	North West	South East	
LAT LINE 3	66 W 15 (CONT'D)												
0+00	182.8	172.94	9.9	0+00=4+90.5 LINE 5									
1+00	182.7	173.34	9.4										
	183.1	173.36	9.7	1+05.4									
		173.46	9.6										
	184.0	173.97	10.0	1+81.8									
		174.07	9.9										
2+00	184.0	174.83	9.7										
3+00	184.8	175.73	9.1										
4+00	186.7	177.44	9.6										
	187.6	177.46	10.1	4+23.0									
5+00	188.5	178.23	10.3										
6+00	191.0	179.24	11.8										
7+00	193.8	180.24	13.6										
	196.1	180.75	15.4	7+49.0									
8+00	195.4	181.00	14.4										
9+00	195.0	181.53	13.5										
	195.5	181.73	13.8	9+38.0									
LINE 4	0+00	196.1	182.75	13.4	0+00=7+49.0 LINE 3								
		197.4	183.73	13.7	0+64.7								
LINE 5	0+00	176.0	166.96	9.0	0+00=2+02 LINE 1								
		177.4	167.33	10.1	0+95.8								
1+00	177.5	167.37	10.1										
2+00	178.9	168.26	10.3										
3+00	179.6	169.15	9.6										
4+00	180.7	170.04	9.8										
	182.8	170.84	12.0	4+90.5									
5+00	182.6	170.88	11.7										
6+00	184.2	171.27	12.9										
7+00	185.6	171.66	13.9										
8+00	186.8	172.05	14.8										
	187.9	172.26	15.6	8+54.7									
9+00	187.4	172.50	14.9										
10+00	186.9	173.02	13.9										
	187.3	173.42	13.9	10+77.1									
11+00	186.4	173.51	12.9										
	187.7	173.66	14.0	11+39.3									
12+00	186.7	173.90	12.8										
13+00	188.0	174.29	13.7										
14+00	189.2	174.67	14.5										
	190.0	174.88	15.1	14+52.7									
15+31	189.9	175.18	14.7	END LINE									

620 596  
↑  
TV  
609  
100'



TV  
6093  
Riser

322

252

184

116

131

976

Riser

9-14-83

5-18-83

9-14-83

3-10-83

4-14-83

4-14-83

