


LAT. 18, SUB. 13, S.S. 22  
 UTILITY CONTRACTORS, INC. 2-5-64  
 PROJ. NO. C23-113 K-74 BOOKED 2-13-64

Working Manhole Proj.  
 0+00 Lat. 18, Sub 13, S.S. 22  
 5+90.6 DIA

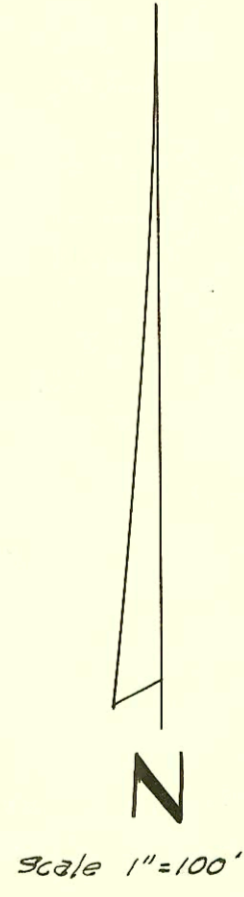

LAT. 6 SUB. 13 S.S. 22  
 DEVELOPMENT, INC. OCT. 23 1956  
 BK NO. K-33 PROJECT # C26-73

CONSTRUCTION RECORD

SERVICE RECORD

STATION	ELEVATION		Depth	MANHOLE	4-INCH "Y" BRANCHES		No. of Permit		House Number		DATE OF PERMITS	
	Ground	Grade			North West	South East	North West	South East	North West	South East	North West	South East
16+00	126.6	120.0	6.6			+83 <sup>3</sup>						
	127.2	120.3	6.9	16+61°						3202 W. 13th		
		120.2	7.0							1413 N. Mt. Carmel		6-10-60
17+00	128.1	120.3	7.8			16+62 <sup>3</sup>		12929				
										3202 W. 13th		
										1413 N. Mt. Carmel		6-10-60
18+00						17+50 <sup>5</sup>		12928				
						+78°						
Line 1A 0+00	127.3	120.6	6.7	18+06°	2" stub S.E.			7864		1800 W. 13th		8-29-56
	126.9	120.2	6.7	Existing man								
1+00	126.8	120.6	6.2									
	126.6	120.2	5.9	1+12 <sup>5</sup>								
			6.0									
						+31 <sup>4</sup>		3623		1400 Seward		1-29-57
2+00	125.9	121.0	4.9									
						2+25 <sup>5</sup>		8303	11468	3250 W. 13th	3240 W. 13th	10-3-58 9-29-59
Line 1B 0+00	126.4	121.1	5.3	2+56 <sup>8</sup>								
	127.0	120.7	6.3	Existing man								
						+16 <sup>8</sup>						
						+74 <sup>8</sup>		13305		1400 W. Seward		9-6-60
	126.3	121.0	5.3	0+90 <sup>5</sup>								

256.8  
2+42.5  
14.3

LAT. 6 SUB. 13 S.S. 22

STATION	Ground	Grade	Depth	MANHOLE	4-INCH "Y" BRANCHES	No. of Permit	House Number	DATE OF PERMITS
0+00	118.6	113.5	5.1		Y WEST Y EAST			
					+64° +60°	10145	1607 N. Charles	4-21-59
1+00	120.9	113.7	7.2					
					+62 <sup>5</sup> +60 <sup>5</sup>	82950	1600 W. Charles	11-1-56
2+00	120.7	113.9	6.8					
					+22 <sup>7</sup> +20 <sup>7</sup>	13884	1616 N. Charles	2-23-61
3+00	120.0	114.1	5.9					
				3+01°				
					+46 <sup>4</sup> +44 <sup>4</sup>	3270	1624 N. Charles	12-5-56
4+00	120.8	114.3	6.5					
					+14 <sup>7</sup> +12 <sup>7</sup>	863048	1630 N. Charles	9-22-77
5+00	121.2	114.5	6.7		+18.2	663169	1630 N. Charles	11-8-56
					+22 <sup>7</sup> +20 <sup>7</sup>	37741	1630 N. Charles	9-22-77
						3907	1640 N. Charles	10-21-58
	120.9	114.7	6.2	5+90 <sup>6</sup>	8" v.c.p. North			2-21-57

LAT. 18. SUB. 13, S.S. 22

STATION	Ground	Grade	Depth	MANHOLE	4-INCH "Y" BRANCHES	No. of Permit	House Number	DATE OF PERMITS
0+00	121.5	114.53	7.0	Exist. 0+00°				
					0+14°	B710	1648 N. Charles	2-17-64
1+00	121.3	114.73	6.6					
					1+12°	B873	1658 N. Charles	2-14-64
2+00	121.2	114.93	6.3					
					2+09°	B1543	1668 N. Charles	6-19-64
	122.0	115.13	6.9	2+98 <sup>3</sup>				
3+00	122.0	115.13	6.9					
					3+05°	B1544	1678 N. Charles	6-19-64
					3+84°	B2186	1702 N. Charles	10-22-64
4+00	122.0	115.33	6.7					
					4+71°	C3260	1712 N. Charles	5-24-67
5+00	122.1	115.53	6.2					
					5+62 <sup>5</sup>	B3615	1722 N. Charles	9-8-66
	121.9	115.70	6.2	5+84°				

6-5-79 C72203-3200 W. 13th - New Conn (16+45)

932485-7 11-17-93 3246 W. 13th