


Church area in Red

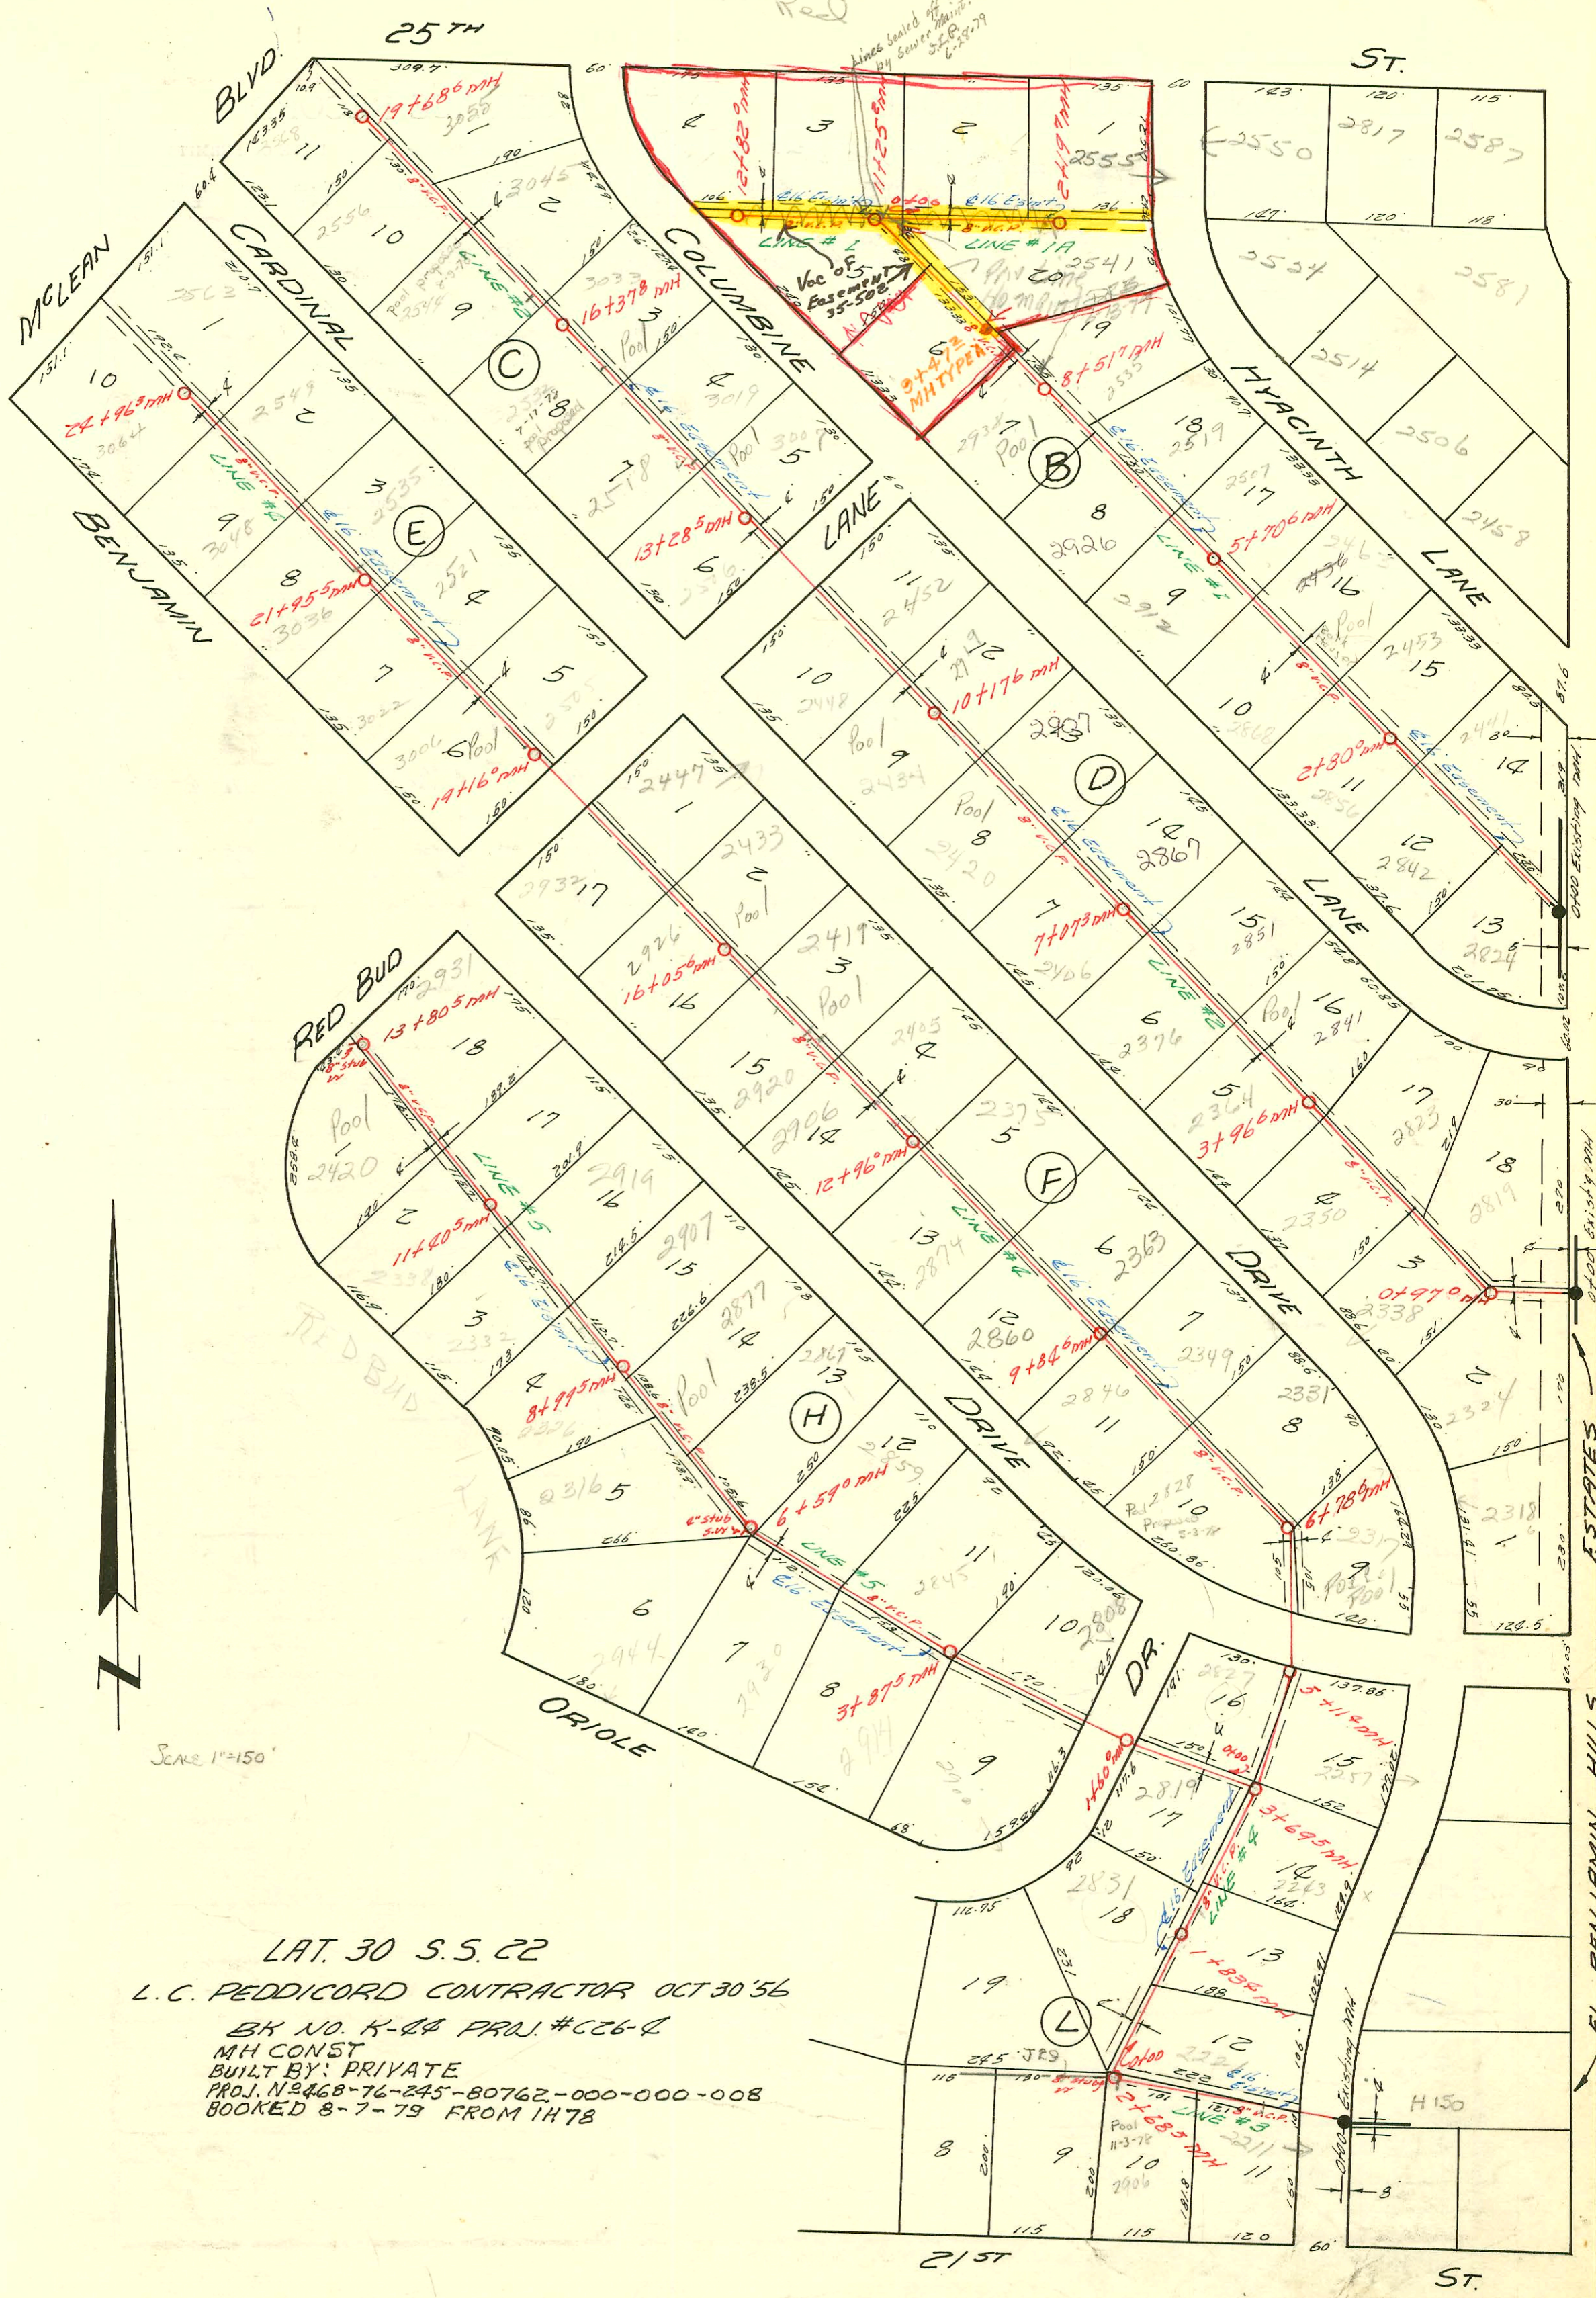

Scale 1"=150'

LAT. 30 S. 5. 22

L.C. PEDDICORD CONTRACTOR OCT 30 '56

BK NO. K-44 PROJ. #C26-Q
 MH CONST
 BUILT BY: PRIVATE
 PROJ. N2468-76-245-80762-000-000-008
 BOOKED 8-7-79 FROM 1H78

EL. BENJAMIN HILLS ESTATES

CONSTRUCTION RECORD

SERVICE RECORD

cont
LINE #2

LINE #3

LINE #4

STATION	ELEVATION		Depth	MANHOLE	4-INCH "Y" BRANCHES		No. of Permit		House Number		DATE OF PERMITS	
	Ground	Grade			North West	South East	North West	South East	North West	South East	North West	South East
17+00	127.7	122.5	5.2		16+86.1 +036		C55035	4219	2544 Cardinal	3045 Columbia	4-29-76	7-1-57
18+00	127.9	122.7	5.2		Tap 17+97.9 +335	18+91.6 +832	C55816		2556 Cardinal	3055 Columbia	6-9-76	6-8-77
19+00	128.5	122.9	5.6		Tap 19+19.1 +542		56357		2568 Cardinal		7-2-76	
0+00	128.3	123.0	5.3	19+686 EXISTING MANHOLE	Y North	Y South +964		049557		2211 Cardinal Dr		5-20-75
1+00	129.4	117.9	11.5		+662							
2+00	128.9	118.1	10.8			2+61.2 +016		C61016		2906 W 21st St.		5-4-77
0+00	129.1	118.2	10.9	2+685 EXISTING MANHOLE	8" stub w.	Y WEST	Y EAST					
1+00	129.1	118.5	10.6		Tap 1+00.9 +198	+454		4336		2281 Cardinal		4-16-56
1+00	129.0	118.7	10.3		1+834	+877		C35811		2831 Oriole		11-6-72
2+00	131.1	118.9	12.2		+612	+837		#2976		2001 Cardinal Dr.		11-6-56
3+00	130.5	119.1	11.4					B6160		2243 Cardinal Dr.		8-10-66
4+00	129.0	119.2	9.8	3+695	+271	+250		B-1057		2257 Cardinal		7-8-65
5+00	126.7	119.5	7.2									
6+00	126.1	119.5	6.6	5+114								
6+00	125.8	119.7	6.1			+147		C40459		2317 Cardinal		8-8-73
7+00	125.7	119.9	5.8	6+786								
7+00	125.4	119.9	5.5		+276	+256		56556 C50263	2128 Benjamin	2331 Cardinal Dr.	7-2-76	7-9-75
8+00	126.0	120.1	5.9		+797	+777		C36072	2846 Benjamin Ct.	2349 Cardinal	11-22-72	
9+00	126.0	120.3	5.7		9+216			C6112				12-12-67
10+00	126.0	120.5	5.5	9+346								
11+00	126.0	120.5	5.5		Tap 10+87.0 +105	+085		C39775	2860 Benjamin	2368 Cardinal Dr.	6-28-73	9-12-74
12+00	126.2	120.7	5.5		+595	Tap 11+41.5 +575		C49677		2375 Cardinal		5-29-75
12+00	126.6	120.9	5.7									
13+00	126.6	121.1	5.5	12+960								
14+00	126.7	121.3	5.4		13+054	13+054		C42606	2906 Benjamin	2405 Cardinal	12-6-73	10-8-74
15+00	126.3	121.5	4.8		Tap 15+15.6 +642	14+602		C43549	2178 Benjamin	2419 Cardinal	10-18-88	10-18-88
16+00	127.0	121.7	5.3		15+895	+875		C39777	2904 Benjamin	2433 Cardinal	7-11-73	5-30-85
17+00	127.0	121.9	5.1	16+056								
18+00	127.7	122.1	5.6		Tap 17+61.0 +289	+267		C50384		2449 N. Cardinal Dr.		7-17-75
19+00	127.5	122.3	5.2		Tap 18+03.2			047252	2932 Benjamin		11-1-74	
20+00	127.5	122.5	5.0		19+300	+300		C51913	3000 Benjamin	2537 Cardinal	9-28-76	9-23-75
21+00	127.6	122.7	4.9		20+35.5	+783		C73644	3022 Benjamin		8-15-79	
22+00	127.8	122.9	4.9	21+955				C50477		2527 Cardinal		1-29-76
23+00	127.4	123.1	4.3		+160	22+03.5 +14		C51703	3036 Benjamin	2535 Cardinal	10-6-75	4-29-76
24+00	128.0	123.3	4.7		+540	+550		C51704	3048 Benjamin	2549 Cardinal	10-6-75	4-5-76
25+00	128.7	123.5	5.2	24+963	+895	+875		2995 #15610	3062 Benjamin	2568 Cardinal	11-8-56	5-10-62

14648 - 2874 Benjamin Dr. - Catha City Bldg - 10-2-61 - Tap 11+93.0



✓