


McEwen 5th Add

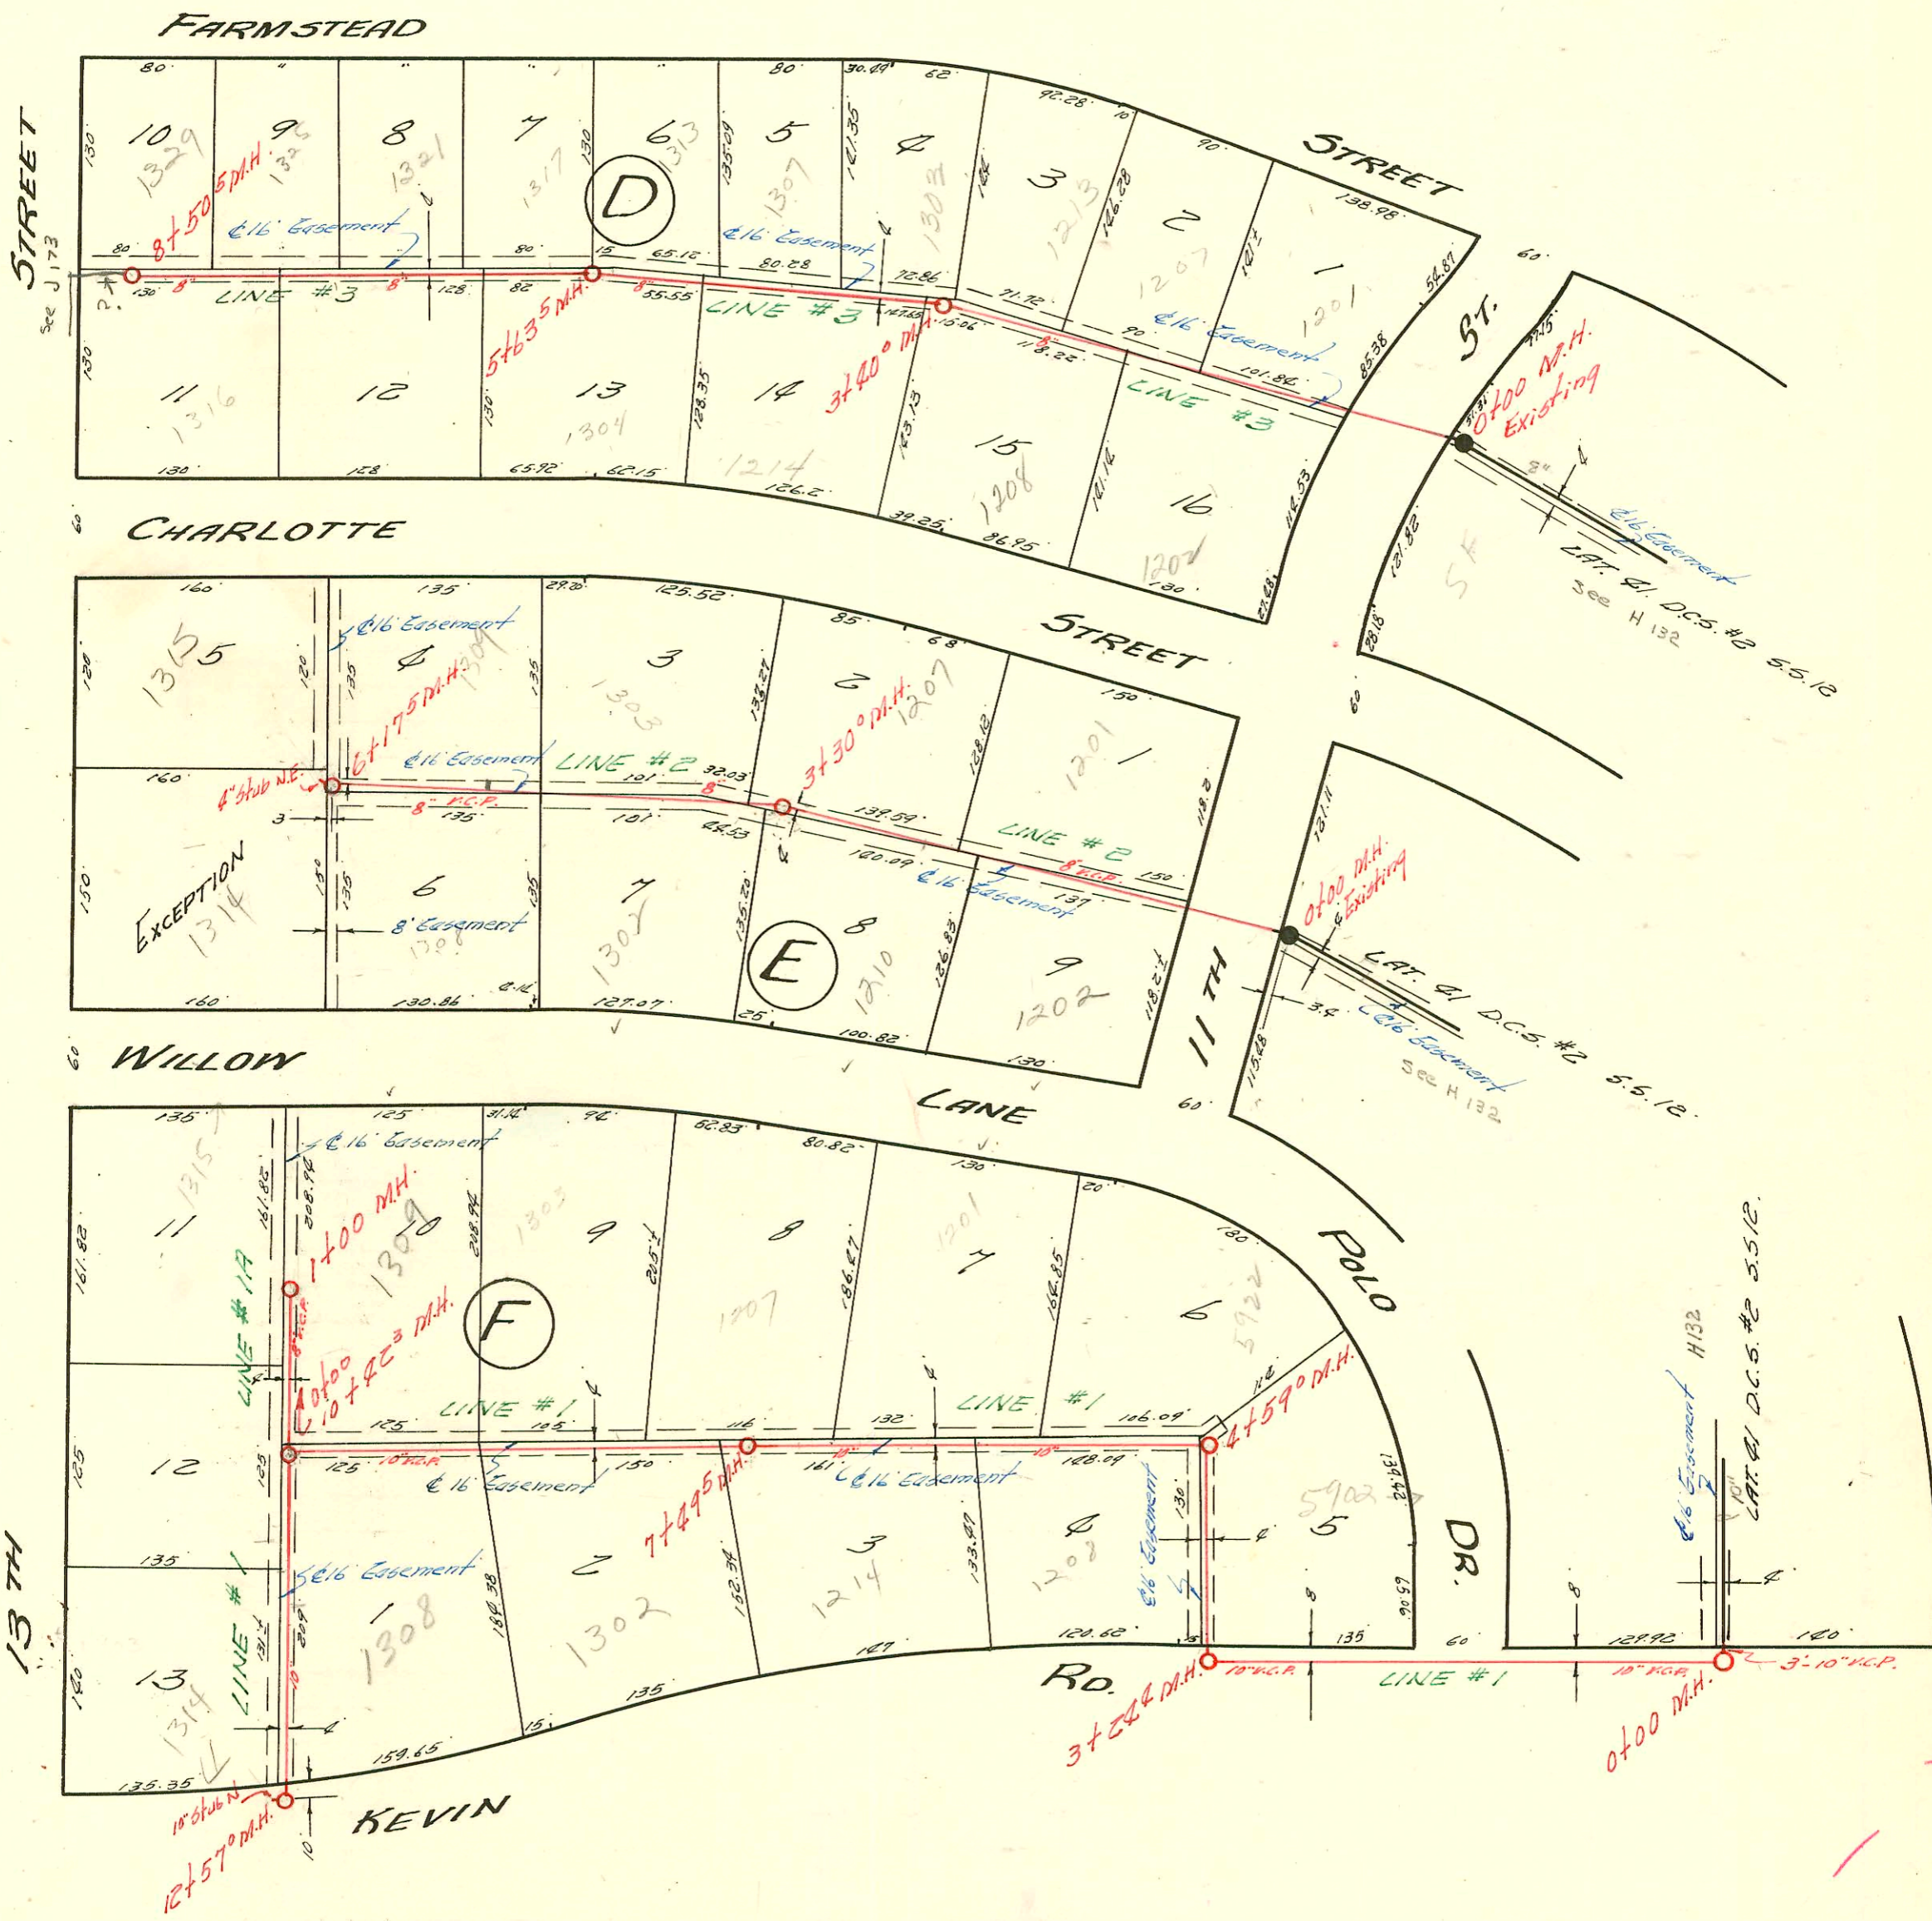

- 6720 Tap 1302 Kevin Get Pity 4-23-51 - (Tap 1+27.5)
- 7377 Tap 1314 Kevin De McDonald 7-28-51
- 7478 Tap 1208 Kevin Betty Clark 7-29-51
- 7835 Tap 1315 Charlotte Reynolds 8-25-58 Lane 2 61075
- 8371 Tap 1201 Charlotte - Reynolds 10-16-58, 1480
- 8996 Tap 1201 Willow Reynolds 2-12-59 6+140 - (Rich Blaney)
- 13483 Tap 1302 Willow Lane - Vernon Dippold 10-31-60 (3+68)
- 15838 Tap - 5909 E. 12th - Donaghue & Son - 7-3-62 (0+10 Lane 1A)
- 17159 Tap - 1303 Charlotte - Chippie Gilbo 5-22-63 (3+81)
- 22513 Tap - 1305 Willow Lane - Daniel Williams 12-10-64 (5+70.5)
- 2000-00940 - 1314 N Willow Lane - Bammer P/b - 4/20/00 - Tied to Clay Tile

LAT. 49 D.C.S. #2 5.5.12
 W. B. CARTER CONSTR. CO. INC. DEC. 27 '56
 BK. NO. K-38 PROJ. NO. C 26-77

CONSTRUCTION RECORD

SERVICE RECORD

LINE #1

LINE #1A

LINE #2

LINE #3

STATION	ELEVATION		Depth	MANHOLE	4-INCH "Y" BRANCHES		No. of Permit		House Number		DATE OF PERMITS	
	Ground	Grade			North West	South East	North West	South East	North West	South East	North West	South East
0-03				10" R.C.P. starts								
0+00	197.9	190.8	7.1	0+00								
1+00	198.2	191.2	7.0									
2+00	199.1	191.6	7.5									
3+00	199.7	192.0	7.0									
	200.1	192.2 IN 192.1 OUT	7.9 8.0	3+22 ⁶								
4+00	200.8	192.5	8.3									
	201.7	192.8 IN 192.7 OUT	8.9 9.0	4+59 ⁰								
5+00	201.9	193.0	8.9		+82 ⁸	+85 ⁸						
6+00	202.5	193.4	9.1									
7+00	203.5	193.8	9.7									
	205.0	194.0	11.0	7+89 ⁵								
8+00	203.8	194.2	9.6									
9+00	205.4	194.6	10.8									
10+00	206.1	195.0	11.1									
	206.1	195.2	10.9	10+42 ³								
11+00	205.5	195.5	10.0									
12+00	204.1	195.9	8.2									
	202.6	196.2 IN 196.1 OUT	6.0 6.5	12+59 ⁰								
0+00	206.1	195.2	10.9	EXIST'G D.M.H.								
1+00	207.8	200.0	7.8	1+00 ⁰								
2+00	207.2	196.3	10.9	EXIST'G D.M.H.								
3+00	210.0	199.3	10.7									
	210.2	199.6	10.6	3+30 ⁰								
4+00	210.6	200.3	10.3									
5+00	210.0	201.3	10.7									
6+00	212.5	202.3	10.2									
	212.7	202.5	10.2	6+17 ⁵								
0+00	211.0	200.3	10.7	EXIST'G D.M.H.								
1+00	210.7	200.6	10.1									
2+00	210.8	200.8	10.0									
3+00	211.7	201.1	10.6									
	212.0	201.1	10.9	3+20 ⁰								
4+00	212.0	202.3	9.7									
5+00	212.6	202.6	10.0									
	212.3	202.7	9.6	5+63 ⁵								
6+00	212.4	202.8	9.6									
7+00	211.8	203.1	8.7									
8+00	212.1	203.3	8.8									
	212.6	203.4	9.2	8+50 ⁵								

#3437 - Tap - 5921 E. 13th - Cherry Blk. - 12-21-56
 #3930 Tap - 5902 Palo Alto - Kelly Park - 2-27-57
 #5473 Tap - 1316 - 10-18-57
 5307 Tap - 1303 Charlotte - Reynolds - 10-21-57
 5685 Tap - 1714 Charlotte - 11-7-57

4971 - Tap - 1310 Charlotte - Reynolds - 8-29-57
 #5808 Tap - 1309 Willow La. - Reynolds - 12-4-57
 6009 Tap - 1325 Farmstead - Reynolds - 1-6-58
 6069 Tap - 1307 Farmstead - Reynolds - 1-30-58
 6148 Tap - 5922 Palo Alto - Kelly Park - 1-16-58