


A petition has been issued to reroute City Main. Permission granted for temporary connection. 328 270

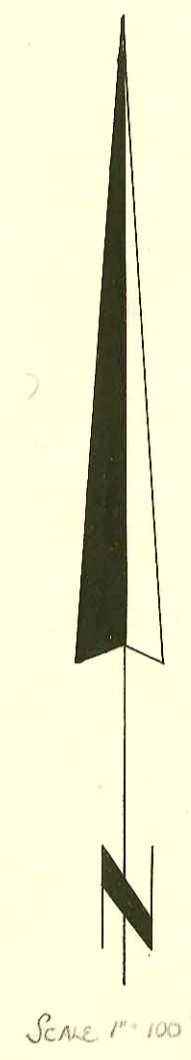

LAT. II S.S. #22
 UTILITY CONTRACTOR, INC. JAN 5 1957
 BK NO. K-26 PROJ. NO. C25-22

ALOHA MOTEL
 SAN. SEWER
 PRIVATE CONT.
 JULY 1966
 BK. K-80

TUOS

