




#5799 - Callison Plbg. 1903 E. Pawnee I 44A
 1-9-58 See I 115 for details

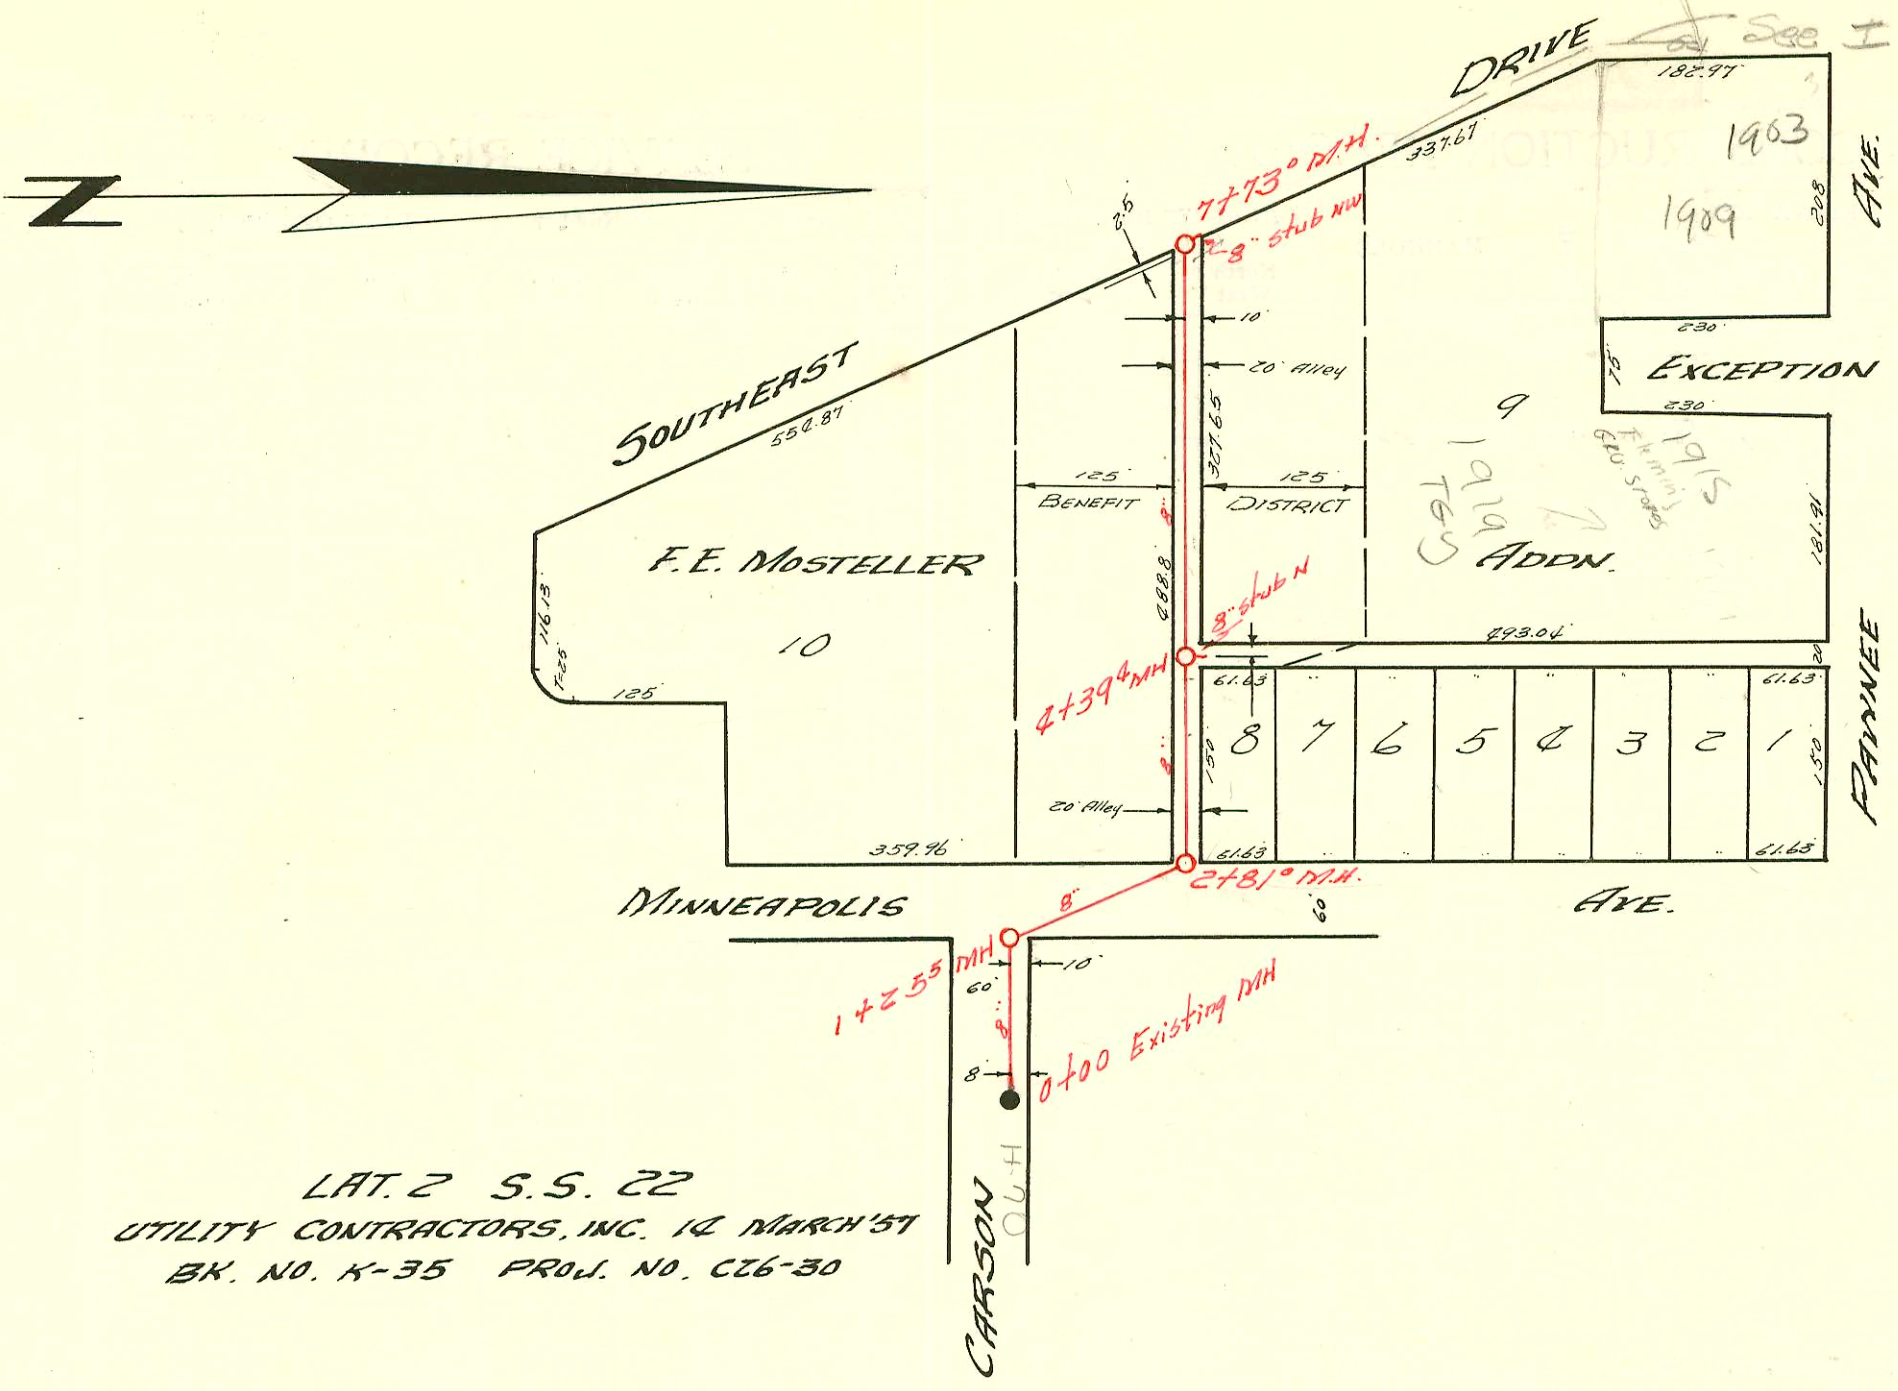

LAT. 2 S.S. 22
 UTILITY CONTRACTORS, INC. 12 MARCH '57
 BK. NO. K-35 PROJ. NO. C26-30

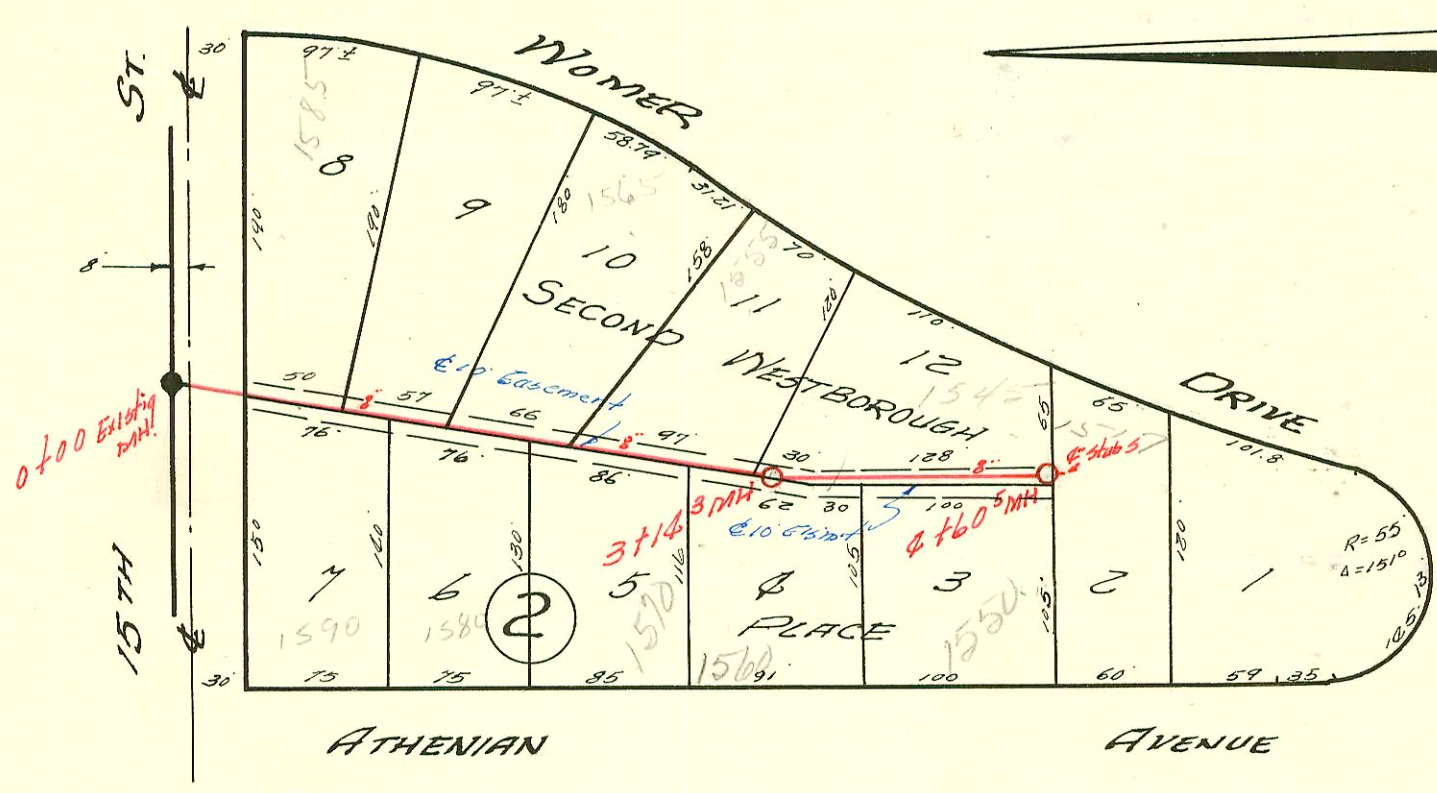

LAT. 4 SUB. 13 S.S. 22
 UTILITY CONTRACTORS INC. 12 MARCH '57
 BK. NO. K-38 PROJ. NO. C26-71

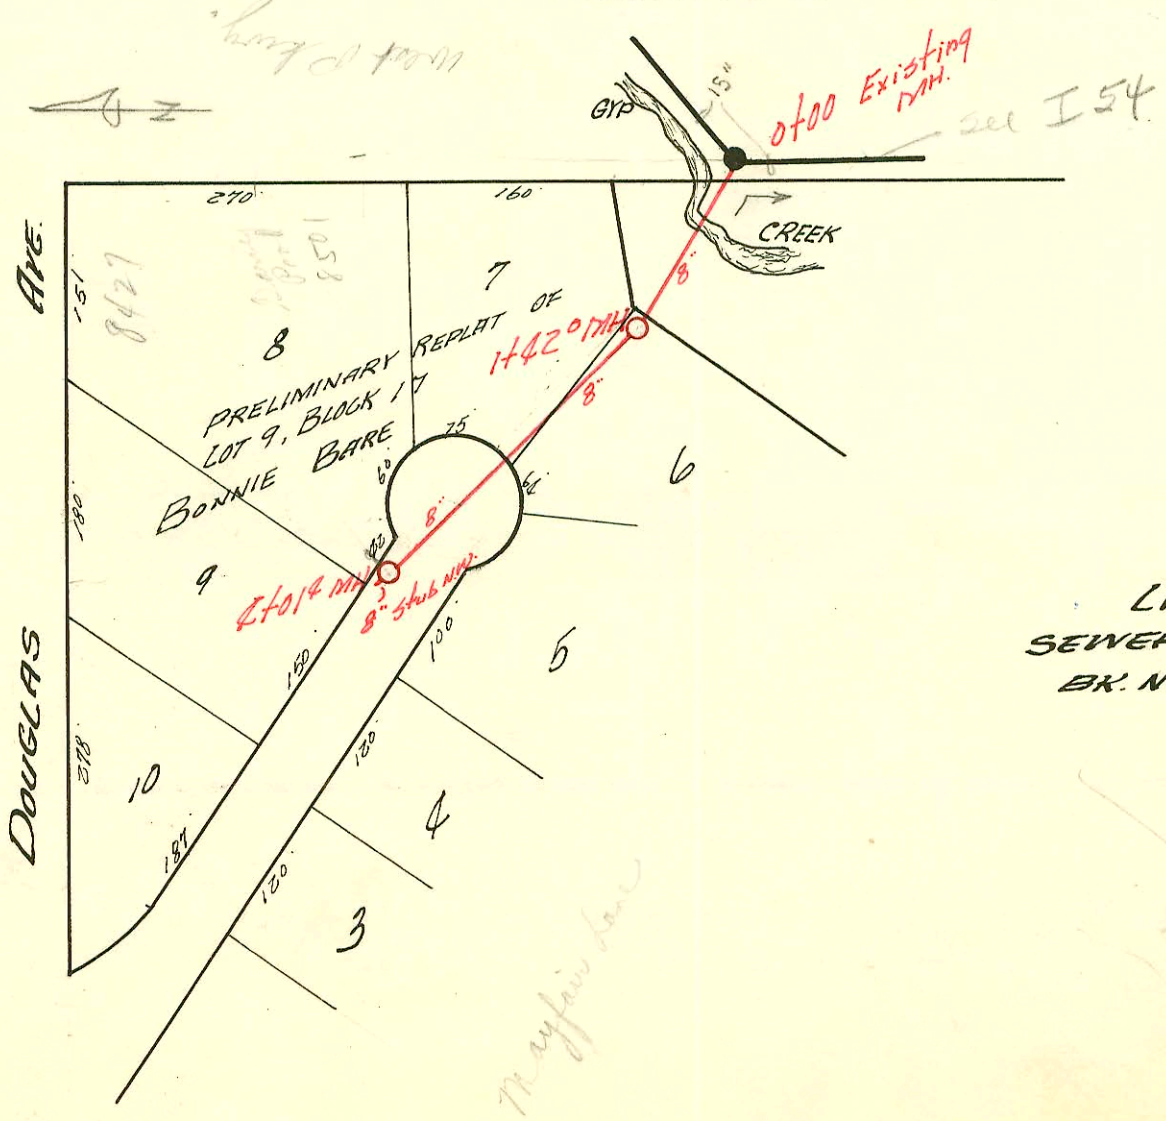

LAT. 16 W.I.S.
 SEWERS INC. 12 MARCH 1957
 BK. NO. K-22 PRIVATE JOB

