
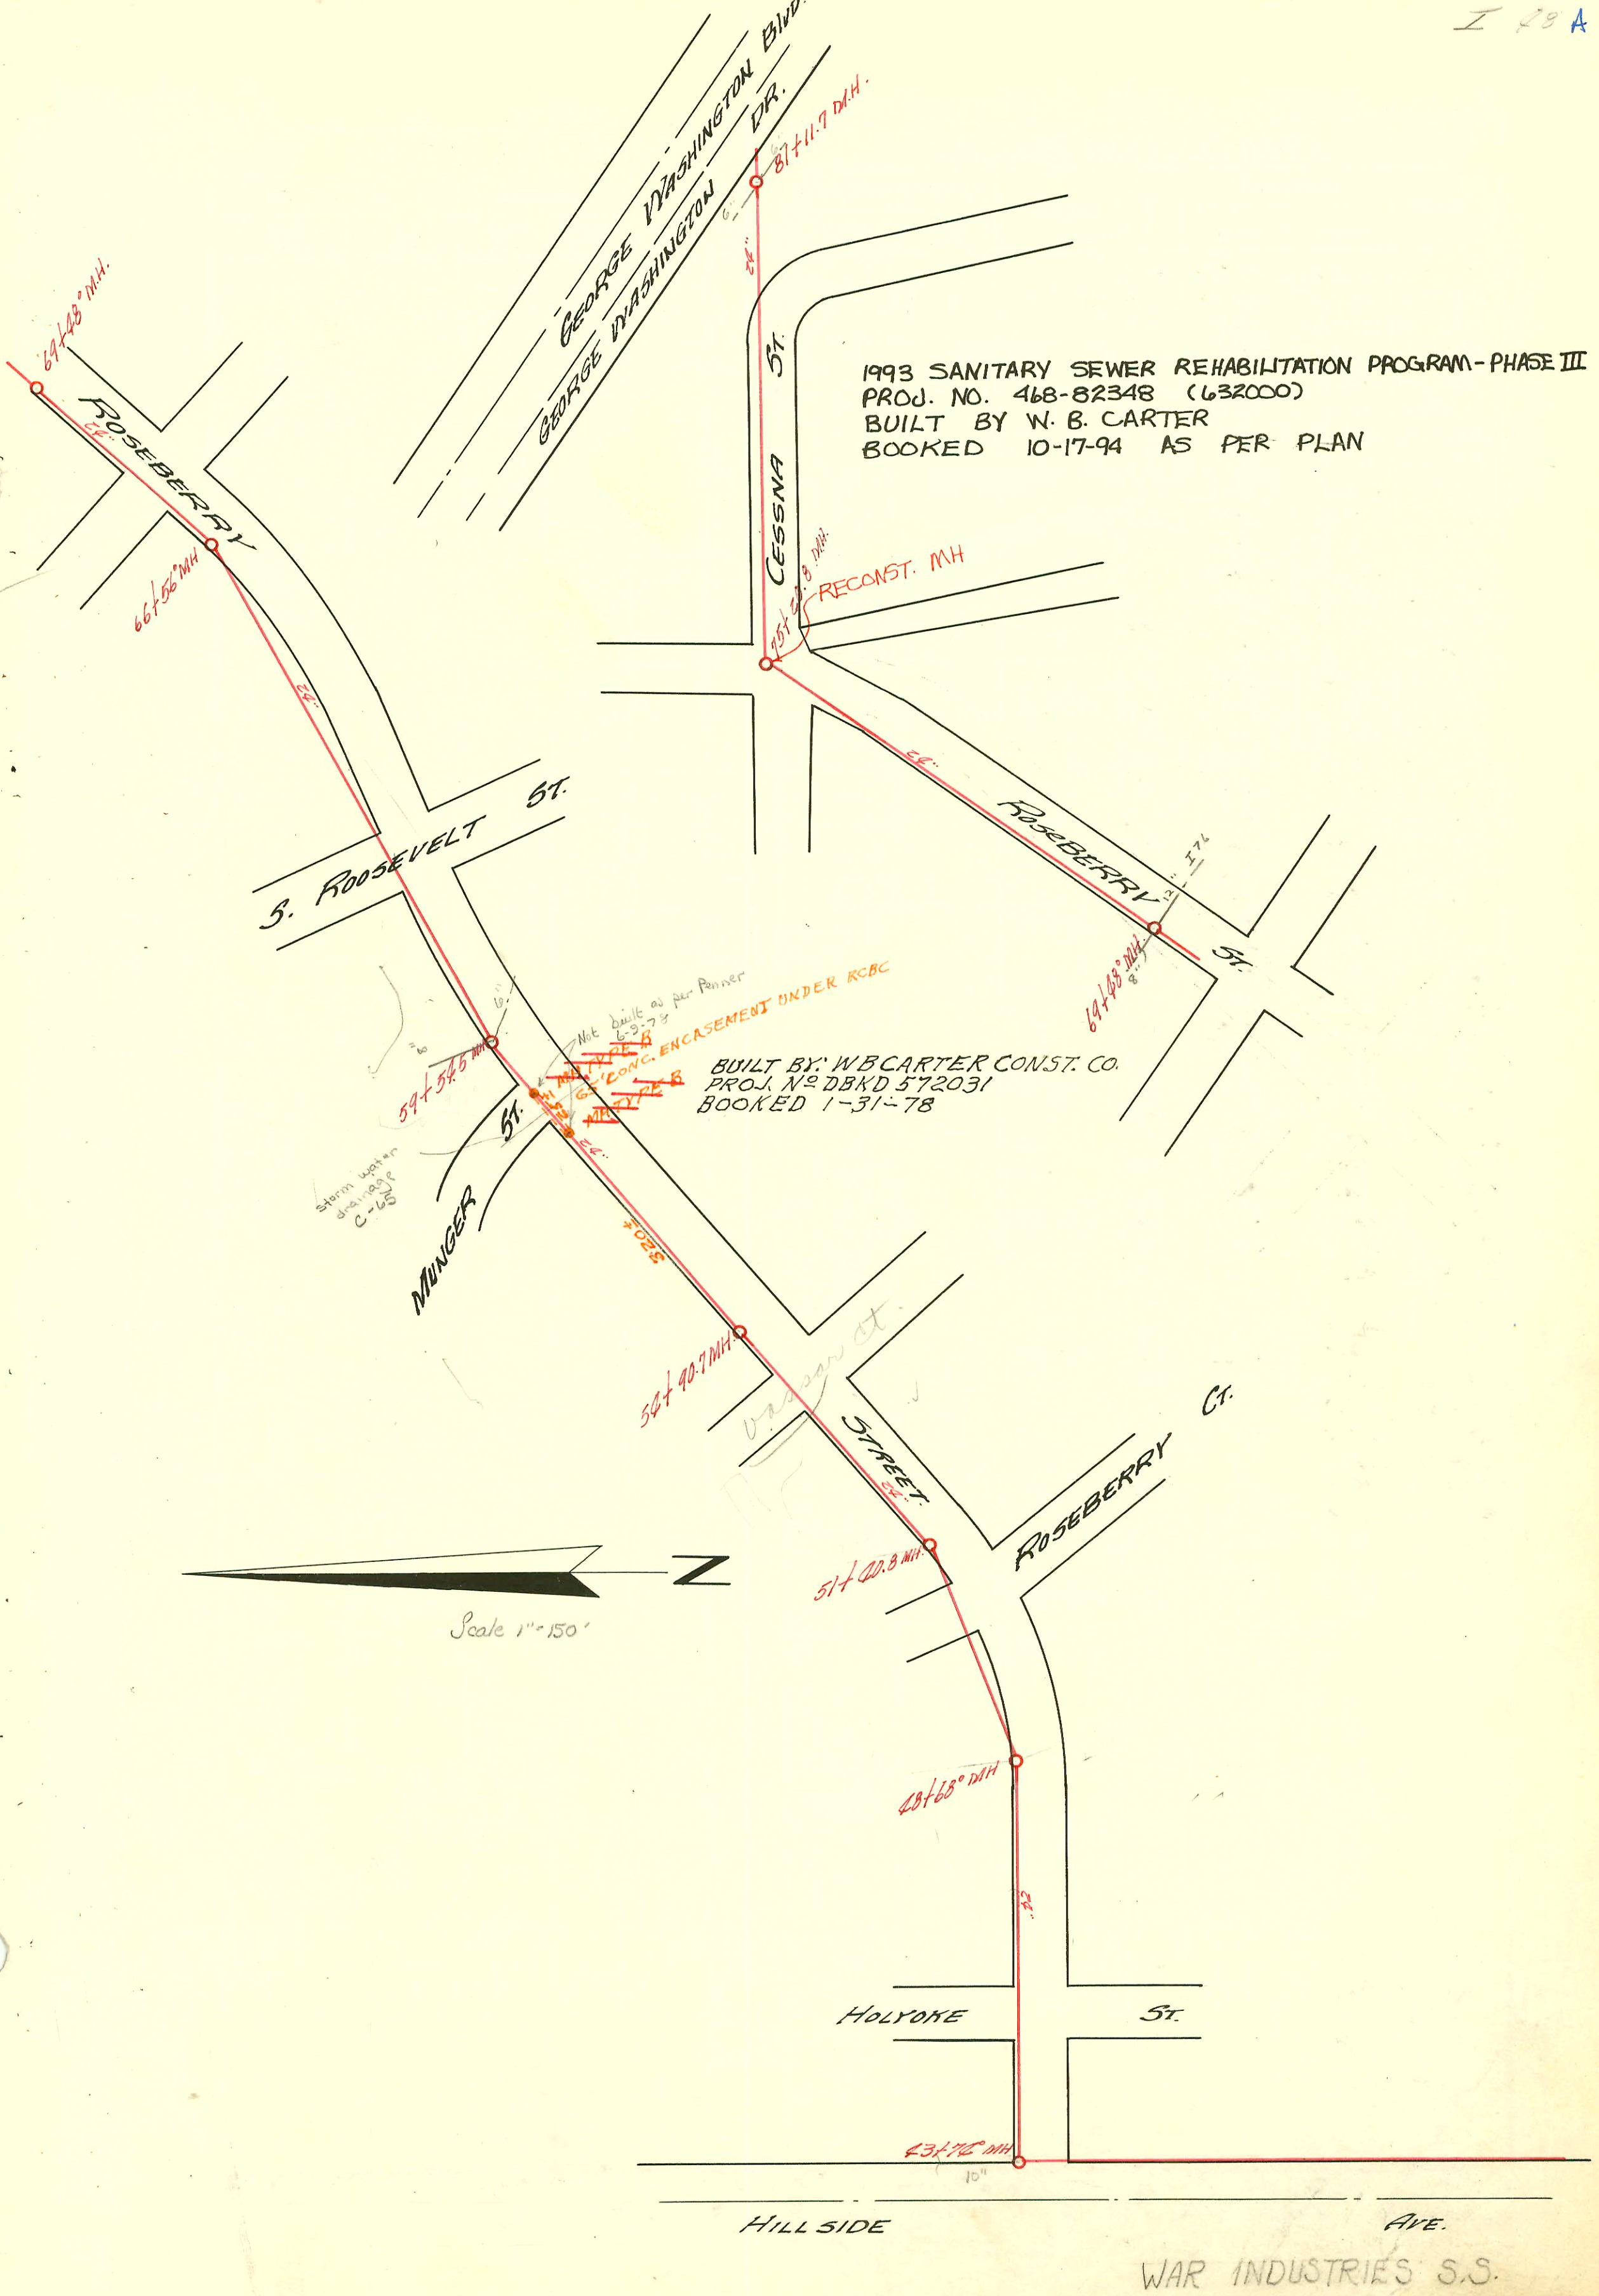


1993 SANITARY SEWER REHABILITATION PROGRAM-PHASE III  
PROJ. NO. 468-82348 (632000)  
BUILT BY W. B. CARTER  
BOOKED 10-17-94 AS PER PLAN

Not built as per Penner  
6-9-78  
TYPE B  
CONC. ENCASEMENT UNDER RCBC  
BUILT BY: WBCARTER CONST. CO.  
PROJ. N<sup>o</sup> DBKD 572031  
BOOKED 1-31-78

Storm water  
drawing  
C-65

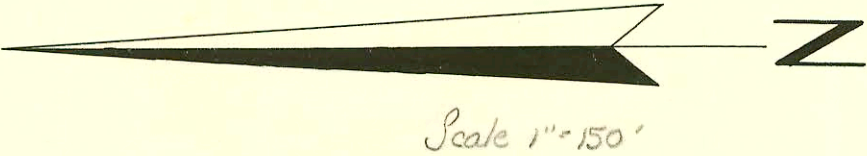

WAR INDUSTRIES S.S.

### CONSTRUCTION RECORD

### SERVICE RECORD

STATION	ELEVATION		Depth	MANHOLE	4-INCH "Y" BRANCHES		No. of Permit		House Number		DATE OF PERMITS	
	Ground	Grade			North West	South East	North West	South East	North West	South East	North West	South East
43+00	102.0	89.1	12.9									
	104.0	89.12	14.8	43+70°								
44+00	103.5	89.2	14.3									
45+00	103.9	89.3	14.6									
46+00	104.1	89.4	14.7									
47+00	105.8	89.5	16.3									
48+00	106.7	89.6	17.1									
	106.4	89.62	16.8	48+68°								
	106.4	89.72	16.7									
49+00	106.2	89.7	16.5									
50+00	106.3	89.8	16.5									
51+00	107.2	89.9	17.3									
	107.5	89.94	17.6	51+20°								
	107.5	90.00	17.8									
52+00	107.8	90.00	17.8									
53+00	108.5	90.00	18.4									
54+00	109.0	90.2	18.8									
	109.6	90.28	16.6	54+90°								
	109.6	90.35	19.2									
55+00	109.6	90.4	19.2									
56+00	110.7	90.4	20.3									
57+00	114.0	90.5	23.5									
58+00	116.4	90.6	25.8									
59+00	117.8	90.7	27.1									
	117.6	90.72	26.9	59+54°								
	117.6	90.81	26.8									
60+00	117.3	90.8	26.5									
61+00	111.7	90.9	20.8									
62+00	115.7	91.0	24.7									
63+00	114.6	91.1	23.5									
64+00	112.9	91.1	21.7									
65+00	112.0	91.2	20.8									
66+00	110.0	91.3	18.7									
	108.8	91.37	17.4	66+56°								
	108.8	91.51	17.3									
67+00	108.9	91.6	17.3									
68+00	109.5	91.7	17.8									
69+00	110.1	91.8	18.3									
	110.5	91.74	18.8	69+48°								
	110.5	91.80	18.7									
70+00	110.8	91.9	18.9									
71+00	112.5	91.9	20.6									
72+00	112.8	92.0	20.8									
73+00	112.2	92.2	20.0									
74+00	112.6	92.3	20.3									
75+00	112.6	92.4	20.2									
	112.9	92.49	20.4	75+20°								
	112.9	92.60	20.3									
76+00	113.0	92.7	20.3									
77+00	112.8	92.8	20.0									
78+00	113.6	92.9	20.7									
79+00	114.3	93.1	21.2									
80+00	114.6	93.2	21.4									
81+00	115.5	93.3	22.2									
	115.5	93.31	22.2	81+11°								
	115.5	93.52	22.0									

SO C45277 4161 Cesena Dr. 6-12-74  
 SO C45276 4157 " " " " " "  
 SO C45275 4153 " " " " " "  
 SO C45279 4065 " " " " " "  
 SO C45206 4061 " " " " 6-7-74  
 SO C45207 4156 " " " " " "  
 SO C45208 4149 Cesena Dr. - 6 " - Rutledge

\*12261 - private line com. 3573 Munger Ln - Trailer - 2-9-60 - Opmed Bldg.  
 SO C36382 - 3420-30-40 Munger Lane - Al Henning - 12-19-72  
 SO C36892 - 3401-11-31 Munger Lane - Al Henning 1-25-73  
 SO C42633 - 3562-64 Munger Lane - Al Henning 12-7-73  
 SO C42935 - 3582 " " - Al Henning 1-3-74  
 SO C43307 - 3536 " " " " 2-1-74  
 SO C43309 - 3510 " " " " 2-1-74  
 SO C58936 - 3544-48 " " " " 12-2-76