

RECON. MHS AT JUNCTURE  
 M'CONNELL AIR BASE SEWER & 24" WIS  
 BUILT BY: W.B. CARTER CONST. CO.  
 PROJ. N<sup>o</sup> 576-80-700-50380-430-000-003  
 BOOKED 10-27-79 FROM WSJ 04


\* Note 42" WIS goes through this MH, totally encased ~ 1 1/2 ft into MH & 2' from bottom.

\* NOTE: This page apparently full of discrepancies.

\* Note: Apparently turn MH placed at wrong location as per field observation

\* Note discrepancy. Appears to exist in drawing scales & stationing does not fit with 6125

Scale 1" = 150'

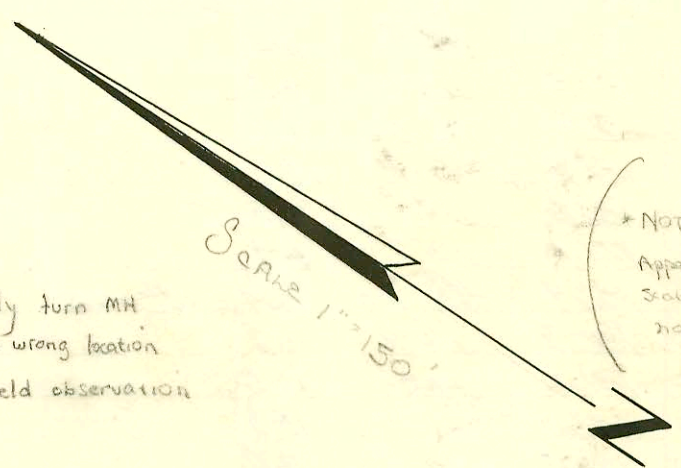

CONSTRUCTION RECORD

SERVICE RECORD

STATION	ELEVATION		Depth	MANHOLE	4-INCH "Y" BRANCHES		No. of Permit		House Number		DATE OF PERMITS	
	Ground	Grade			North West	South East	North West	South East	North West	South East	North West	South East
127+00	120.8	100.9	19.9									
128+00	121.7	101.1	20.6	127+98°								
129+00	121.5	101.3	20.2									
130+00	121.4	101.5	19.9									
131+00	121.6	101.7	19.9									
132+00	122.8	101.9	20.9									
133+00	123.6	101.1	22.5									
	123.6	102.13	21.5	133+055								
134+00	123.8	102.3	21.5									
135+00	124.2	102.5	21.7									
136+00	124.2	102.7	21.5									
	123.8	102.86	20.9	136+66°								
137+00	124.6	102.9	21.7									
138+00	125.8	103.1	22.7									
139+00	126.0	103.3	22.7									
140+00	124.2	103.5	20.7									
141+00	125.4	103.7	21.7									
142+00	120.7	103.9	16.8									
143+00	124.3	104.1	20.2									
	124.2	104.18	20.0	143+25°	SEE BELOW							
144+00	126.4	104.3	22.1									
145+00	126.4	104.5	21.9									
146+00	124.6	104.7	19.9									
147+00	124.2	104.9	19.3									
148+00	123.7	105.1	18.6									
149+00	122.3	105.3	17.0									
	123.2	105.4	19.8	149+26°								
150+00	123.2	105.5	17.7									
151+00	123.2	105.7	17.5									
152+00	123.8	105.8	18.0									
153+00	124.4	106.0	18.4									
154+00	124.4	106.1	18.3									
155+00	124.8	106.3	18.5									
	124.6	106.4	18.2	155+67								
156+00	125.0	106.5	18.5									
157+00	125.0	106.6	18.4									
158+00	124.8	106.8	18.0									
159+00	124.8	106.9	17.9									
160+00	125.0	107.1	17.9									
161+00	125.2	107.3	17.9									
	125.6	107.4	18.2									
		107.7	17.9	161+89.5								
162+00	125.8	107.7	18.1									
163+00	125.8	107.8	18.0									
164+00	126.0	108.0	18.0									
165+00	126.2	108.2	18.0									
166+00	126.4	108.3	18.1									
167+00	120.0	108.5	11.5									
168+00	124.3	108.6	15.7									
	127.6	108.74	18.9									
		108.87	18.7	168+64°								
169+00	120.4	108.9	11.5									
170+00	122.4	109.1	13.3									
171+00	126.3	109.3	17.0									
172+00	126.6	109.5	17.1									
	126.9	109.69	17.2	172+75°								
REGON MHS AT JUNCTURE MCCONNELL AIR BASE SEWER & 24" WIS												
143+25	126.7	104.18	22.5	0+00=143+25								
	125.5	104.10	21.4	0+44.6								
1+00	126.9	104.82	22.1									
	OUT 120.84	7.7										
	IN 121.09	7.4	1+69.6									
	OUT 121.35	7.9										
	IN 121.85	7.4	1+89.0									

C 35780-5701-03 E Kinbaid - Robt Mc Elroy - (Park Dept) 11-2-72 - mN. to (161+89.5)