
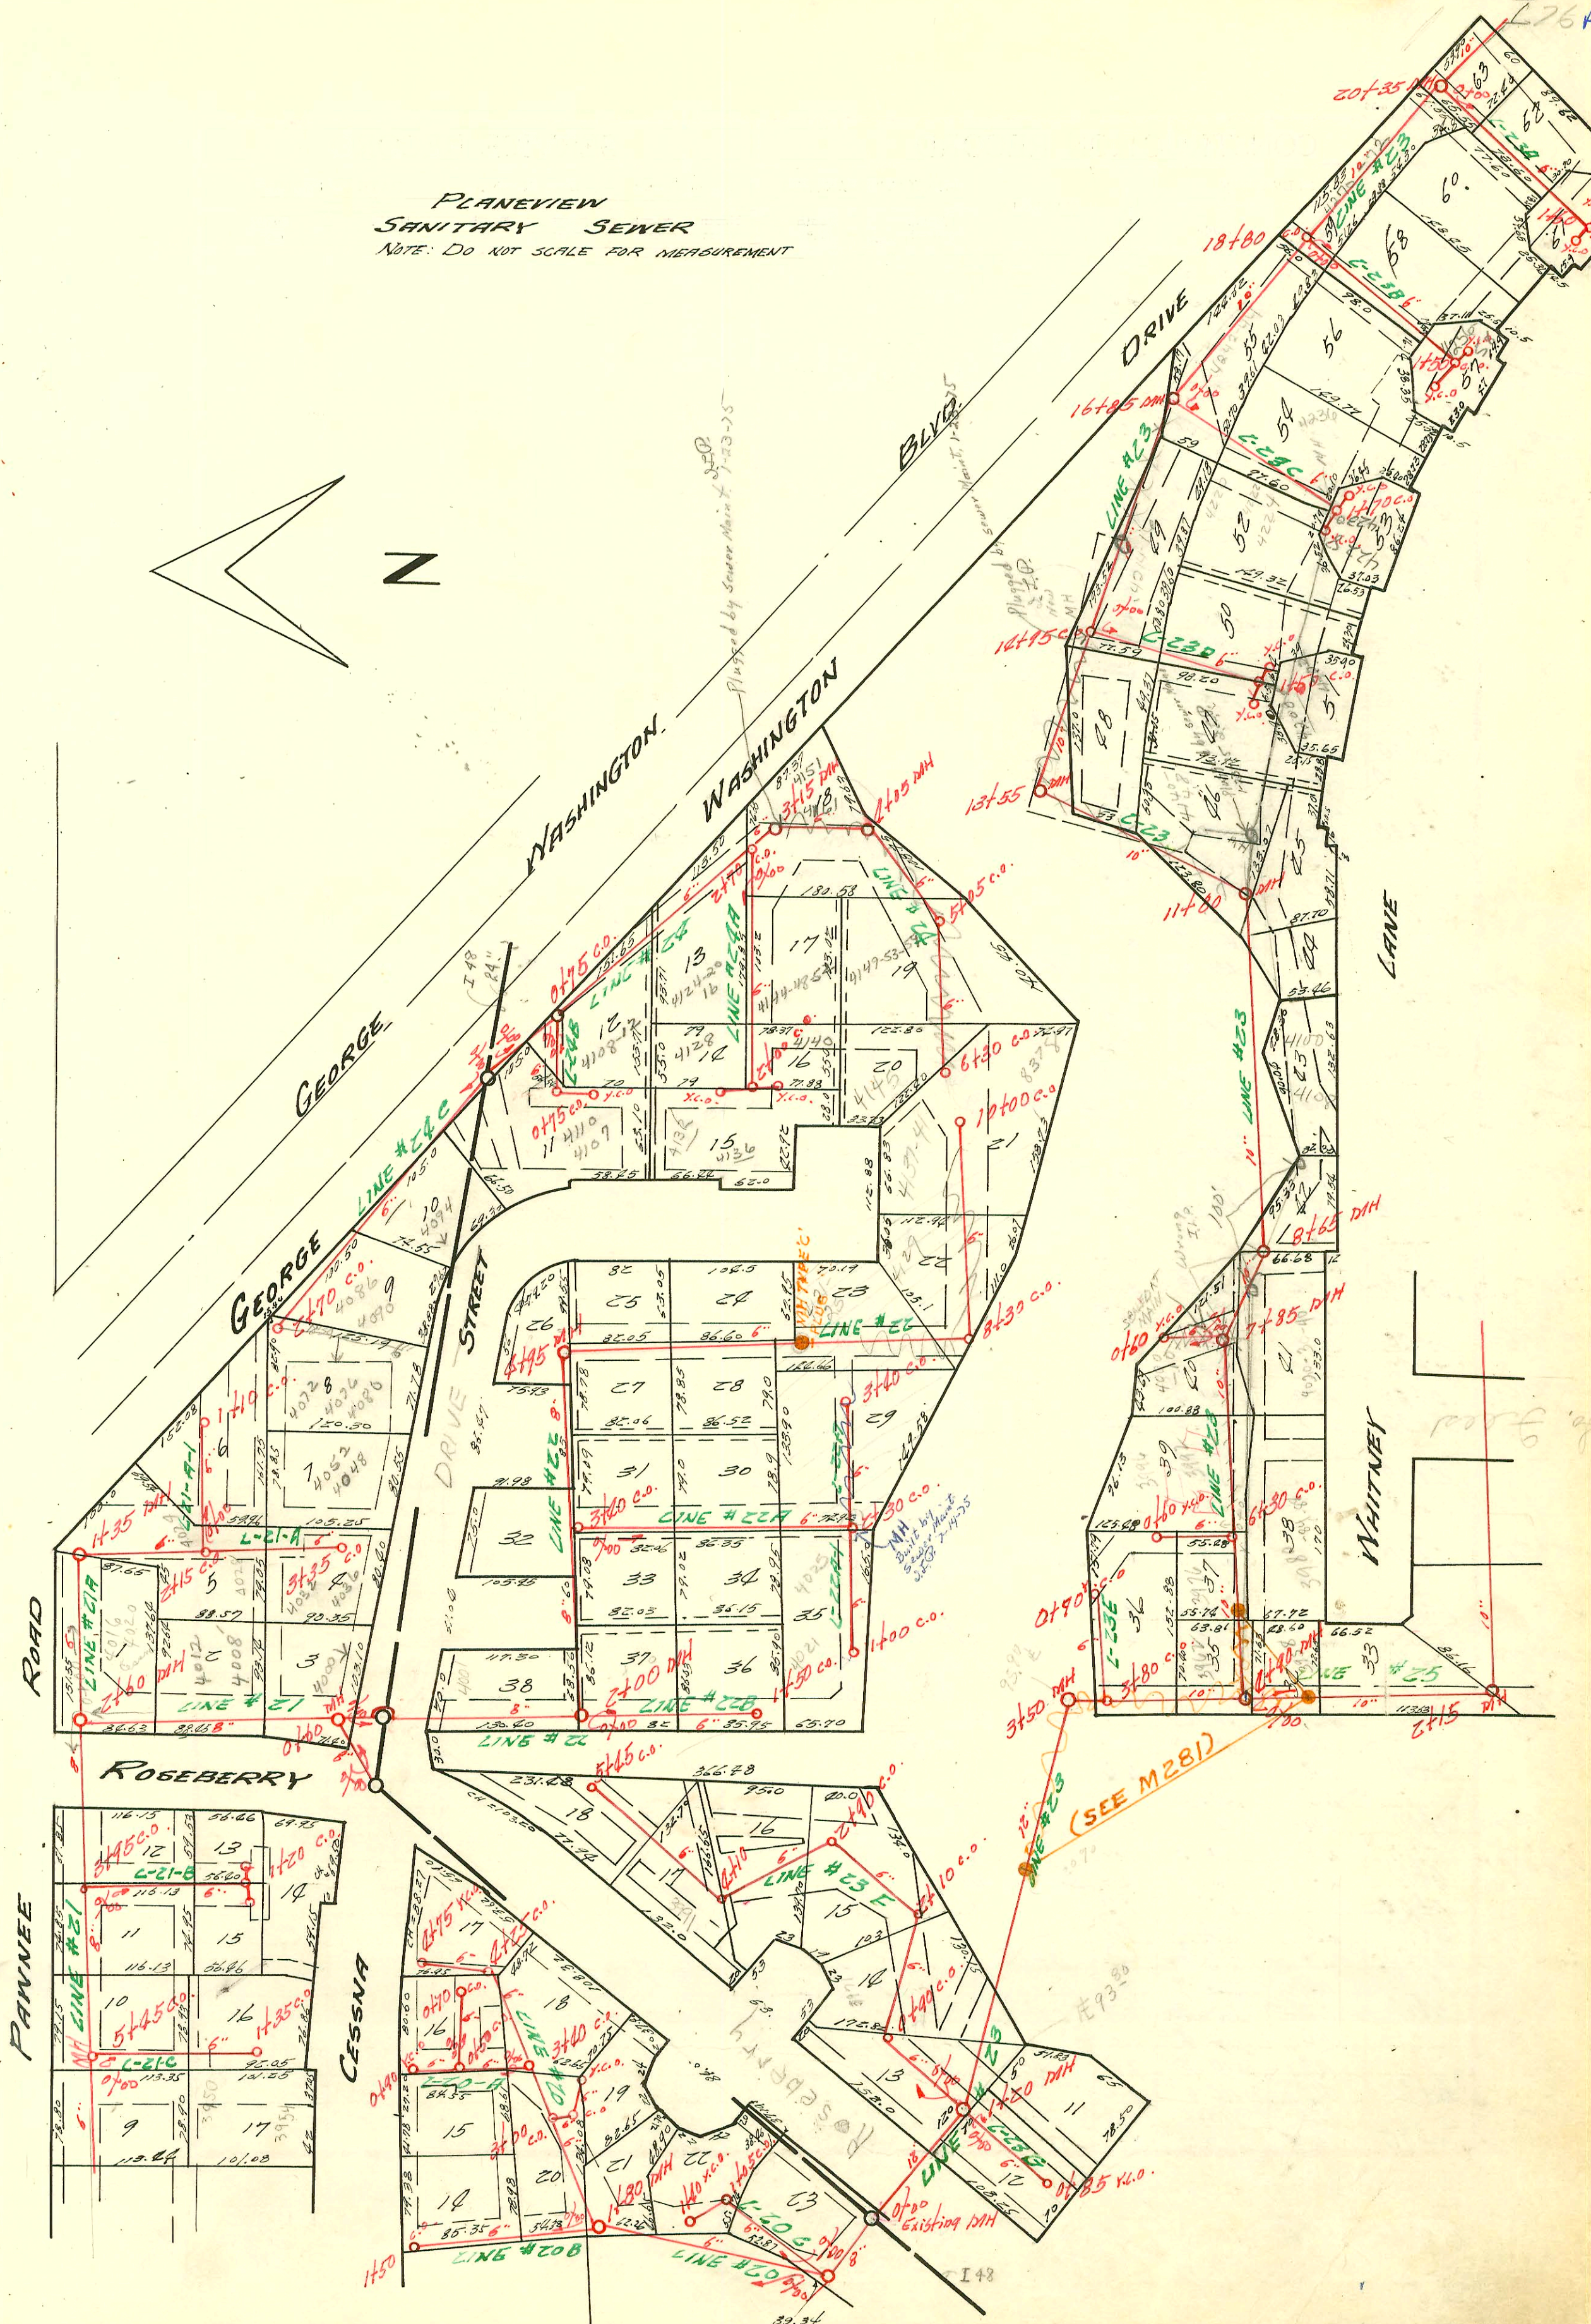


PLANEVIEW  
SANITARY SEWER  
NOTE: DO NOT SCALE FOR MEASUREMENT

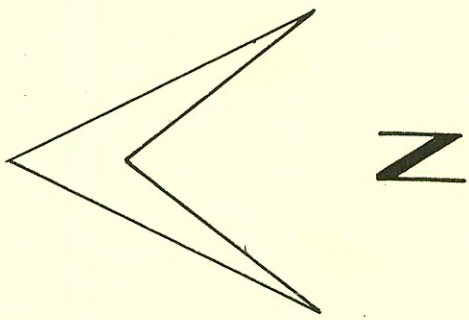

Plotted by Sewer Maint. 1-23-35

(SEE M281)

EXISTING MH

EXISTING MH

EXISTING MH

CONSTRUCTION RECORD

SERVICE RECORD

STATION	ELEVATION		Depth	MANHOLE	4-INCH "Y" BRANCHES		No. of Permit		House Number		DATE OF PERMITS	
	Ground	Grade			North West	South East	North West	South East	North West	South East	North West	South East
Line # 20	0+00	111	108.2	2.8	Existing MH							
	1+00	112	118.7	3.3								
		113	109.1	3.9	1+80							
	2+00	113	109.2	3.8								
	3+00	112	109.8	2.2		3+00						
		112	109.9	1.9		3+00						
	4+00	112	110.4	1.6								
		113	110.4	2.6		4+25						
		113	110.7	2.3		4+75 y.c.o.						
Line # 20A	0+00	113	109.97	3.03		Existing c.o.						
		113	110.7	2.3		0+90 y.c.o.						
Line # 20B	0+00	113	110.6	2.4	Existing MH							
	1+00	114	111.8	2.2								
		114	112.3	1.7		1+50						
Line # 20C	0+00	111	107.1	3.9	Existing MH							
	1+00	111	107.6	3.4								
		111	107.6	3.4		1+05						
		111	107.8	3.2		1+40 y.c.o.						
Line # 21	0+00	114	102.6	11.4	Existing MH							
		114	102.9 <sup>over</sup> 11.1	5.8	0+60							
	1+00	114	108.3	5.7								
	2+00	114	108.6	5.4								
		116	108.8	7.2	2+60							
	3+00	116	109.1	6.9								
		116	110.1	5.9		3+95						
	4+00	116	110.2	5.8								
	5+00	116	111.1	4.9								
		115	111.4	3.6		5+45						
Line # 21A	0+00	115	108.8	6.2	Existing MH							
	1+00	115	109.3	5.7								
		115	109.4	5.5	1+35	0+49			Leaf #18898	4016 Cesena 4020 Cesena	4-20-70	
	2+00	115	109.8	5.2		0+88						
		114	109.9	4.1		2+15						
	3+00	114	110.3	3.7								
		114	110.5	3.5		3+35						
Line # 21A-1	0+00	114	109.9	4.1		Existing c.o.						
	1+00	115	111.9	3.1								
		115	112.1	2.9		1+10						
Line # 22	0+00	114	102.9	11.1	Existing MH							
	1+00	114	103.1	10.9			4" PVC 40 +53		B-308777	4021 R Cesena	12-7-93	
	2+00	114	103.5	10.5	2+00							
	3+00	114	103.8	10.2								
		114	104.0	10.0		3+40						
	4+00	114	104.1	9.9								
		114	104.3	9.7	4+95							
	5+00	114	104.3	9.7								
	6+00	114	104.8	9.2								
	7+00	113	105.3	7.7								
	8+00	111	105.8	5.2								
		111	106.1	4.9		8+30						
	10+00	111	106.3	4.7		10+00						
Line # 22A	0+00	114	109.3	4.7		Existing c.o.						
	1+00	114	109.8	4.2								
	2+00	114	110.3	3.7								
		114	110.5	3.5		2+30						
	3+00	114	110.8	3.2								
		114	111.1	2.9		3+00						
Line # 22A-1	0+00	114	110.5	3.5	changed to MH	Existing c.o.			6502	4021 S Cesena	9-9-82	
	1+00	114	111.0	3.0		1+00						
Line # 22B	0+00	114	109.9	4.1	Existing MH							
	1+00	114	110.4	3.6								
		114	110.7	3.3		1+50						
Line # 23	0+00	110	93.5	16.5	Existing MH							
	1+00	112	93.7	18.3								
		112	93.8	18.2	1+20							
	2+00	112	93.9	18.1								
	3+00	100	94.1	5.9								
		112	95.9	16.1	3+50							
		112	96.1	15.9		3+80						
	4+00	112	96.2	15.8								

SO 4129 Cesena Dr. C-42872-12-27-73 - Al Henning  
 SO 4121-25 Cesena Dr. C-42873-12-27-73 - Al Henning  
 SO 4131-41 Cesena Dr. C-42874-12-27-73 - Al Henning  
 SO 4145 Cesena Dr. C-42875-12-27-73 - Al Henning  
 SO 4012 Cesena Dr. C-43217-1-29-74 - Al Henning  
 SO 4008 Cesena Dr. C-43127-1-23-74 - Al Henning

