


HOME ECO. BLDG. S.S. W.U.
 W.B. CARTER CONST. CO. JULY 29.57
 BK. # K-36 PRIVATE CONTR.

PRIVATE S.S. EXTENSION
 KENDALL PLUMBING CO. 8-15-72
 BK. # IH 67 AARB 502020

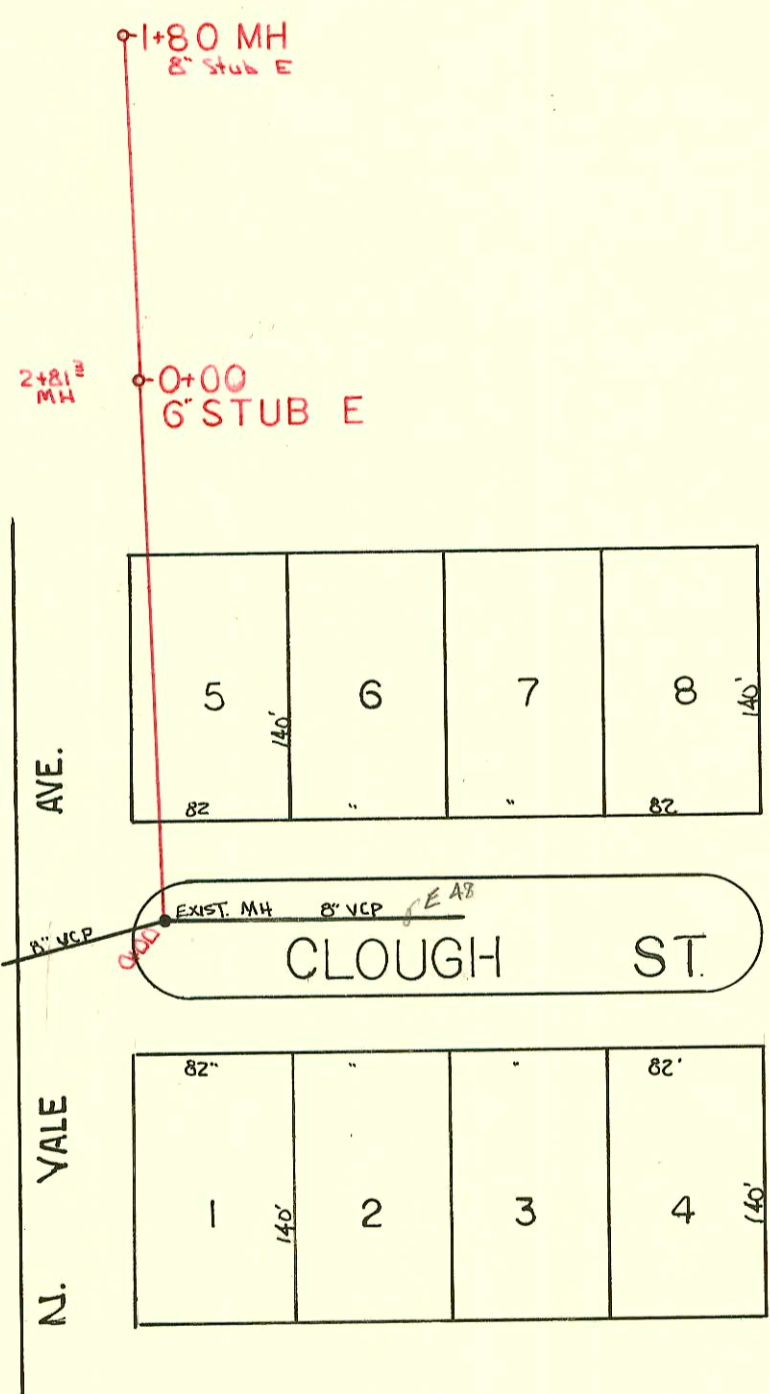

HOME ECO. BLDG. S.S. W.U.
 W.B. CARTER CONST. CO. 7-29-57
 BK # K-36 PRIVATE CONTR.

CONSTRUCTION RECORD

SERVICE RECORD

STATION	ELEVATION		Depth	MANHOLE	4-INCH "Y" BRANCHES		No. of Permit		House Number		DATE OF PERMITS	
	Ground	Grade			North West	South East	North West	South East	North West	South East	North West	South East
0+00	210.1	203.21	6.9	Existing MH								
1+00	211.3	203.31	8.0									
2+00	211.7	203.41	8.3									
	211.5	203.49	8.0	2+81.3								
<i>SNO Y62</i>												
0+00	210.1	203.21	6.9	EXIT MH								
1+00	211.3	203.31	8.0									
2+00	211.7	203.41	8.3									
	211.5	203.49	8.0	2+81.3 MH								
 <i>PRIVATE SS. EXTENSION</i>												
0+00	211.5	202.97	8.5	0+00 - 2+81.3								
1+00	210.8	205.42	5.4	1+80 8" stub E								

Permit # 5040 - Psychology Lab, W.U. - Simones plbg (6" on 8")