
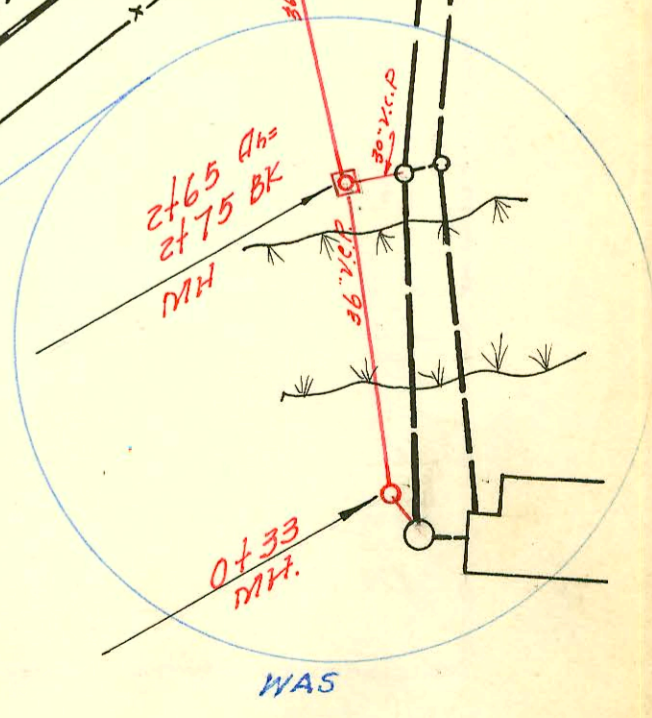


SCALE ≈ 1" = 150'

ALTERING, REPAIRING, OR RECONSTRUCTION THE WAR INDUSTRIES SEWER

July 23, 1957

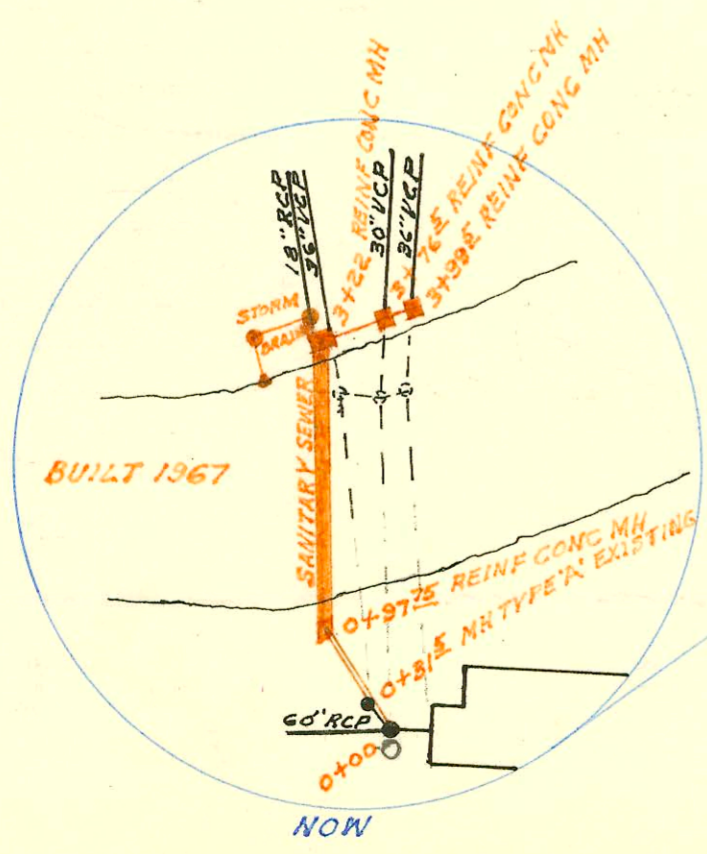

CONSTRUCTION RECORD

SERVICE RECORD

STATION	ELEVATION		Depth	MANHOLE	4-INCH "Y" BRANCHES		No. of Permit		House Number		DATE OF PERMITS	
	Ground	Grade			North West	South East	North West	South East	North West	South East	North West	South East
0+00	94.5	76.00 77.93	18.5 16.6	Existing DM								
	93.2	77.95	15.3	0+33								
1+00	88.0	72.20	15.8									
2+00	75.5	70.00	5.5									
	93.0	77.95 79.10	15.0 13.9	2+75 BX- 2+65 4h }								
3+00	91.8	79.16	12.6									
4+00	91.0	79.32	11.7									
5+00	92.0	79.48	12.5									
6+00	92.5	79.64	12.9									
	94.0	79.67	14.3	6+22								
7+00	94.0	79.79	14.2									
	91.8	79.94	11.8	7+90								
8+00	91.3	79.96	11.3									
9+00	91.3	80.12	11.2									
10+00	91.9	80.28	11.6									
11+00	92.5	80.44	12.0									
12+00	93.7	80.60	13.1									
	94.5	80.74 81.22	13.8 13.3	12+76								
13+00		Existing W.I.S.										
23+00	96.0	82.70 82.80	13.3 13.2	23+87								
24+00	96.5	82.83	13.7									
25+00	97.0	83.03	14.0									
26+00	97.5	83.23	14.3									
27+00	97.5	83.43	14.1									
28+00	98.9	83.63	15.3									
	99.0	83.63	15.4	28+07								
29+00	100.0	83.83	16.2									
30+00	101.5	84.03	17.5									
31+00	102.0	84.23	17.8									
32+00	102.5	84.43	18.1									
	102.8	84.46	18.3	32+15								
33+00	103.0	84.63	18.4									
34+00	103.0	84.83	18.2									
35+00	102.5	85.03	17.5									
36+00	104.0	85.23	18.8									
	104.5	85.25	19.3	36+07.9								
	105.0	85.29 85.39	19.7 19.6	36+30.9								
37+00	104.5	85.53	19.0									
38+00	104.5	85.73	18.8									
ALTER & REPAIR WIS (1967)												
0+00	94.0	78.06	15.9	EXISTING								
	93.8	78.10	15.7	0+31.5								
	93.0	78.20	14.8	0+92.5								
	92.3	78.03 OUT 78.18 IN	14.3 14.1	3+22.0								
	92.3	78.33 OUT 78.57 IN	14.0 13.7	3+76.5								
	92.2	78.60 OUT 78.70 IN	13.6 13.5	3+99.5								

NO 4" BRANCHES

9722?