
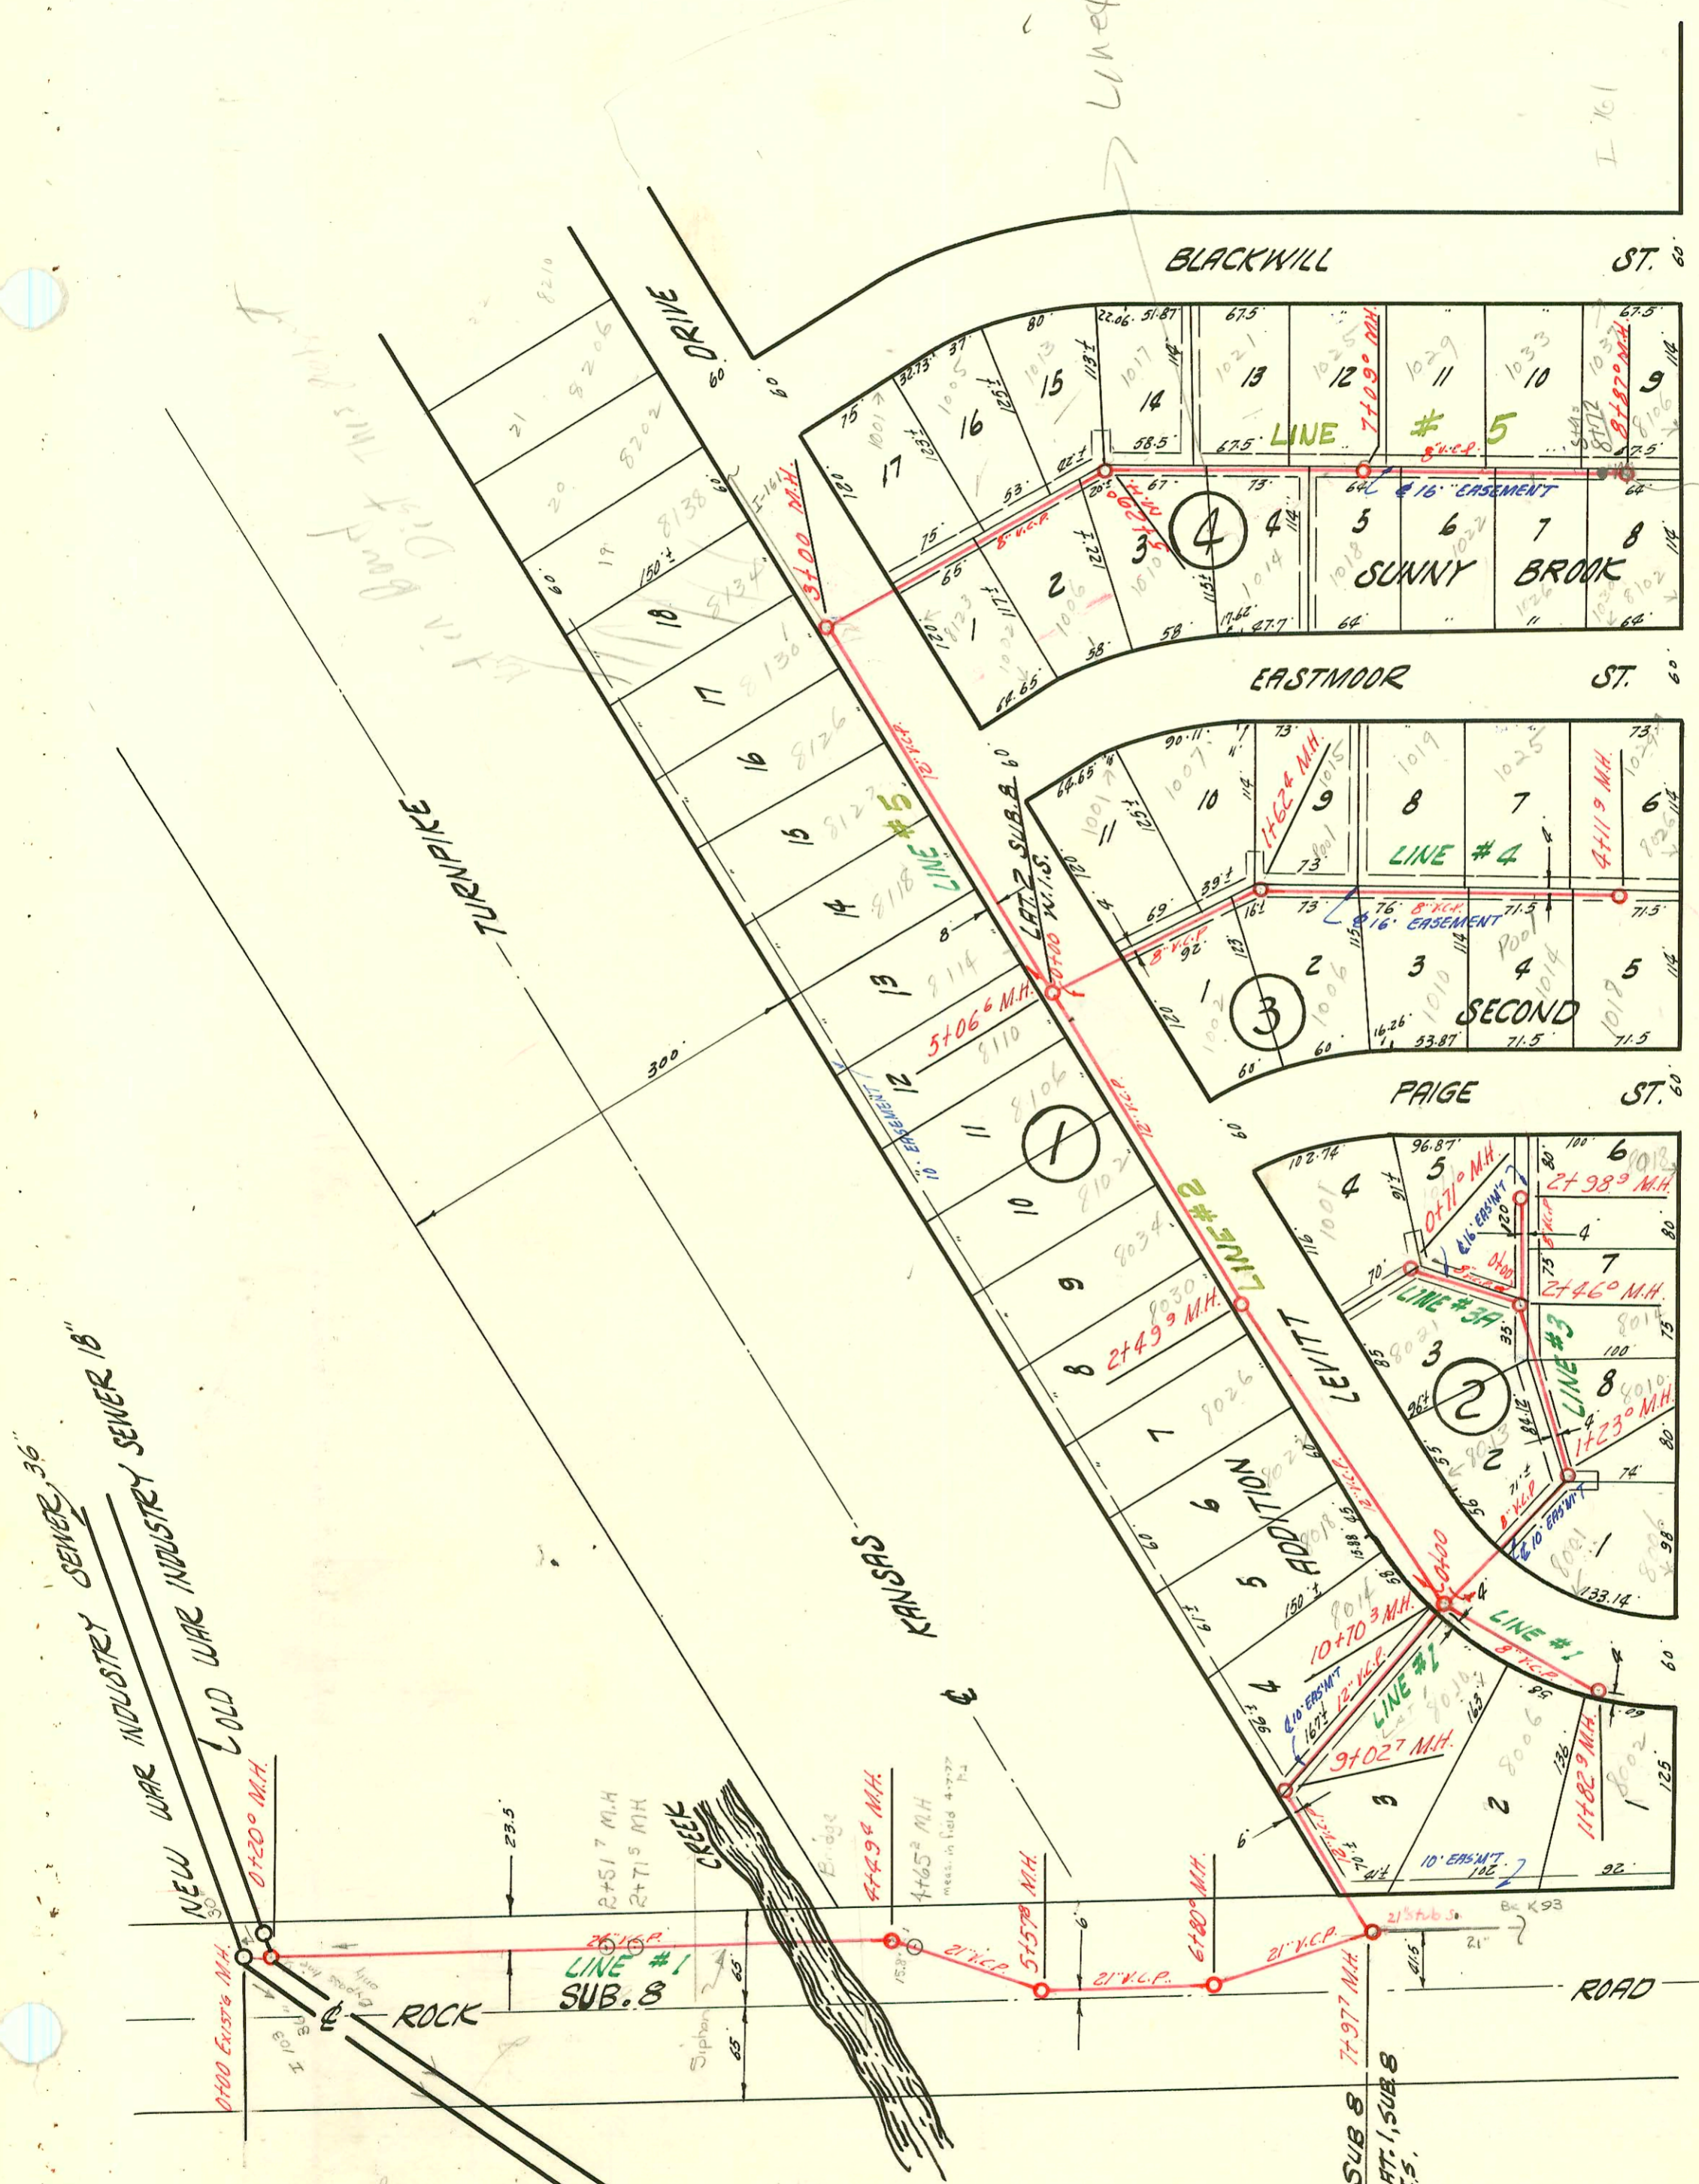


SCALE 1" = 100'

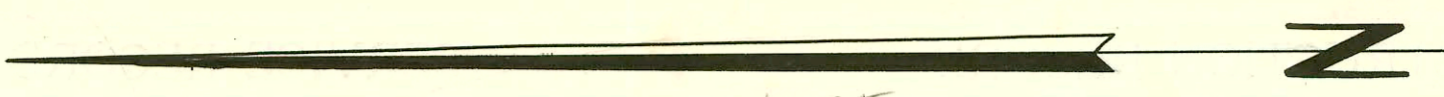

MH 878 was moved 15' in Feb 03 during main rehab in 2003. See GBA records BK-K-41

78723 - Top 80108 Zimmerly - 11/1/58 91762 line 1
 8001 Top 8001 Levitt to Top. Feb 3/16/59 1+16.5
 193940/17494 - top 8110 - 8/16/29-37 (0+06.0) line 5

SUB. 8 W.I.S. LAT. 1 AND LAT. 2 SUB. 8 W.I.S.
 UTILITY CONTRACTORS INC. 4-3-1958
 BK. NO. K-26 PROJECT NO. C 27-97, -98, -99

lines - K-41

