


24" WAR INDUSTRY
SEWER I50

WICHITA AIR FORCE BASE
PRIVATE CONTRACT
MAY 1, 1958 BOOKED FR. PLAN.
REPAIR S.S. MAIN FOR MCCONNELL AFB
BOOKED 9-21-82 FROM AFB PLAN

SCALE 1" = 200'

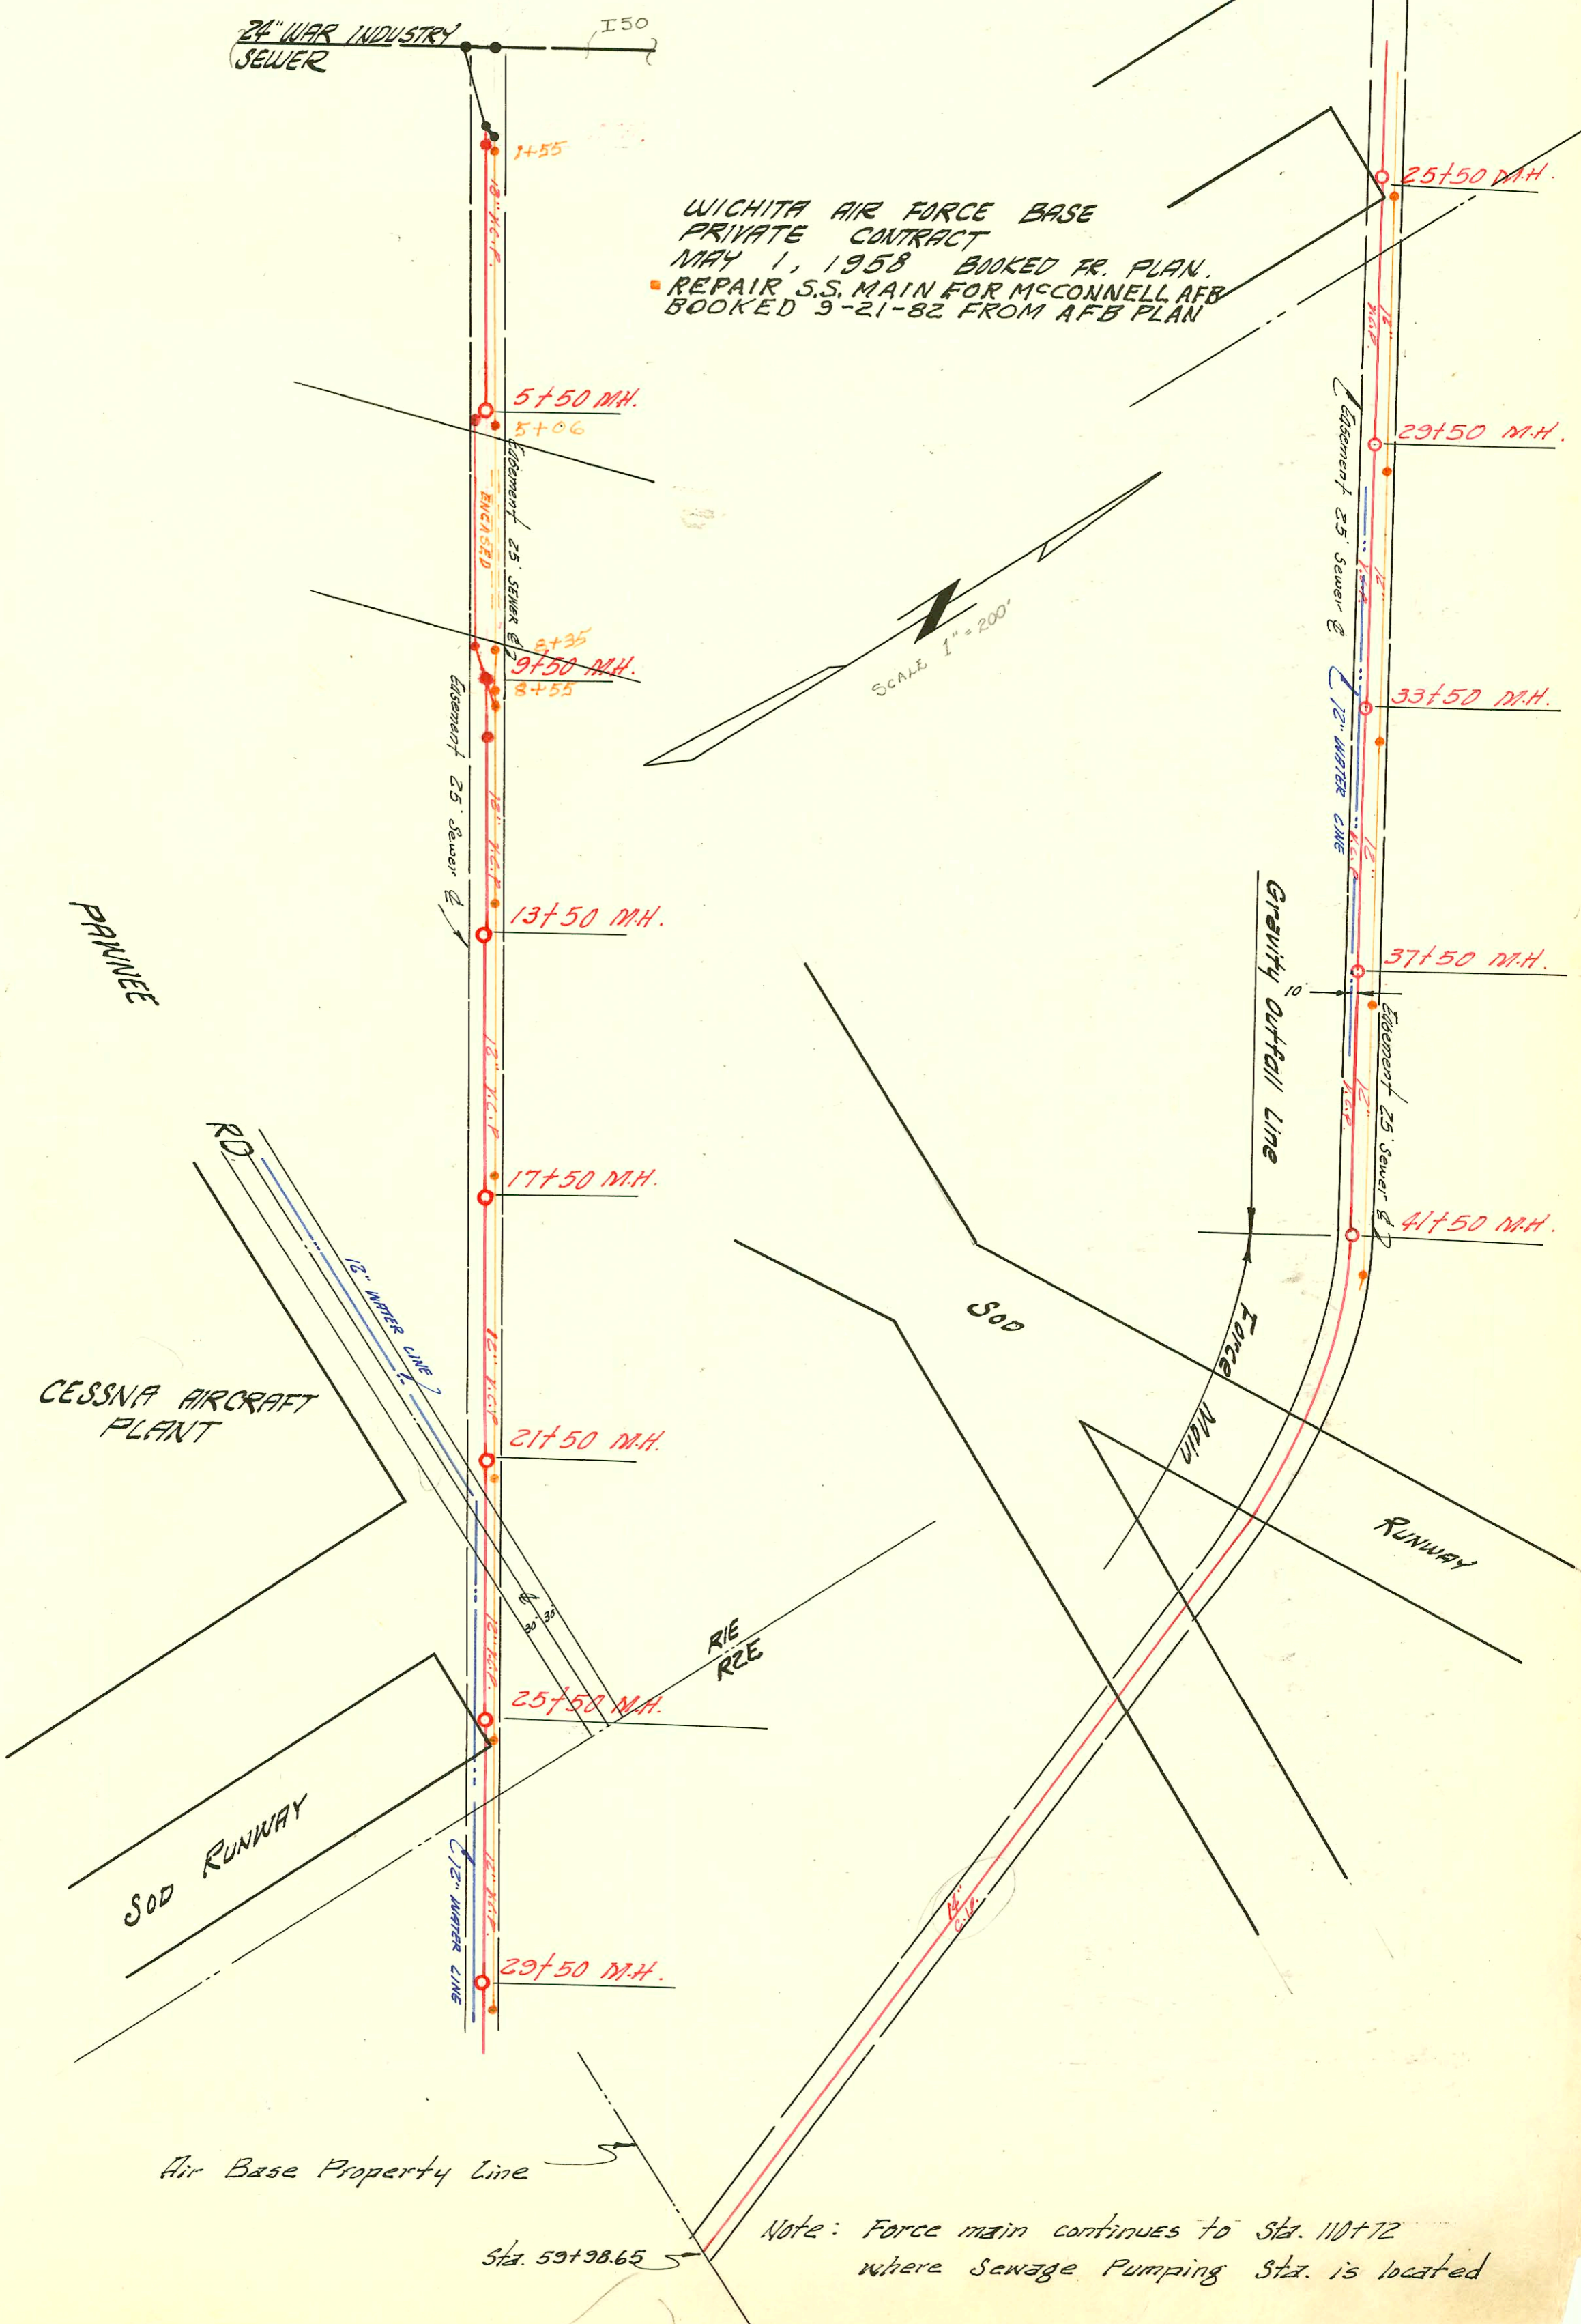

Air Base Property Line

Sta. 59+98.65

Note: Force main continues to Sta. 110+72
where Sewage Pumping Sta. is located

CONSTRUCTION RECORD						SERVICE RECORD						
STATION	ELEVATION		Depth	MANHOLE	4-INCH "Y" BRANCHES		No. of Permit		House Number		DATE OF PERMITS	
	Ground	Grade			North West	South East	North West	South East	North West	South East	North West	South East
0+00	126.1	122.6	3.5	EXIST. M.H.								
1+00	129.6	122.9	6.7									
	129.6	123.20	6.4	1+50								
2+00	130.6	124.08	6.5									
3+00	132.6	125.84	6.8									
4+00	134.6	127.60	7.0									
5+00	135.6	129.36	6.2									
	136.6	130.14	6.5	5+50								
6+00	137.6	131.02	6.6									
7+00	141.6	132.78	8.8									
8+00	142.6	132.54	8.1									
9+50	145.1	136.30	8.8									
	146.1	137.28	8.8	9+50								
10+00	147.1	138.06	9.0									
11+00	150.1	139.82	10.3									
12+00	152.0	141.58	10.4									
13+00	154.0	143.34	10.7									
	155.0	144.32	10.7	13+50								
14+00	156.5	145.20	11.3									
15+00	158.5	146.96	11.6									
16+00	159.7	148.72	11.0									
17+00	160.7	150.48	10.2									
	160.7	151.36	9.3	17+50								
18+00	161.2	151.82	9.4									
19+00	161.2	152.74	8.5									
20+00	161.7	153.66	8.0									
21+00	162.0	154.58	7.4									
	162.5	155.04	7.5	21+50								
22+00	162.9	155.50	7.4									
23+00	163.9	156.42	7.4									
24+00	164.9	157.34	7.6									
25+00	164.9	158.26	6.6									
	165.4	158.72	6.7	25+50								
26+00	166.4	159.32	7.1									
27+00	167.4	160.52	6.9									
28+00	168.9	161.72	7.2									
29+00	169.4	162.92	6.5									
	169.9	163.52	6.4	29+50								
30+00	170.5	164.12	6.4									
31+00	171.5	165.32	6.2									
32+00	172.5	166.52	6.0									
33+00	175.5	167.72	7.8									
	177.0	168.32	8.7	33+50								
34+00	178.0	169.62	8.4									
35+00	180.0	172.22	7.8									
36+00	184.5	174.82	9.7									
37+00	187.5	177.42	10.1									
	188.0	178.72	9.3	37+50								
38+00	188.0	179.18	8.8									
39+00	189.0	180.10	8.9									
40+00	190.0	181.02	9.0									
41+00	189.5	181.94	7.6									
	189.5	182.40	7.1	41+50								
42+00	189.3	182.08	7.2									
43+00	188.3	181.44	6.9									
44+00	187.4	180.80	6.6									
45+00	186.4	180.16	6.2									
46+00	185.0	179.52	5.5									
47+00	184.0	178.88	5.1									
48+00	183.5	178.24	5.3									
49+00	182.5	177.60	4.9									
50+00	181.5	176.96	4.6									
51+00	180.5	176.32	4.2									
52+00	180.0	175.68	4.3									
53+00	179.5	175.04	4.5									
54+00	179.5	174.40	5.1									
55+00	180.0	173.76	6.2									
56+00	181.5	173.12	8.4									
57+00	183.0	172.48	10.5									
58+00	182.0	171.84	10.2									
59+00	180.0	171.20	8.8									
59+98.65	179.0	170.56	8.4									

Gravity Outfall Line

Force Main

