



NOTE - 4607 West -
 Contr Kenny Honey that
 he found old 4" clay line
 tapped to M.H. He followed line &
 found it connected to nothing. He
 thought it might have served portable
 Bldg at one time. He re-used this
 + up location for new service
 line from Bldg Add.
 AB 11-30-01

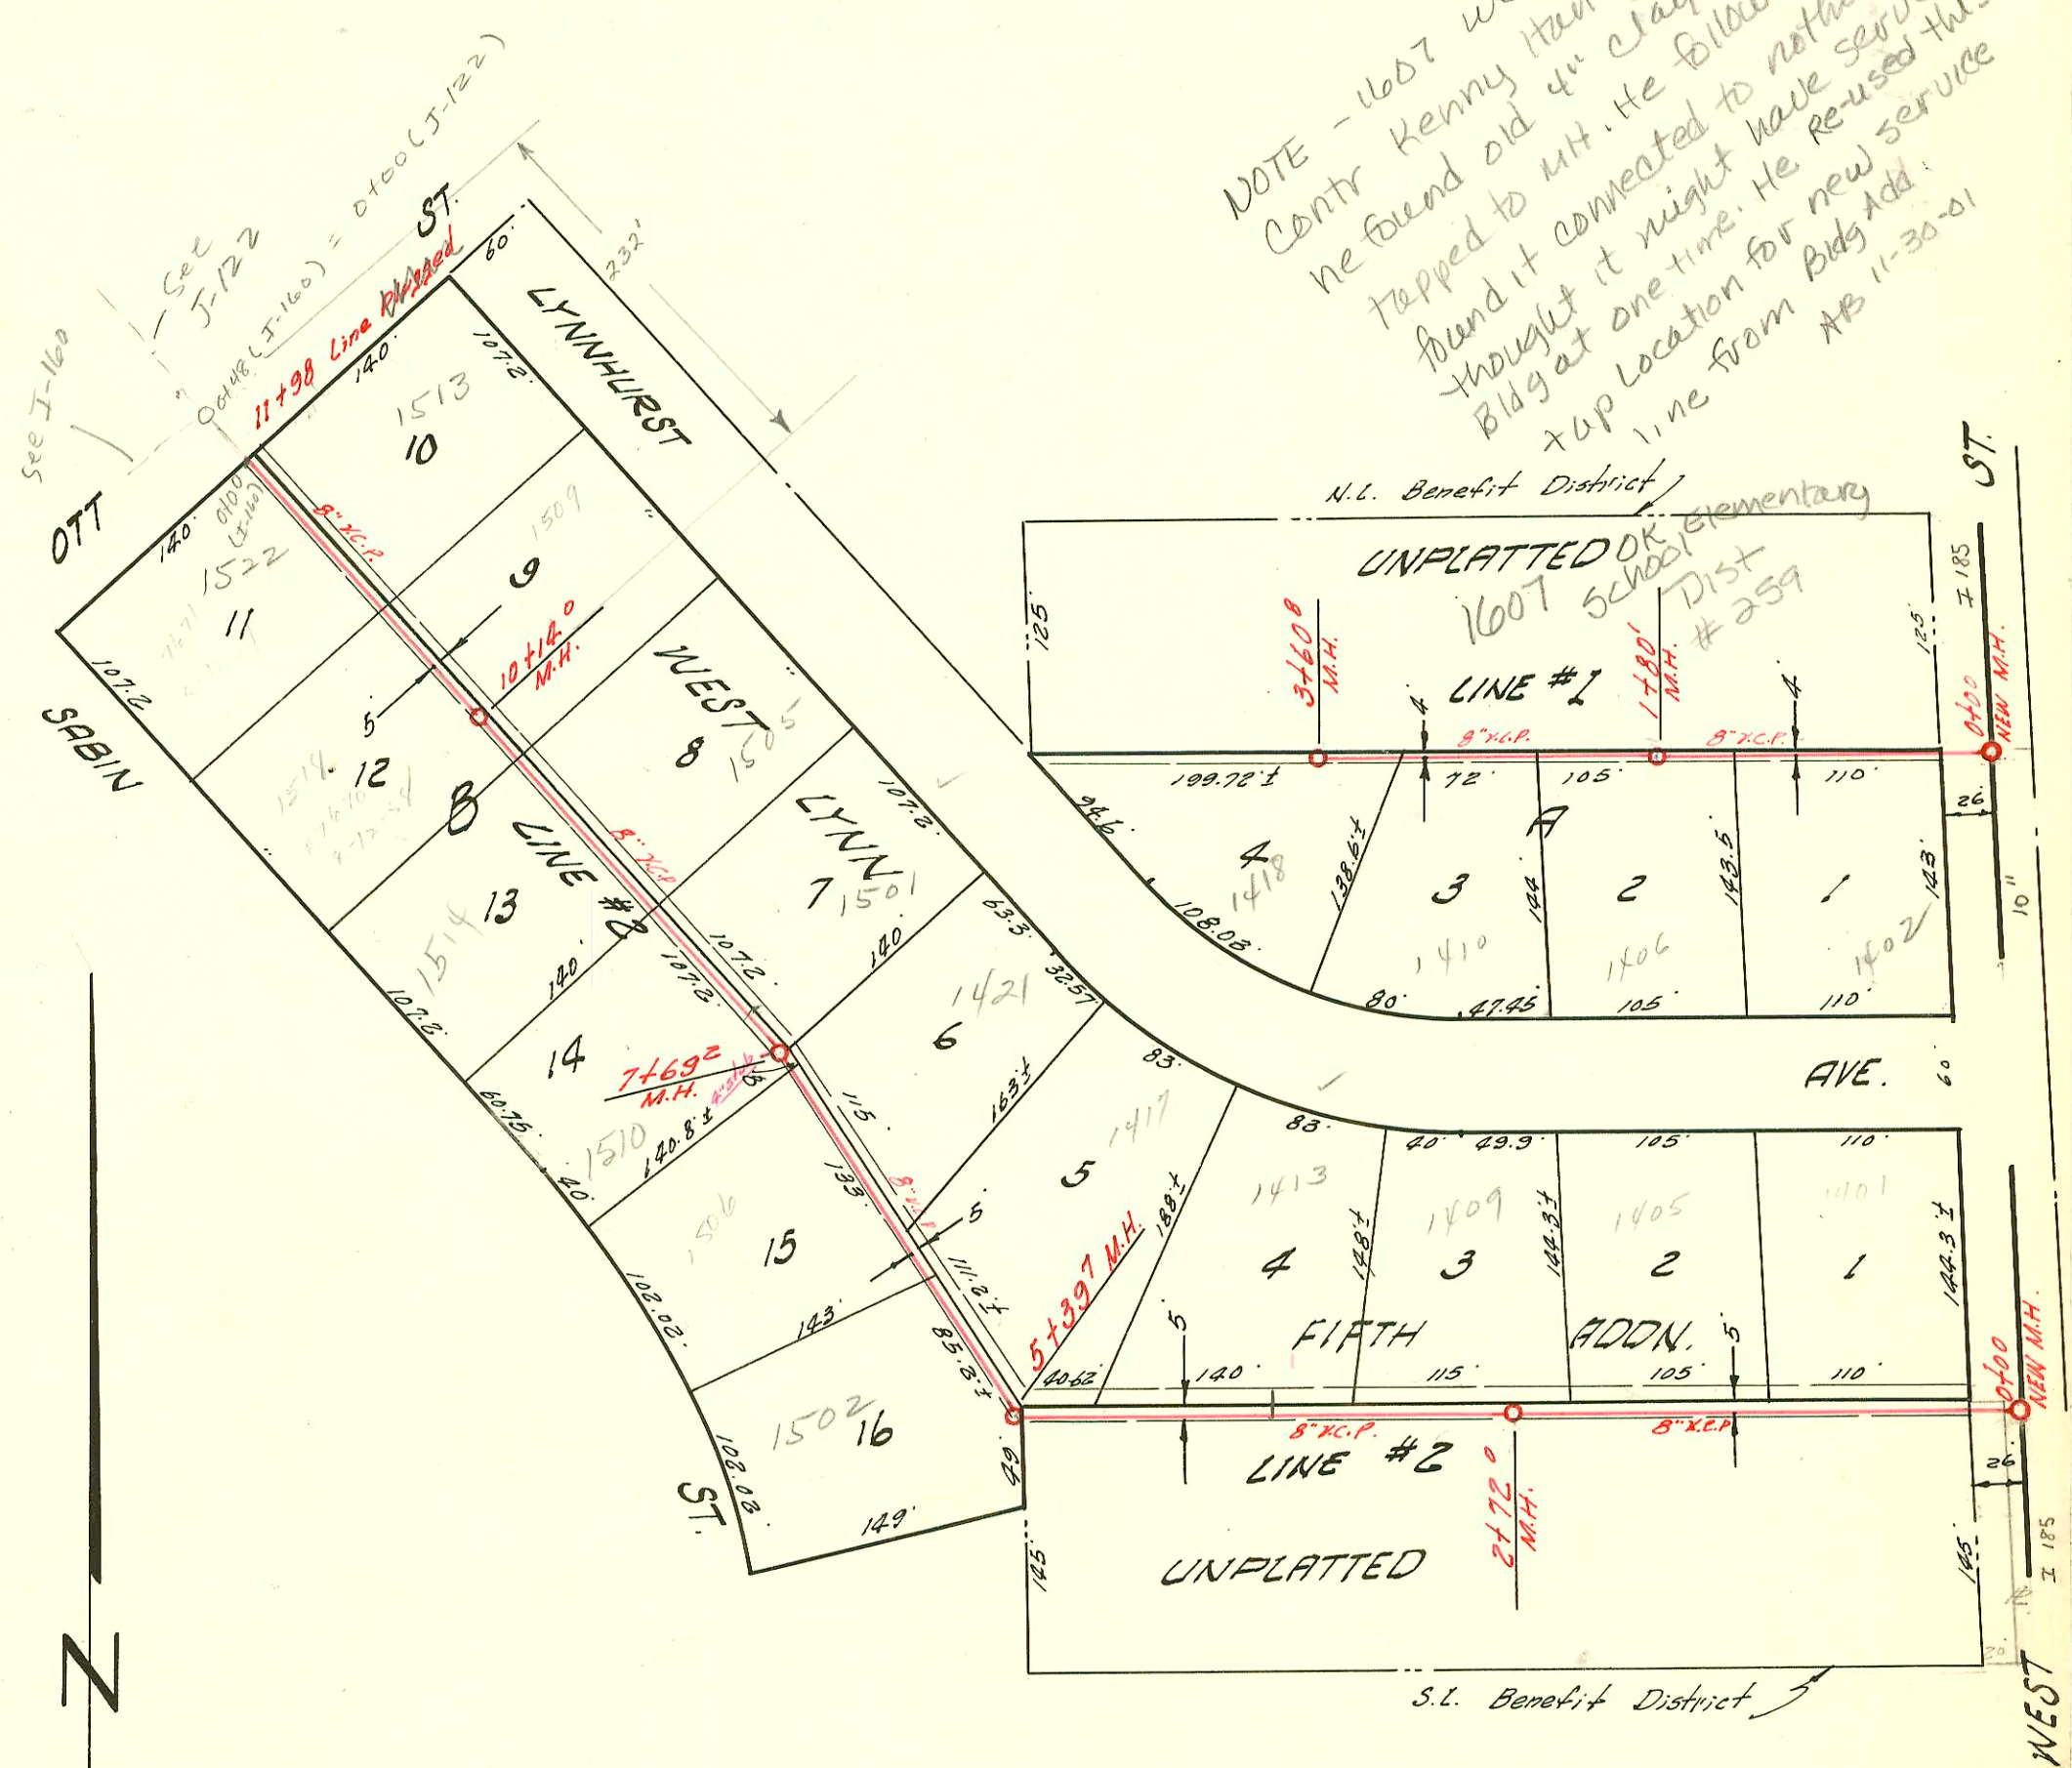

LATERAL 47 SUB 5 S.S. 22
 UTILITY CONTRACTORS INC. 8-12-58
 BK. NO. K-46 PROJ. NO. C28-34

LATERAL 4 S.S. 23
 AUG. 15, 1958
 BK. NO. K-57 PROJ. NO. PRIVATE

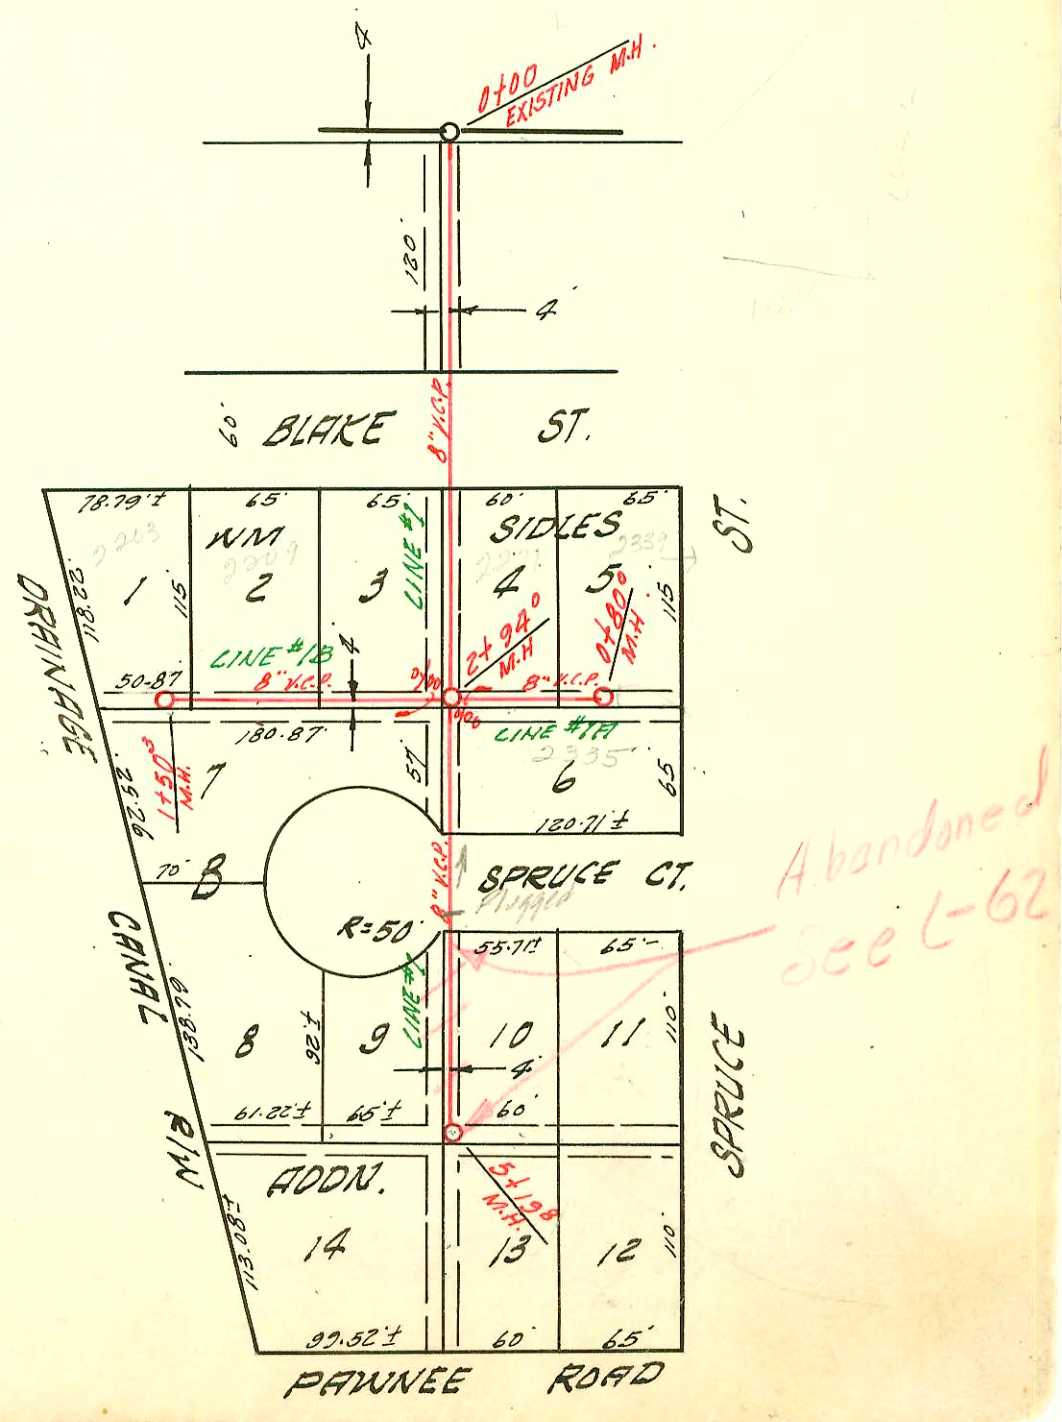

Abandoned
 See L-62

