


AVE.

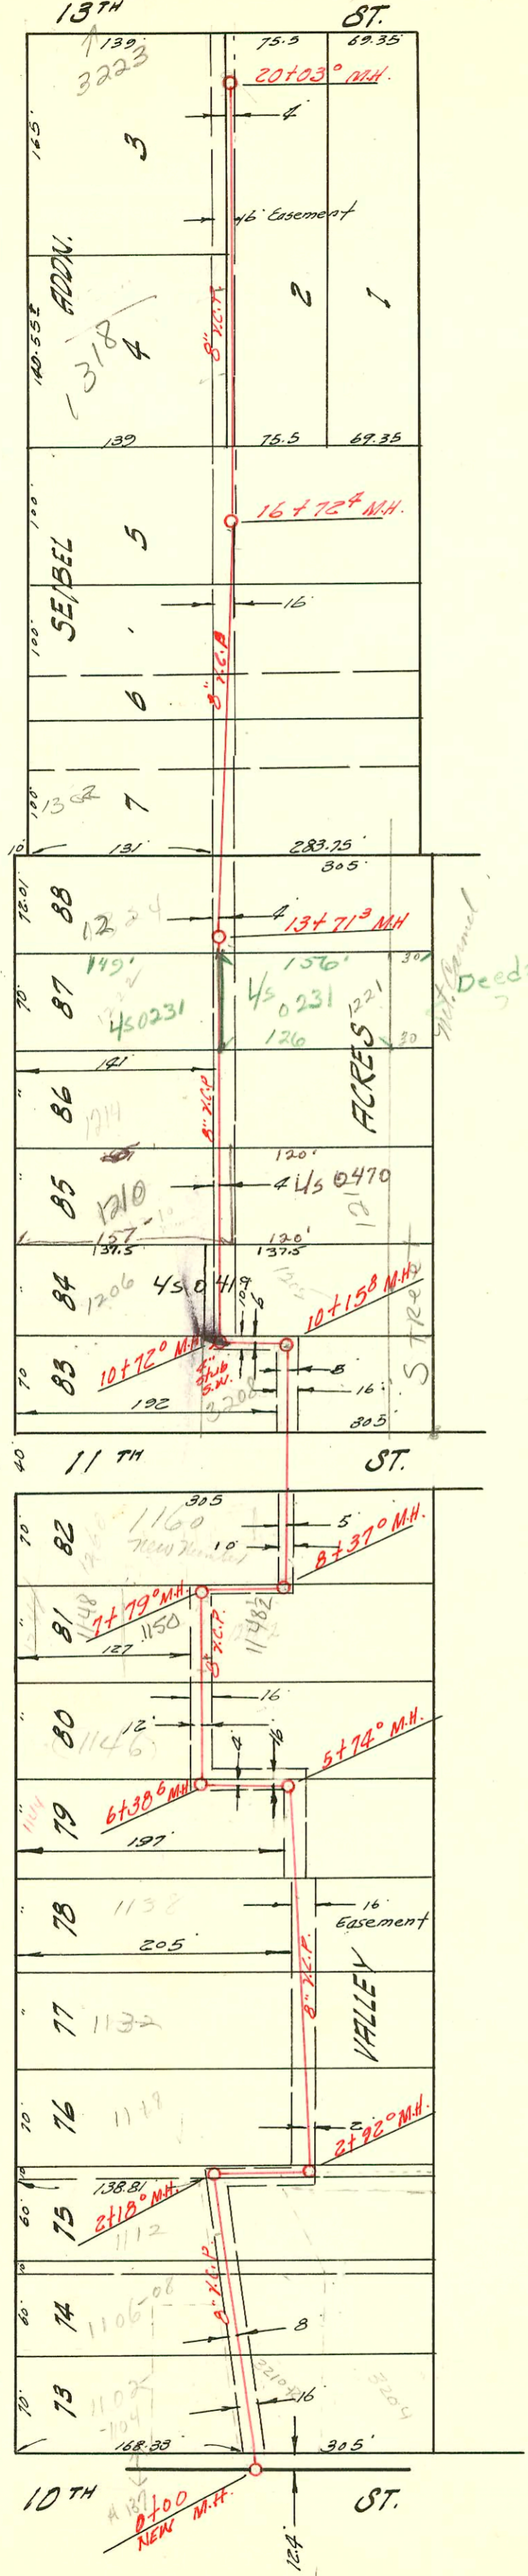

LATERAL 14 SUB 9 S.S. 22  
 UTILITY CONTRACTORS INC. 9-22-58  
 BK. NO. K-51 PROJ. NO C27-21

*Created*

CONSTRUCTION RECORD					SERVICE RECORD								
STATION	ELEVATION		Depth	MANHOLE	4-INCH "Y" BRANCHES		No. of Permit		House Number		DATE OF PERMITS		
	Ground	Grade			North West	South East	North West	South East	North West	South East	North West	South East	
0+00	121.2	111.60	9.6	NEW M.H.	+69°	0+15.0°		8712		3210 26.10th		7-14-83	
1+00	121.7	111.80	9.9		+75°		# 7931		N. Sheridan		8-25-58		
2+00	123.6	112.80	11.6		+75°			8713	106-08 3412 N. Sheridan W. 10th		12-12-83	7-14-83	
3+00	124.7 123.8 124.2	{112.03 112.17 112.30 112.40	12.7 OUT 12.6 IN 11.5 OUT 11.4 IN	2+18° 2+92°	+102° +76°	+122° +83°	# 7932 94-16-57		N. Sheridan		8-25-58 2-4-94 8-27-58		
4+00	123.8	112.60	11.2		+45° +82°	+272° +84°	# 276287 15-736 66976		118 N. Sheridan 113 N. Sheridan	3204 W 10th		7-14-83	
5+00	122.6	112.80	9.8		+45° +874R	+751°							
6+00	122.6	113.03	9.7 OUT 9.6 IN	5+74°	+335R	+355							
7+00	122.5	113.10	9.4		+372R (X.S.)		# 02873 87561			1044 1144 716 Sheridan		3-15-84	
8+00	123.0	113.18 113.26	9.8 OUT 9.7 IN	6+386	+56°	+58°	# 02874		1246 N. Sheridan			4-1-59	3-18-81
9+00	123.3	113.40	9.9		+188		# 9908		147 147 N. Sheridan			3-27-95	
10+00	123.9	113.55 113.67	10.3 OUT 10.2 IN	7+79°	+718		# 9327		1150 R 1150 R Sheridan			2-10-59 see Below	5-14-81 2-18-89
11+00	123.9	113.70 113.77 113.85	10.2 9.4 OUT 9.3 IN	8+37°	+478		# 8178		1160 N. Sheridan	3025 W 11th		6-8-60	9-19-58
12+00	123.6	114.00	9.6		+7657R +724R		12875						
13+00	123.7	114.20	9.5			+110°							
14+00	123.6	114.23 114.31	9.4 OUT 9.3 IN	10+158									
15+00	123.1	114.44 114.52	8.7 OUT 8.6 IN	10+72°	4" stub S.N.	10+337 (X.S.)	8164			3208 W 11th		9-24-58	
16+00	122.5	114.60	7.9		+16° +644	+18° +664	11712	714	1219 1207 Sheridan	1211 N at Canal		10-19-59	7-9-80
17+00	122.4	114.80	7.6		+317	+337							
18+00	122.2	115.00	7.2		+198	+200	8776		1227 Sheridan			11-24-58	
19+00	122.7	115.14	7.6	13+713	+863	+883	8086		1221 N. at Canal			9-29-58	11-21-75
20+00	122.5	115.20	7.3		+463	+483	# 8060		1224 N. Sheridan			9-19-58	
21+00	122.0	115.40	6.6		+07° +803	+09° +823	# 8061 # 8062		1227 1227 N. Sheridan			9-19-58 9-19-58	
22+00	122.3	115.60	6.7		+506	+526	# 8063		1227 N. Sheridan			9-19-58	
23+00	122.5	115.74	6.8	16+724									
24+00	122.9	115.80	7.1		+857	+877	# 8793		1312 1292 N. Sheridan			8-11-93 12-3-58	
25+00	123.8	116.00	7.8		+416	+74°	8794		1318 1592 N. Sheridan			12-3-58	
26+00	126.0	116.20	9.8										
27+00	126.8	116.40	10.4		+588	+508	19774		3223 W. 13th			11-30-87	
28+00				20+03°									

2001-01179-51461-1150 N Sheridan - Bammes - City Wp Repair 51's of MH 7179(7428) 4" S 440 ITWIN CO, 1122, 1145  
 C69939-1206 N. Sheridan - 12-21-78 - White Pkg. - New Conn. (11+10)  
 C6154-1138 N. Sheridan - addn. - 12-15-69 Reynolds Pkg. - Top  
 8441 Tap 1260 N. Sheridan, 10-25-58 Tap on 1111 7099  
 8483 Tap 1214 N. Sheridan on Buffin 11-4-58 121348