



MH 0455 and
LINE VERIFIED
IN FIELD BY CURTIS,
SEWER MAINT. 7-25-99
K

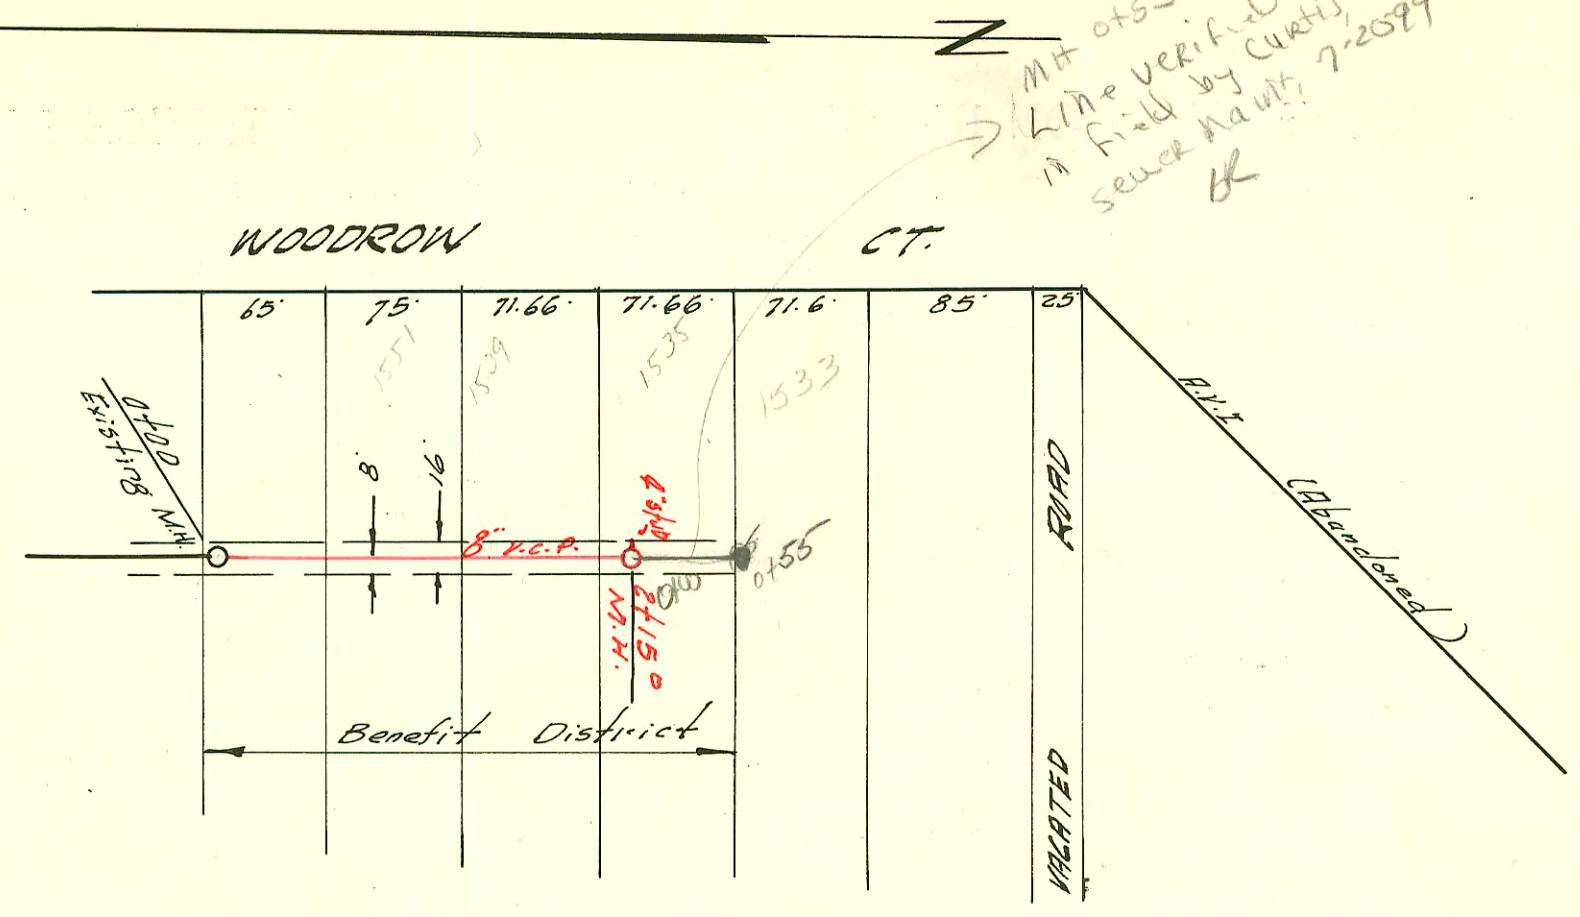


LAT. 7 SUB. R S.S. 20
UTILITY CONTR. 11-21-58
BK. NO. K-45 B PROJ. NO. C27-29

Permit # 17425-3059 w. 13th Kennedy City 7-22-63
New line of sewer
and 1st water line south of it.

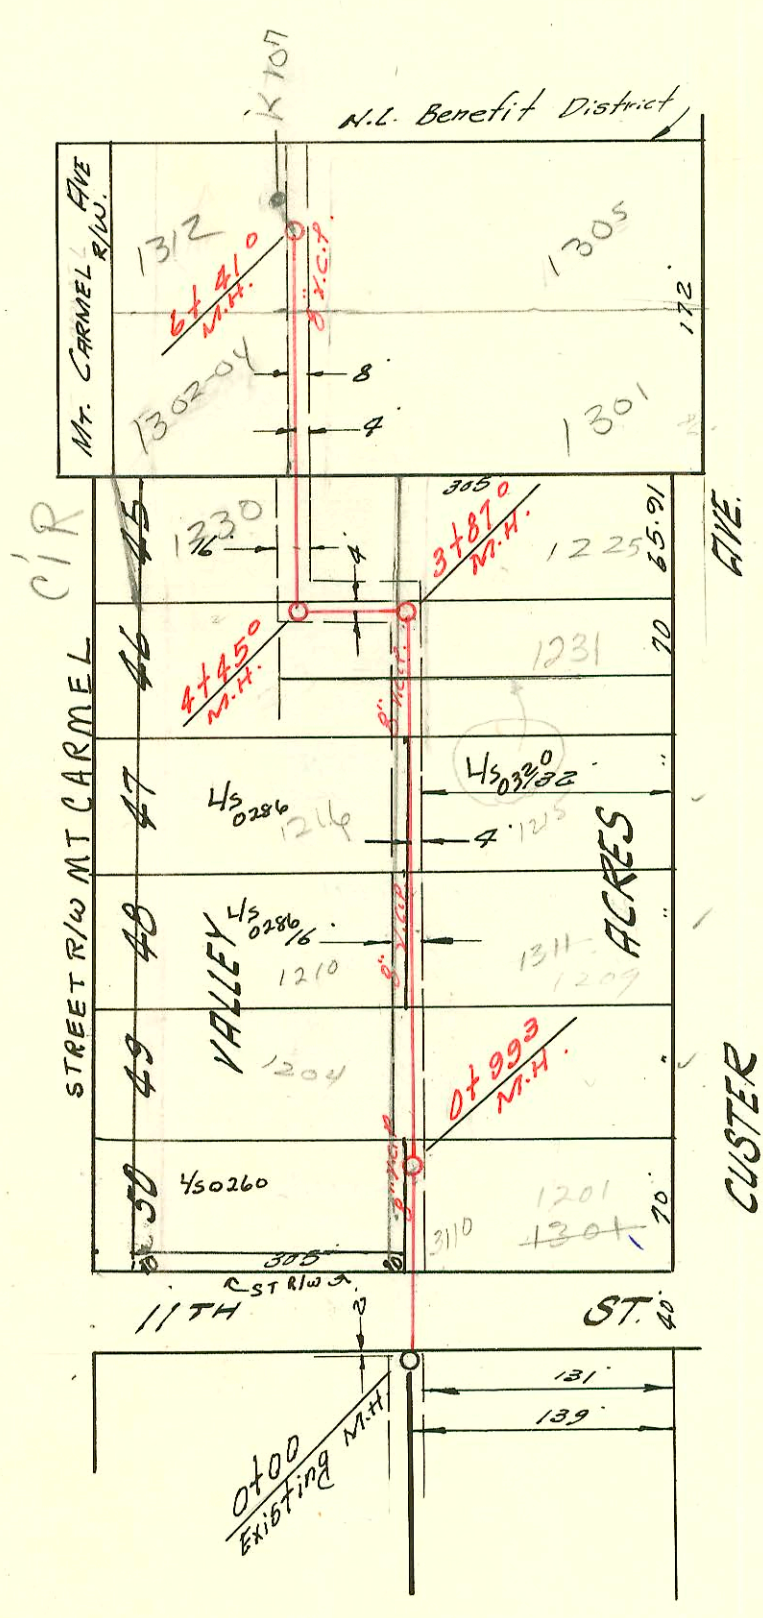

LAT. 21 SUB. 9 S.S. 22
W. B. CARTER CONST. 11-21-58
BK. NO. K-53 PROJ. # C28-42

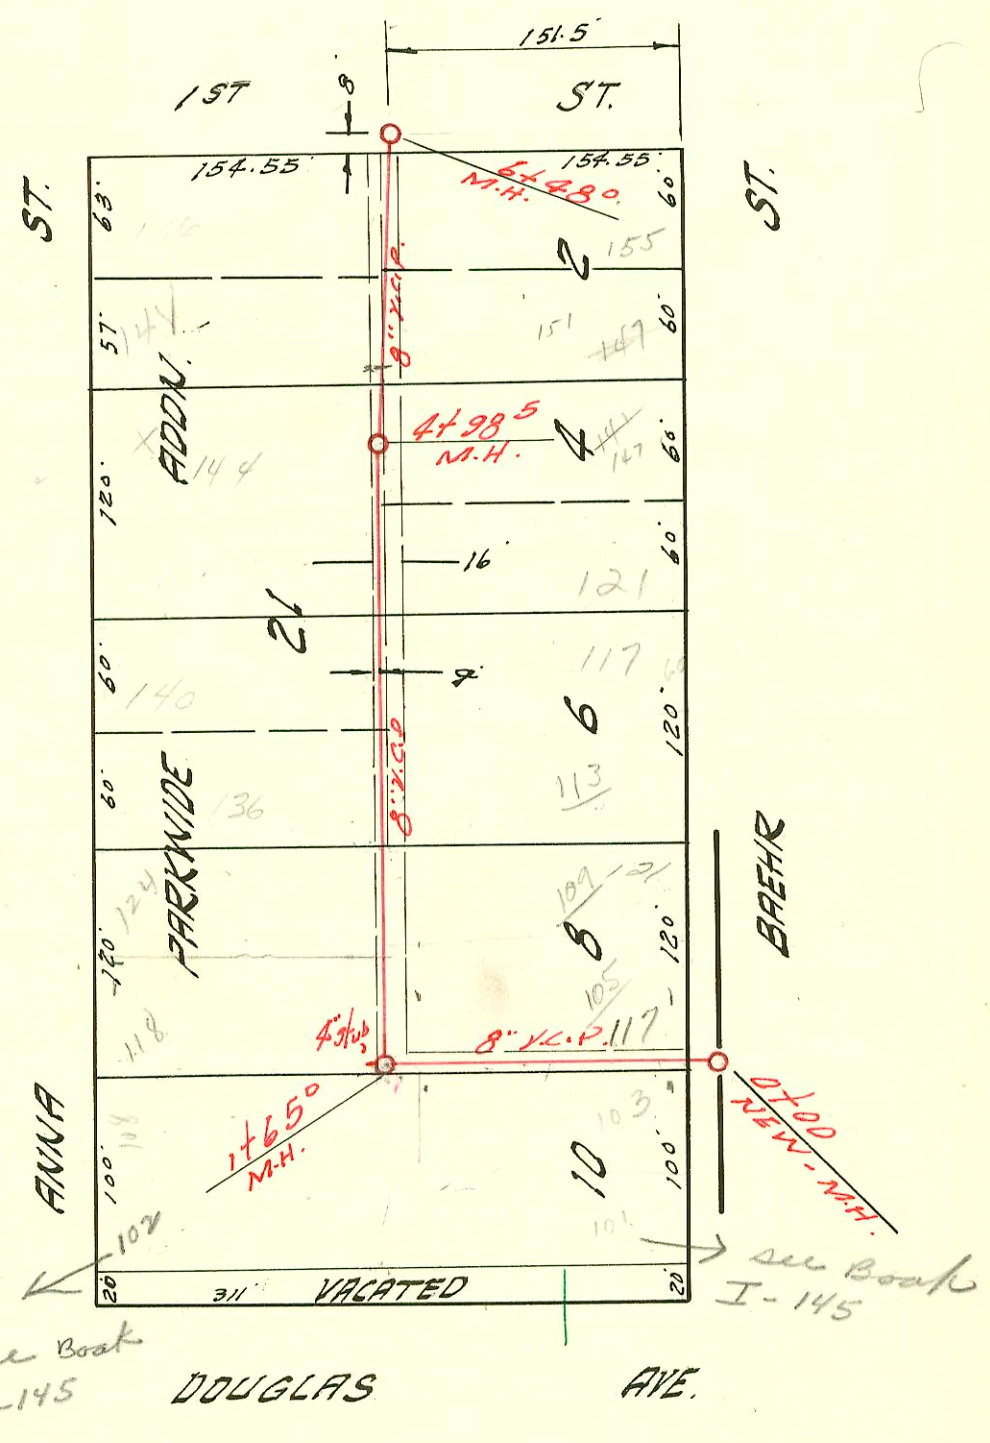

LAT. 30 SUB. 5 S.S. 22
UTILITY CONTRA. 11-21-58
BK. NO. K-60 PROJ. NO. C27-107

Sheldon

See Book
I-145

See Book
I-145

