
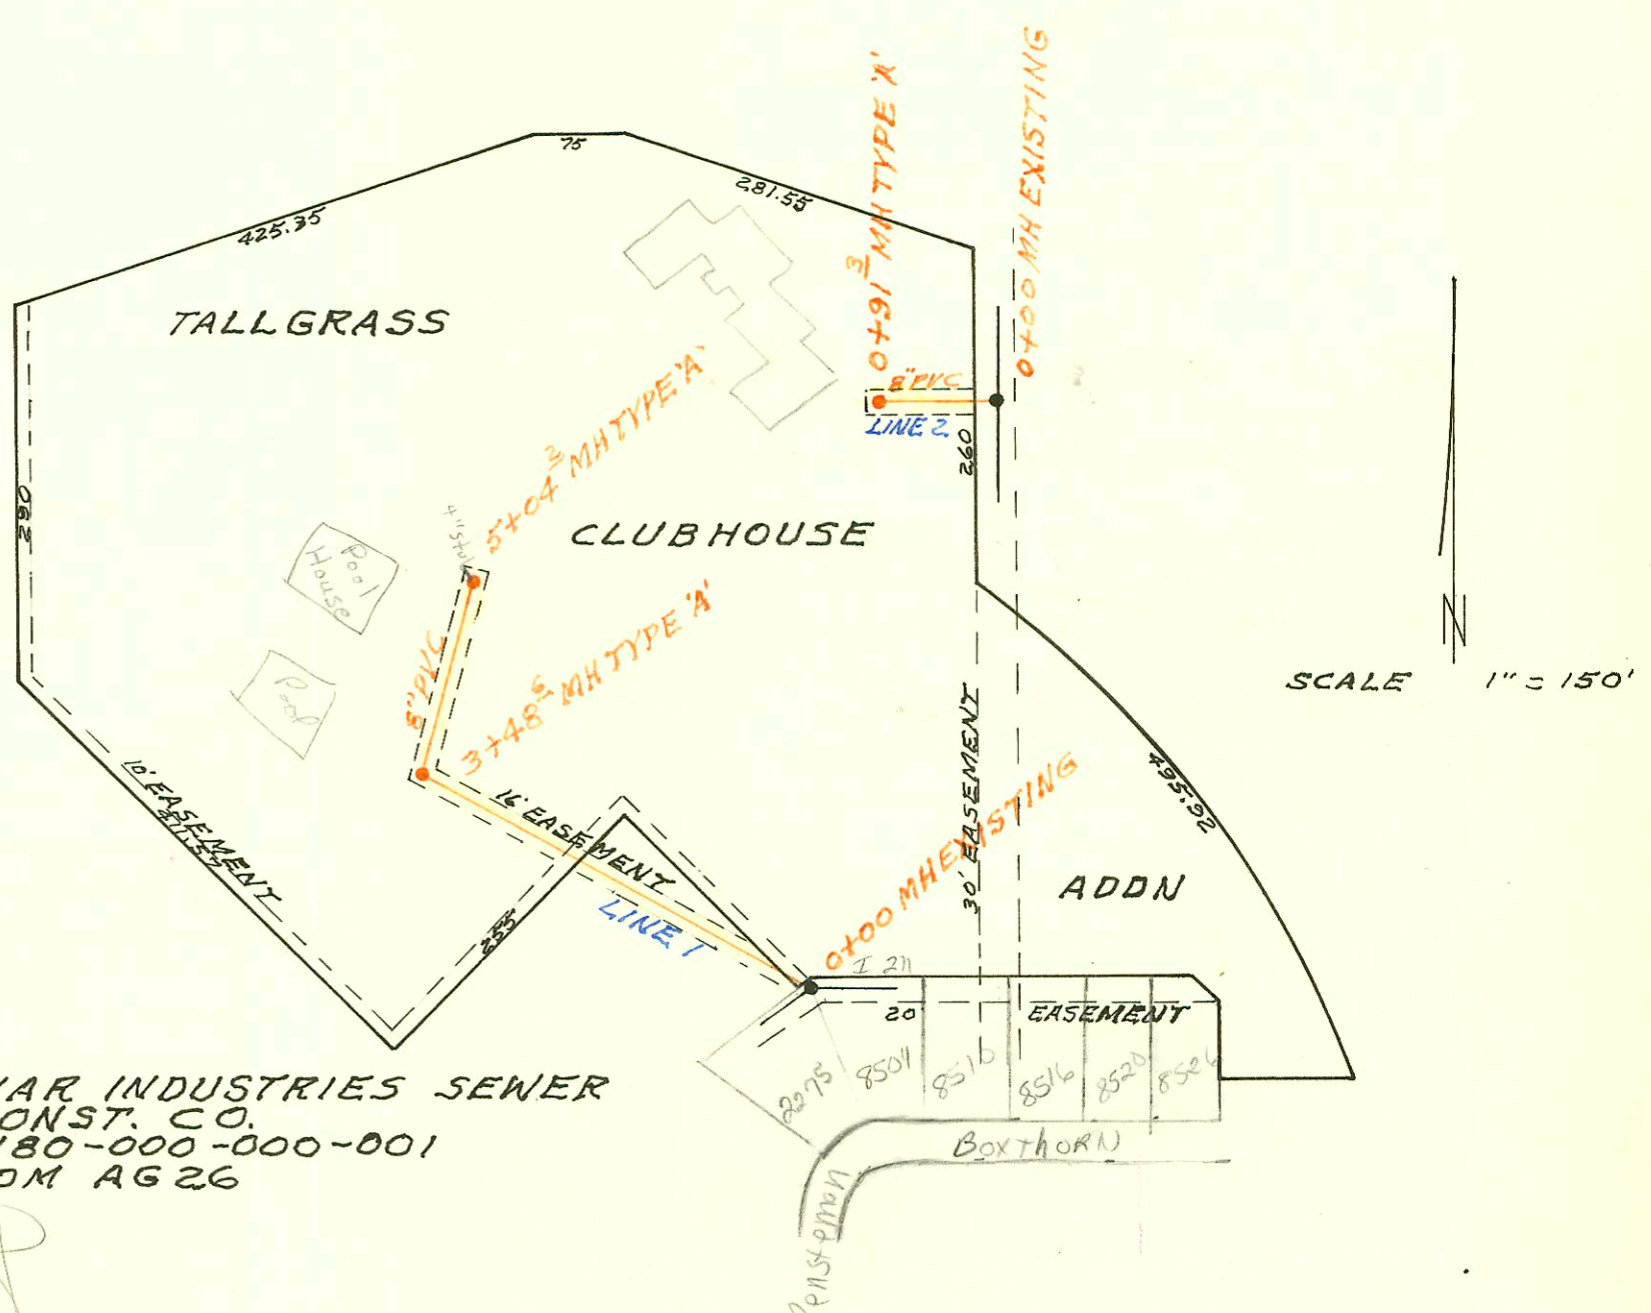
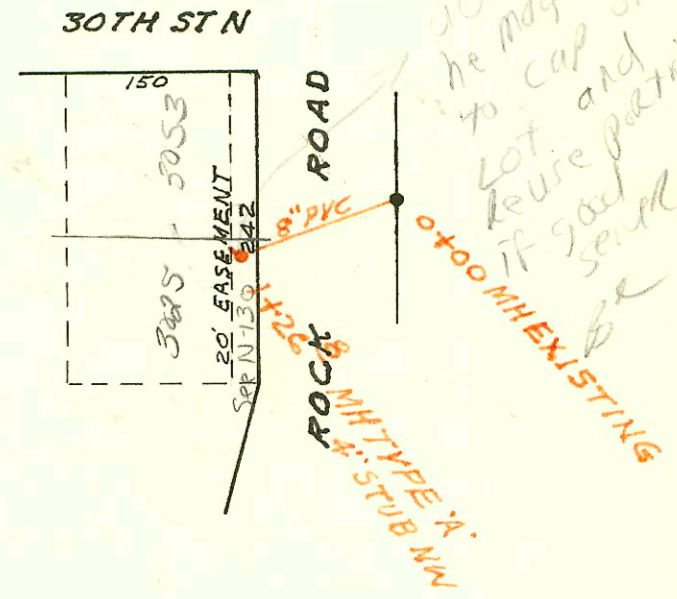


LATERAL 28 MAIN 7 SAN SEWER N^o23
BUILT BY: W.B. CARTER CONST. CO.
PROJ. N^o 468-76-245-81216-000-000-001
BOOKED 9-2-82 FROM AG 10

on map

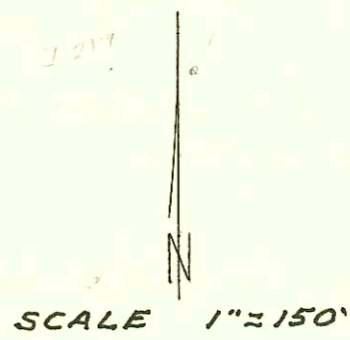


LATERAL 17 MAIN 22 WAR INDUSTRIES SEWER
BUILT BY: MID STATES CONST. CO.
PROJ. N^o 468-76-245-81180-000-000-001
BOOKED 9-8-82 FROM AG 26

on map

LATERAL 107 MAIN 4 SAN SEWER N^o23
BUILT BY: UTILITY CONTR. INC.
PROJ. N^o 468-76-245-81127-000-000-001
BOOKED 9-23-82 FROM DLK 397

on map

2-30

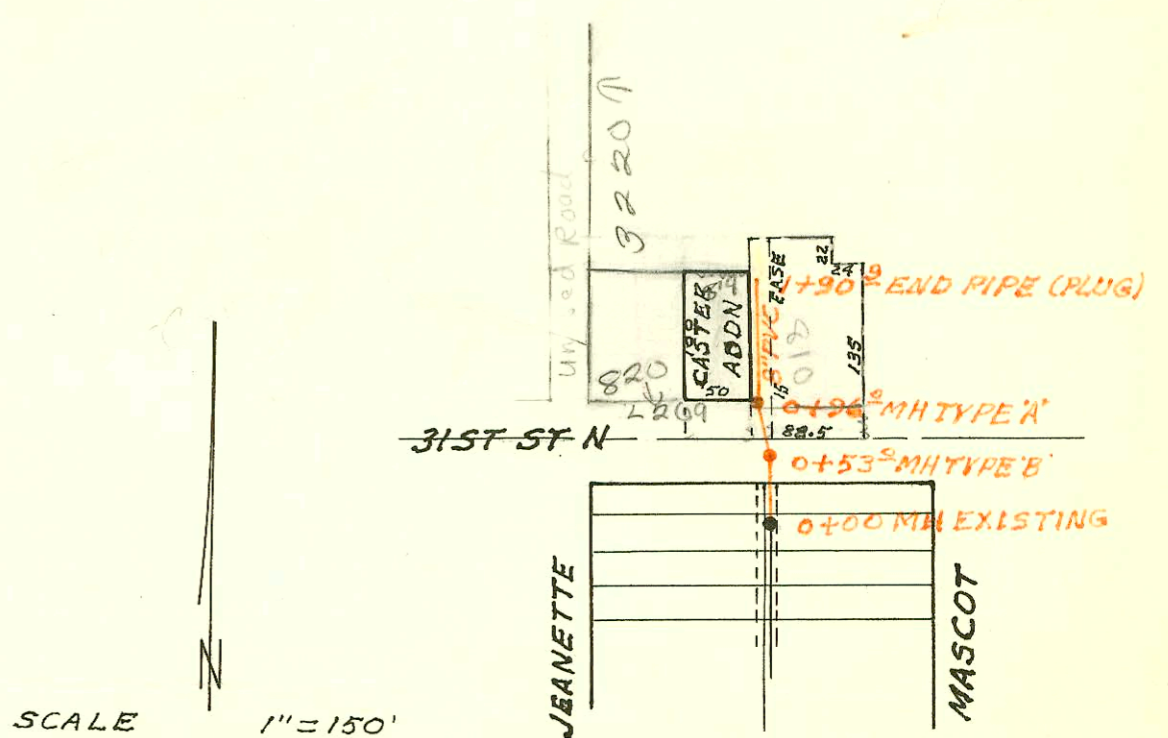

CONSTRUCTION RECORD						SERVICE RECORD						
STATION	ELEVATION		Depth	MANHOLE	4-INCH "Y" BRANCHES		No. of Permit		House Number		DATE OF PERMITS	
	Ground	Grade			North West	South East	North West	South East	North West	South East	North West	South East
LATERAL 28 MAIN 7 SAN SEWER N^o 23												
0+00	211.2	204.16	6.5	EXISTING								
1+00	210.0	204.68	5.3				765454-7		3053		4-19-82	
	209.3	204.82	4.5	1+26.8	4" STUB NW		6175		3053		7-21-82	
LATERAL 17 MAIN 22 WAR INDUSTRIES SEWER												
LINE 1 0+00	194.9	183.73	11.2	EXISTING								
1+00	196.5	185.74	10.8									
2+00	198.5	187.74	10.8									
3+00	199.4	189.75	9.7									
	201.4	190.72	10.7	3+48.6	4" stub		6110		2400 Tallgrass		7-8-82	
		190.82	10.6		3+74.6		6172		2400 Tallgrass		7-15-82	
4+00	201.6	191.81	9.8									
5+00	203.4	193.74	9.7									
	204.2	193.82	10.4	5+04.2								
LINE 2												
0+00	195.3	188.80	6.5	EXISTING								
	197.3	189.75	7.6	0+91.3								
LATERAL 107 MAIN 4 SS N^o 23												
0+00	129.6	123.84	5.8	EXISTING								
	129.0	123.96	5.0	0+53.0								
	131.1	124.13	7.0	0+96.0								
1+00	130.7	124.15	6.6									
1+90.9	131.3	124.51	6.8			1472.8	6279		810 W		8-19-82	