



LATERAL 16 MAIN 22 WAR INDUSTRIES SEWER
 BUILT BY: UTILITY CONTR. INC.
 PROJ. NO 468-76-245-81157-000-000-001
 BOOKED 10-13-82 FROM AG 15

on map

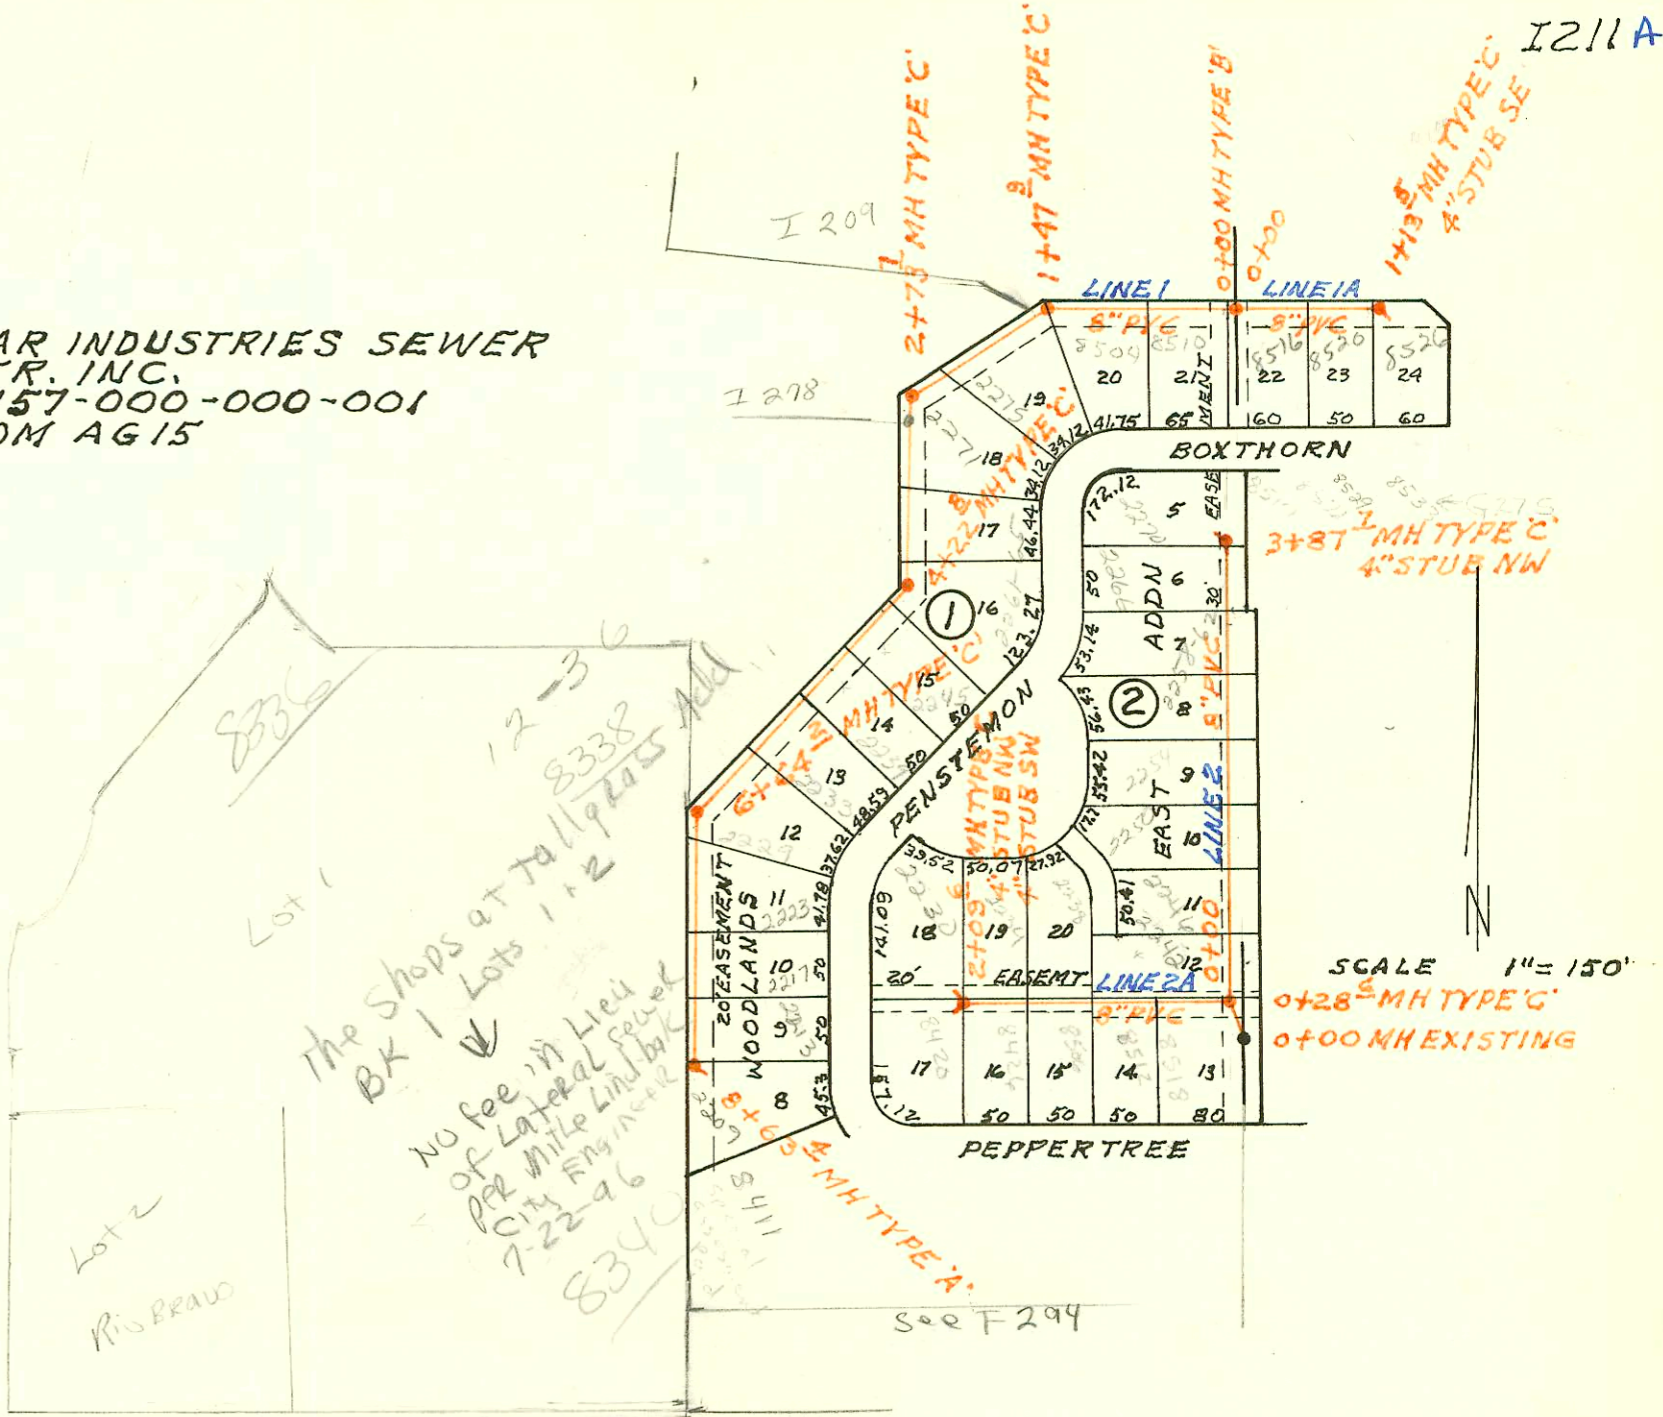

LATERAL 72 WAR INDUSTRIES SEWER
 BUILT BY: W.B. CARTER CONST. CO.
 PROJ. NO 468-76-245-81161-000-000-001
 BOOKED 10-20-82 FROM LES 20

on map

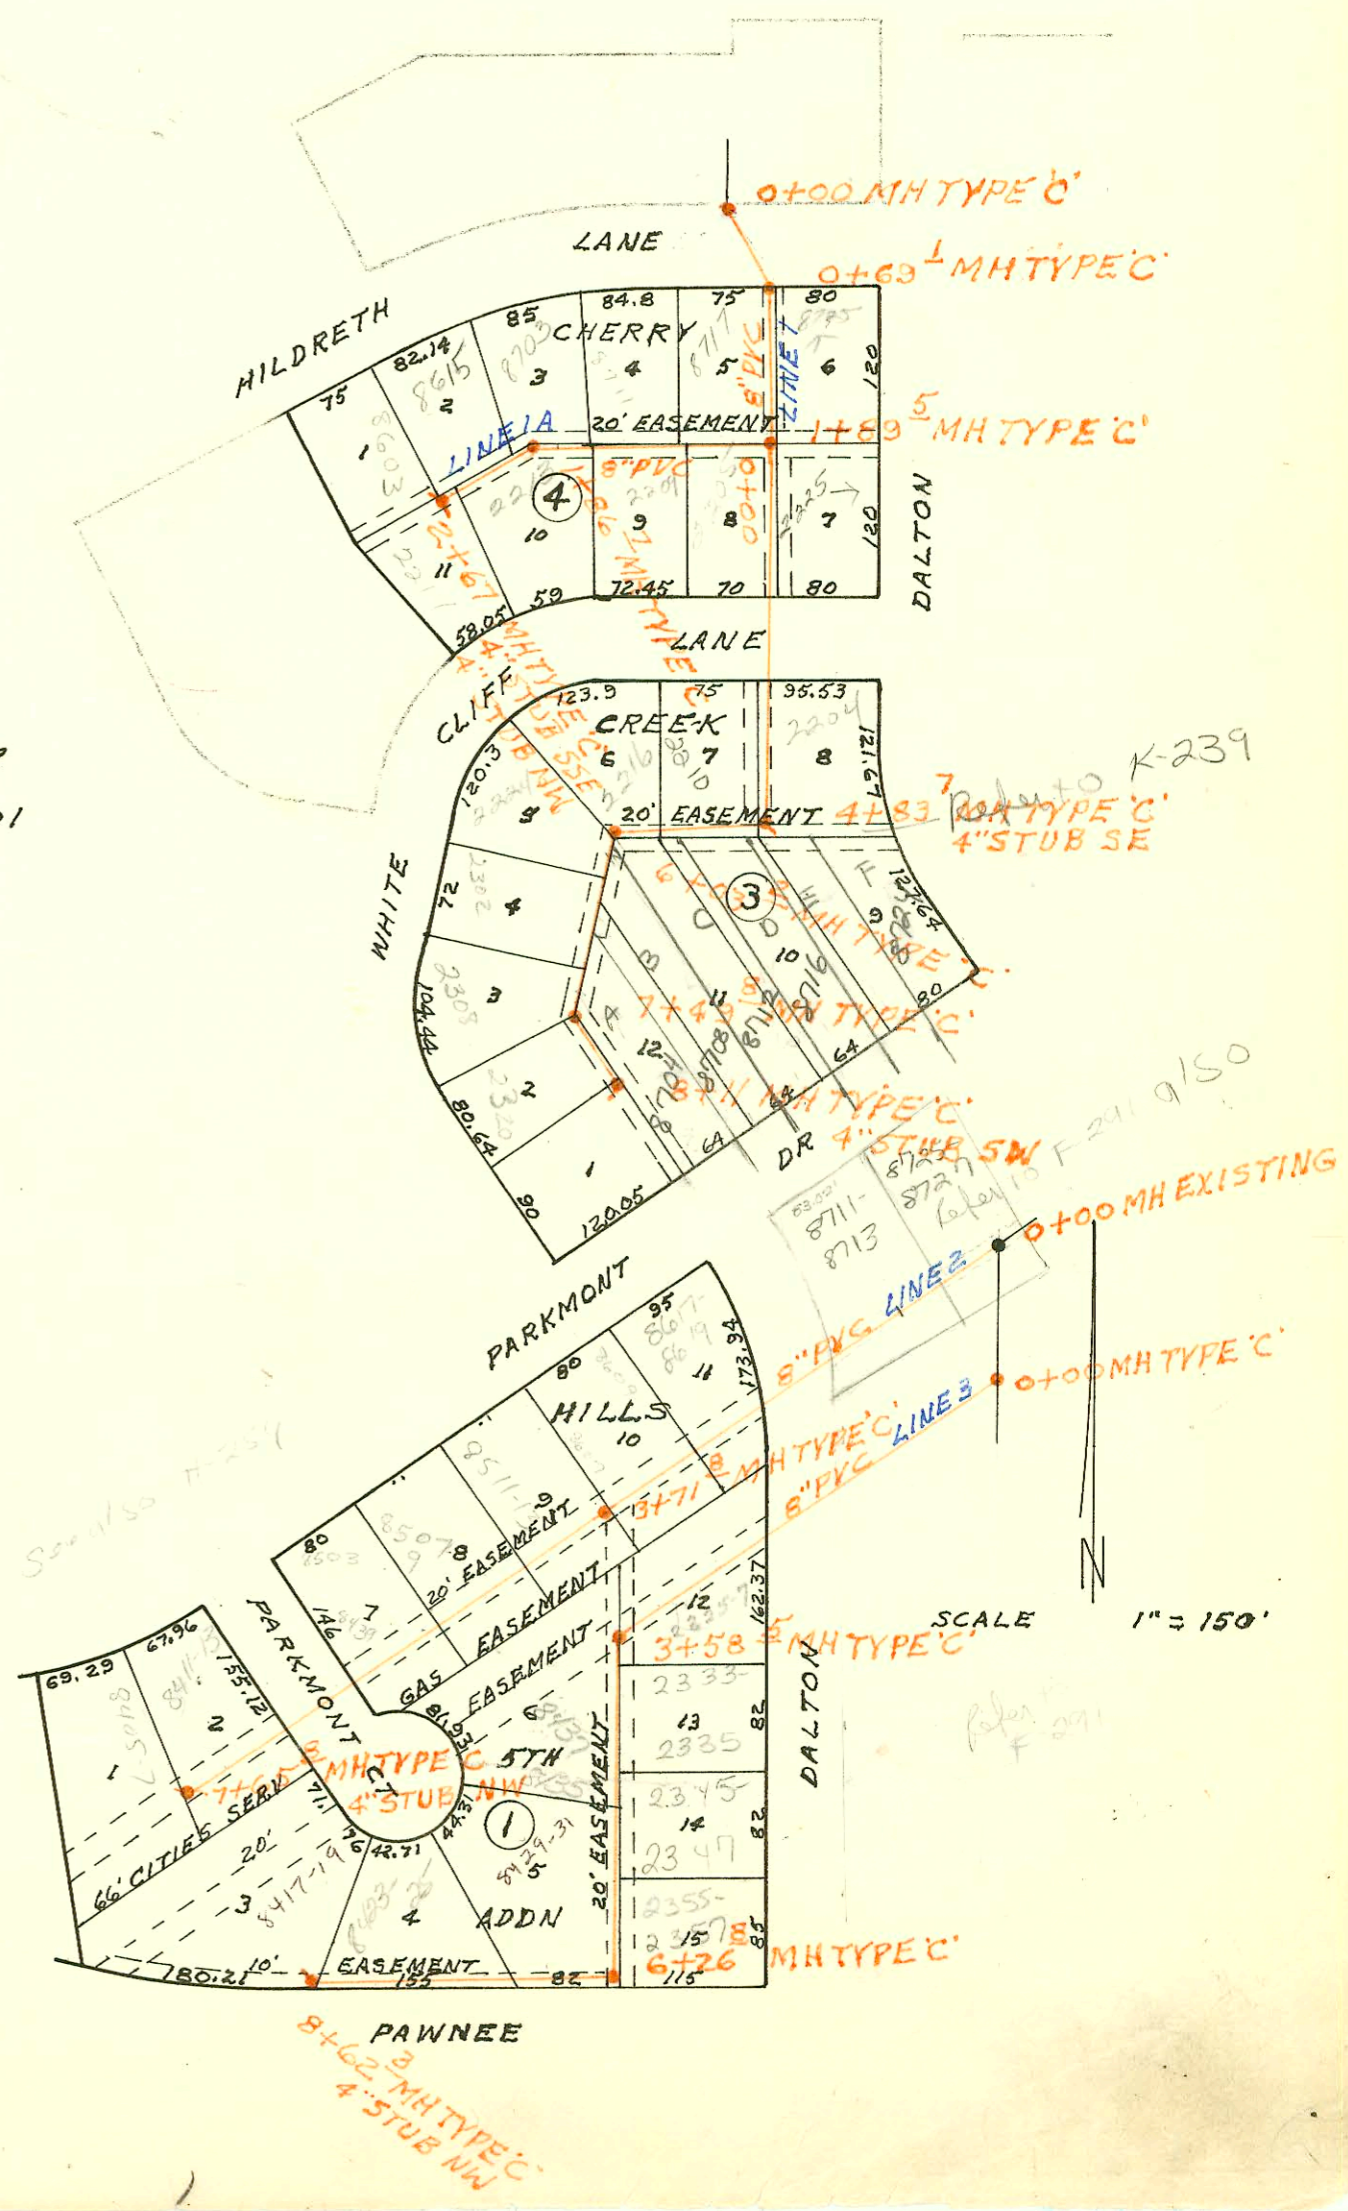

CONSTRUCTION RECORD							SERVICE RECORD					
STATION	ELEVATION		Depth	MANHOLE	4-INCH "Y" BRANCHES		No. of Permit		House Number		DATE OF PERMITS	
	Ground	Grade			North West	South East	North West	South East	North West	South East	North West	South East
LATERAL 16 MAIN 22 WIS LINE 1	0+00	194.7	181.43	13.3	0+00							
	1+00	195.0	182.03	13.0				9325	8510			9-28-83
		194.9	182.31	12.6	1+47.9			9324	8504			9-28-83
	2+00	196.7	182.60	14.1				9323	2275			9-28-83
		198.0	183.00	15.0	2+73.7			7822	2271			9-28-83
	3+00	196.8	183.33	13.5				8876	2205			8-1-83
	4+00	196.9	184.57	12.3				8875	2261			8-1-83
		197.3	184.85	12.5	4+22.8			8186	2343			5-18-83
	5+00	197.9	185.46	12.4				8185	2339			5-18-83
	6+00	199.2	186.25	13.0				8184	2253			5-18-83
		200.8	186.76	14.0	6+64.2			8183	2229			5-18-83
	7+00	200.7	187.07	13.6				7749	2223			3-23-83
	8+00	200.8	187.95	12.9				7597	2217			3-23-83
		200.8	188.51	12.3	8+63.4			7593	2213			3-4-83
								7592	2207			3-4-83
LINE 1A	0+00	194.7	181.43	13.3	0+00 = 0+00 LINE 1			9409	8516			10-2-83
	1+00	193.0	182.26	10.7				9410	8520			10-2-83
		192.6	182.37	10.2	1+13.5			8995	8522			10-2-83
LINE 2	0+00	194.5	181.79	12.7	0+00 EXISTING							
		195.5	181.88	13.6	0+28.6			8187	2240			5-18-83
	1+00	195.3	182.20	13.1				8188	2246			5-18-83
								8260	2250			5-31-83
	2+00	194.5	182.66	11.8				8261	2254			5-31-83
								8973	2252			8-1-83
	3+00	194.5	183.11	11.4				8274	2262			8-1-83
		194.4	183.51	10.9	3+87.7			9001	2266			8-17-83
								9002	2270			8-17-83
LINE 2A	0+00	195.5	181.88	13.6	0+00 = 0+28.6 LINE 2			6655	8518			10-1-80
	1+00	194.7	183.51	11.2				6654	8512			10-1-80
								7596	8506			3-4-83
	2+00	196.5	185.14	11.4				6684	8506			10-5-82
		196.9	185.30	11.6	2+09.6			6683	8506			10-5-82
								7594	8500			3-4-83
LATERAL 72 WIS LINE 1	0+00	175.7	164.89	10.8	0+00							
		175.2	165.40	9.8	0+69.1							
	1+00	175.6	165.55	10.1				10622	8717			4-13-84
		176.8	167.00	9.8	1+89.5			10484	8725			3-16-84
	2+00	176.7	167.11	9.6				8470	2225			4-24-83
	3+00	178.5	168.16	10.3								
	4+00	179.5	169.21	10.3				11027	2204			6-20-85
		180.4	170.09	10.3	4+83.7							
	5+00	181.5	170.27	11.2				2315	8716			5-7-87
								13377	2210			4-4-85
	6+00	183.0	171.36	11.6				13402	2216			4-29-88
		181.0	171.39	9.6	6+03.2			7103	2224			12-2-82
	7+00	184.1	172.08	12.0				9668	2201			11-16-83
		183.6	172.44	11.2	7+49.8			7392	2209			1-19-83
	8+00	184.5	173.47	11.0				9667	2201			11-16-83
		183.99	173.69	10.3	8+11				8704			1-25-88