


LATERAL 36 MAIN 3 SOUTHWEST INTERCEPTOR  
BUILT BY: MID STATES CONST. CO.  
PROJ. N<sup>o</sup> 468-76-245-81207-000-000-001  
BOOKED 11-10-82 FROM BR 88

on map

High water table  
in this area


SCALE 1" = 150'

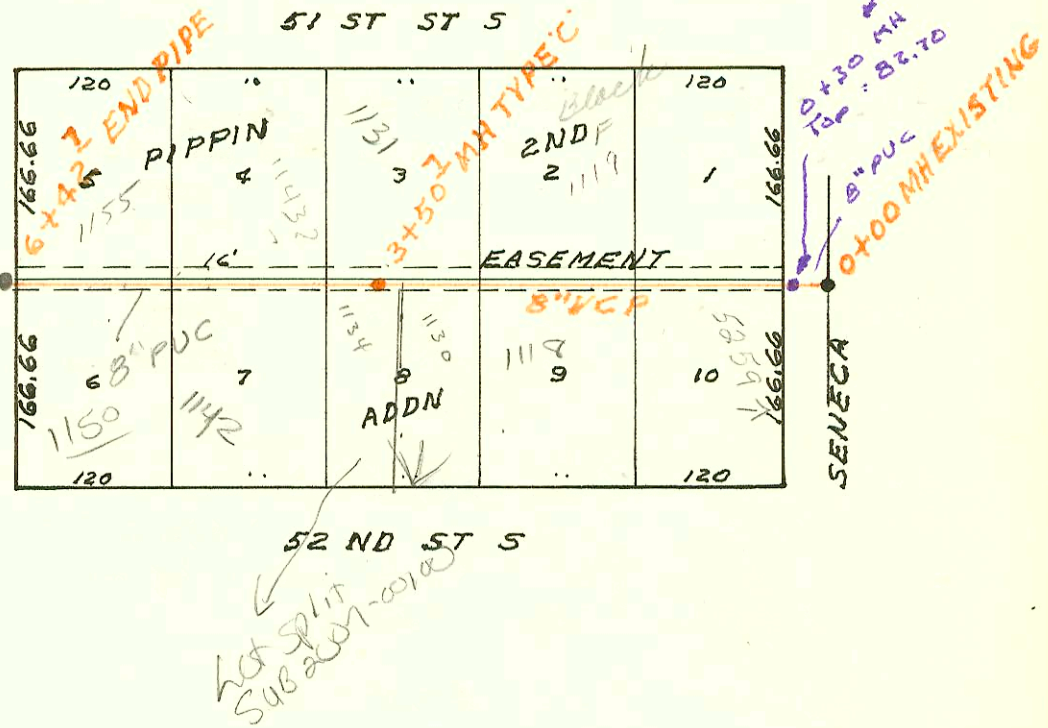

LATERAL 71 WESTLINK SEWER  
BUILT BY: W.B. CARTER CONST. CO.  
PROJ. N<sup>o</sup> 468-76-245-81231-000-000-001  
BOOKED 12-1-82 FROM DLK 392

on map

SCALE 1" = 150'

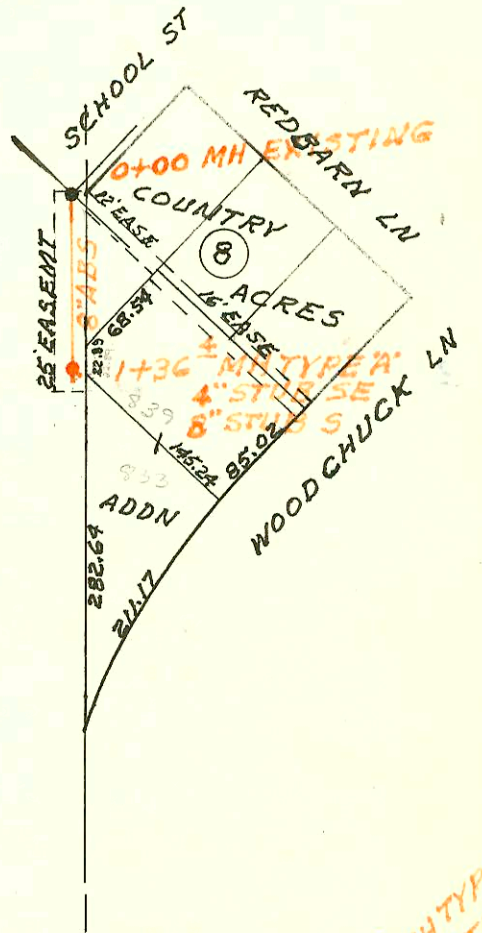


EXT. LATERAL 102 MAIN 4 SAN SEWER N<sup>o</sup> 23  
BUILT BY: CLEARWATER EXCAV. CO.  
PROJ. N<sup>o</sup> 468-76-245-81185-000-000-001  
BOOKED 12-9-82 FROM LES 33

on map

3511 Ohio  
ADK  
Sewer on  
S + Betty  
12 2 12

SCALE 1" = 150'

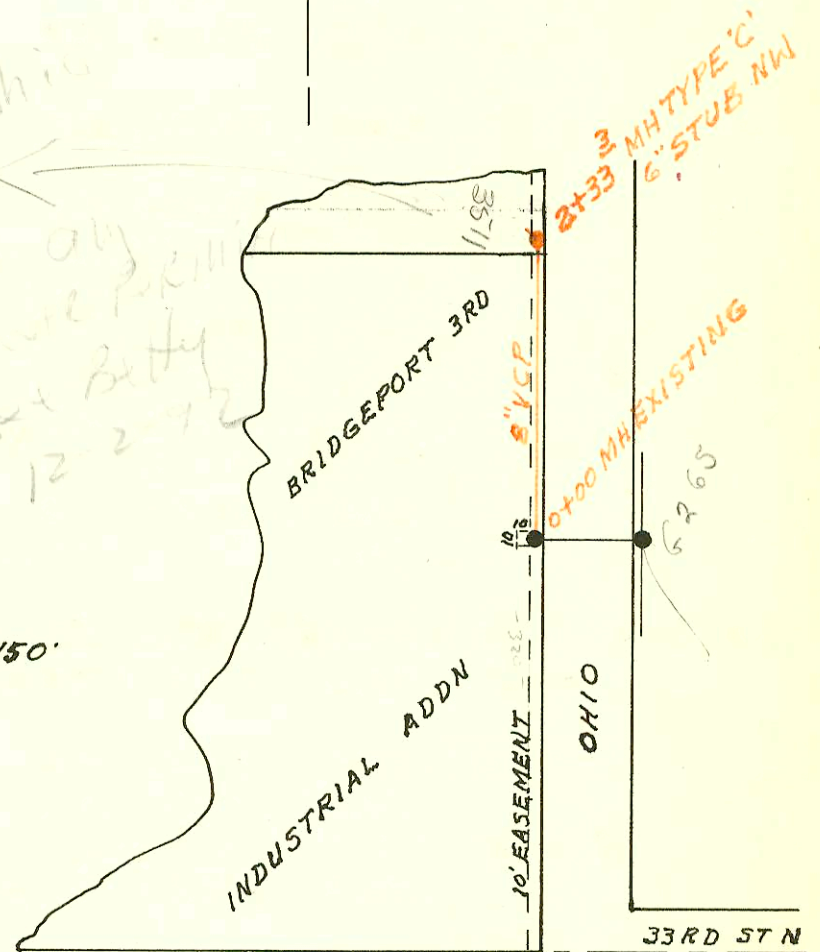

CONSTRUCTION RECORD						SERVICE RECORD						
STATION	ELEVATION		Depth	MANHOLE	4-INCH "Y" BRANCHES		No. of Permit		House Number		DATE OF PERMITS	
	Ground	Grade			North West	South East	North West	South East	North West	South East	North West	South East
LATERAL 128A SS No 22												
0+00			4.4	0+00 EXISTING								
0+17.0				BEND								
5+65				BEND								
11+40				BEND								
11+89.6				BEND								
				11+97.6								
0+00	123.0	109.82	13.2	0+00 = 11+97.6								
	122.6	110.30	12.3	0+71	mH Tap		11051		1985-7		5-30-84	
1+00	121.5	110.50	11.0									
	122.0	110.81	11.2	1+46								
2+00	121.0	111.03	10.0									
3+00	120.7	111.44	9.3									
4+00	120.6	111.84	8.8									
	121.6	111.89	9.7	4+11.2								
5+00	121.7	112.53	9.2									
	122.3	112.87	9.4	5+46.5		5+40.8 Tap	8673		1999-7		7-8-83	
						5+40.5 Tap	7545		1979-7		2-28-83	
LATERAL 36 MAIN 3 SWI												
0+00	83.0	75.01	8.0	0+00 EXISTING								
1+00	83.2	75.14	8.1			0+99 Tap	7044		5259 S		11-22-82	
2+00	83.3	75.26	8.0			4" S.C.H. 40 R.V.C. 1+93.7 N/C						
						1+07.0 TAP	18943		1119 W 52ND ST		2-24-94	2-26-87
3+00	84.0	75.39	8.6			3+20.0 Tap	7178		1130 W 52ND		12-15-82	
	84.3	75.45	8.9	3+50.7		3+37.7 Tap	13073		1131 W 51ST		2-19-85	
4+00	83.5	75.51	8.0			3+57.7 Tap	7179		1134 W 52ND		12-15-82	
5+00	84.0	75.64	8.4			4+44.2 Tap	15699		1142 W 52ND SWP		2-24-86	
6+00	83.8	75.76	8.0			5+79.2 Tap	7736		1143 W 51ST S		2-23-83	
						5+49.7 Tap	20712		1155 W 51ST S		2-8-83	5-23-88
6+42.7	83.0	75.82	7.2						1150 W 52ND S			
LATERAL 71 WESTLINK SEWER												
0+00	155.6	143.25	12.4	0+00 EXISTING								
1+00	155.3	143.82	11.5			1+11.5 Tap	7639		839 N W 52ND		3-10-83	
	155.3	144.03	11.3	1+36.4		4" STUB SE						
						8" STUB S						
EXTENSION OF LAT 102 MAIN 4 SAN SEWER No 23												
0+00	131.2	121.82	9.4	0+00 EXISTING								
1+00	131.6	122.22	9.4									
2+00	132.1	122.62	9.5									
	132.5	122.75	9.8	2+33.3		6" STUB NW	6290		8571 N 2ND		8-4-82	

\* ORG House Destroyed by FIRE. Rebuilt per Res. Permit # 93-2342-101 by homeowner. NO permit ever pulled to stop old conn or run new line. Assume homeowner Re Used old lines. 8/2/93