


LATERAL 38 MAIN 10 SAN SEWER N° 22
BUILT BY: W.B. CARTER CONST. CO.
PROJ. N° 468-76-245-80858-000-000-001
BOOKED 1-6-83 FROM BR 83

DN map
P-738
7-39

SCALE 1" = 150'


*Refer to L-135
San Sewer*

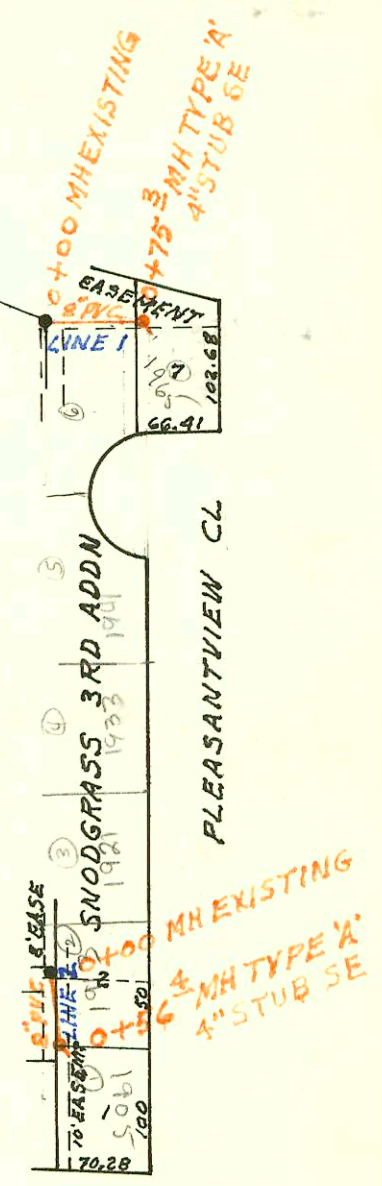

LATERAL 35 MAIN 3 SOUTHWEST INTERCEPTOR
BUILT BY: W.B. CARTER CONST. CO.
PROJ. N° 468-76-245-80035-000-000-001
BOOKED 1-10-83 FROM DRH 15

DN map

SCALE 1" = 150'

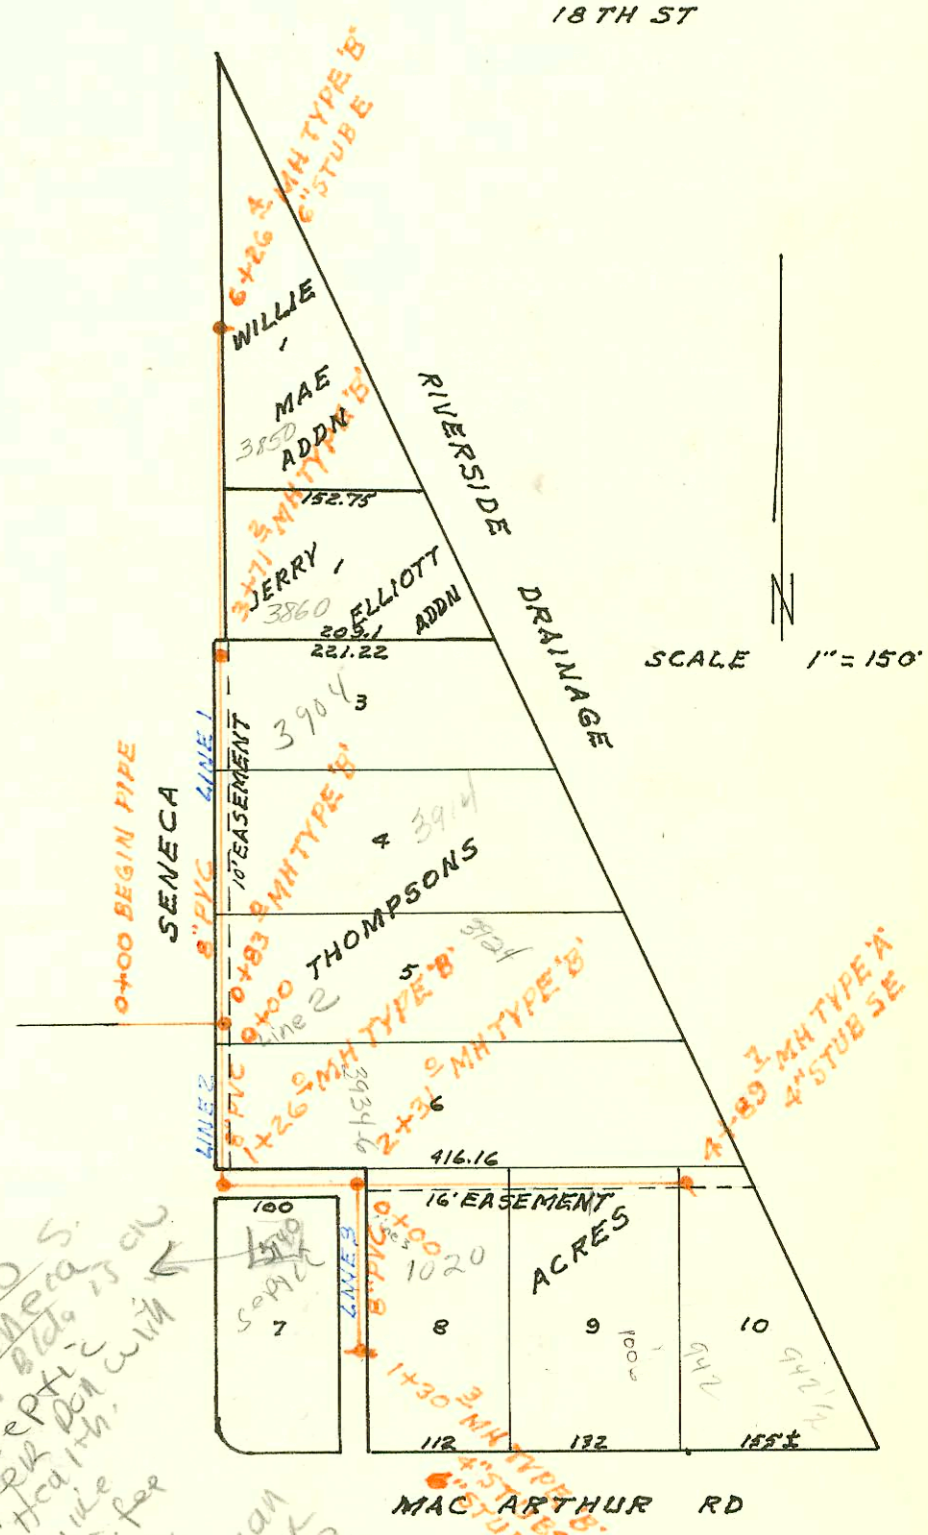


*3940 S. Seneca
3111 Bldg. is on
Prop. Dept. with
Health. require
1. require fee
paid by ac
before we can
issue sewer
perm. to
connect*

LATERAL 34 MAIN 3 SOUTHWEST INTERCEPTOR
BUILT BY: UTILITY CONTR. INC.
PROJ. N° 468-76-245-81079-000-000-001
BOOKED 1-11-83 FROM MGP 28

DN map

SCALE 1" = 150'

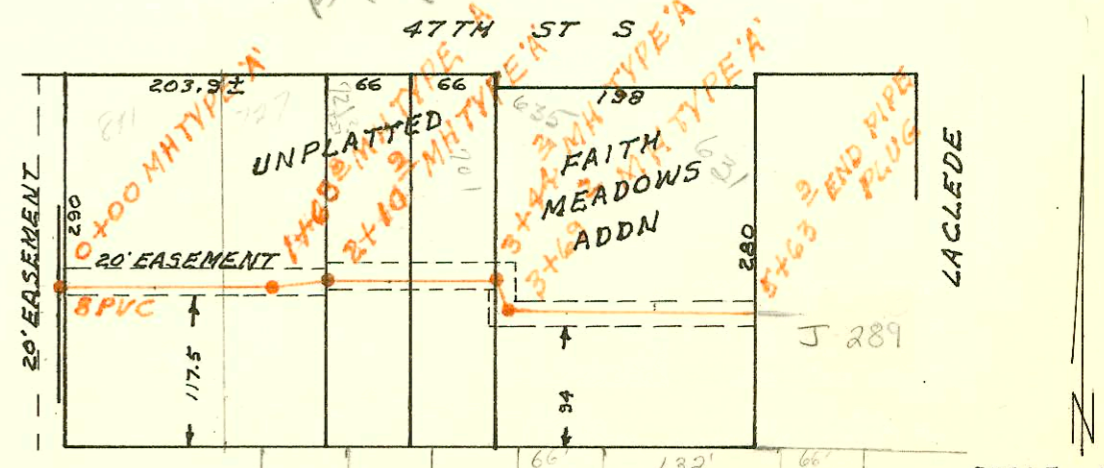

*646 642
4811 50 20*

CONSTRUCTION RECORD						SERVICE RECORD						
STATION	ELEVATION		Depth	MANHOLE	4-INCH "Y" BRANCHES		No. of Permit		House Number		DATE OF PERMITS	
	Ground	Grade			North West	South East	North West	South East	North West	South East	North West	South East
LAT 38 MAIN 10	SS N 22											
LINE 1 0+00	127.4	119.20	8.2	0+00 EXISTING								
	126.9	119.40	7.5	0+75.3	4" STUB SE		10726		1765			4-17-84
LINE 2 0+00	124.8	117.83	7.0	0+00 EXISTING								
	125.5	118.32	7.2	0+56.4	4" STUB SE		7131		1905 N			12-8-82
LAT 38 MAIN 3 SWI												
LINE 1 0+00	91.3	84.36	6.9	BEGIN PIPE								
	91.0	84.47	6.5	0+83.0	1+76.0 TAP		19376		39245			12-1-86
1+00	91.2	84.53	6.7		4" SDR 35 2+26.2		933627		3914			12-10-93
2+00	91.2	84.87	6.3		4" SDR 35 2+27.2 TAP		937446		3907			4-7-93
3+00	91.0	85.22	5.8									
	90.7	85.46	5.2	3+71.2								
4+00	90.7	85.56	5.1		3+93.5		8068		3860 S			5-5-83
5+00	90.3	85.89	4.4									
6+00	90.8	86.22	5.6									
	90.9	86.31	4.6	6+26.4	6" STUB E		2000-03538 938887		3850 S			4-21-93
LINE 2 0+00	91.0	84.55	6.5	0+00=0+83 LINE 1								
1+00	91.1	84.93	6.2									
	90.5	85.03	5.5									
		85.08	5.4	1+26								
2+00	92.2	85.28	6.9		1+94.9 TAP		17266		3934			11-10-86
	91.2	85.37	5.8	2+31.0			17267		3736			11-10-86
3+00	90.6	85.60	5.0									
4+00	90.3	85.93	4.4		4+17.4 TAP		8001		1006 W			5-2-83
	91.1	86.23	4.9	4+89.7	4" STUB SE		8590		942 W			6-29-83
LINE 3 0+00	91.2	85.42	5.8	0+00=2+31 LINE 2								
					0+81.0 TAP		15110		3958			11-25-85
1+00	90.6	85.84	4.8									
	90.0	85.97	4.0	1+30.3	4" STUB W 4" STUB E		9283	8592	3960 S	1020 W		9-26-83 6-30-83
LAT 34 MAIN 3 SWI												
0+00	87.6	78.41	9.2	0+00	0+75.5 TAP		13393		811 W			10-17-84
1+00	87.5	78.82	8.7									
	88.3	79.09	9.5	1+66.8	1+83.2 TAP		19391		907 W			10-26-87
2+00	88.4	79.22	9.2									
	88.3	79.26	9.0	2+10.9								
3+00	89.0	79.59	9.4		2+61.9 TAP		7896		721 W			4-21-83
	88.8	79.76	9.0	3+44.2	3+05.2 TAP		7561		701 W			10-31-83
	88.8	80.08	8.7	3+69.2					474 S			
4+00	87.6	80.14	7.8		4+08.7 TAP		7723		635 W			3-21-83
					4+82.2 TAP		7722		474 S			3-21-83
5+00	88.0	80.20	7.8									
5+63.9	87.7	80.44	7.3	END PIPE (PLUG)								