



LATERAL 2 MAIN 8 SOUTHWEST INTERCEPTOR
 BUILT BY: OURSLER BROS. CONST. CO.
 PROJ. N^o 468-76-245-81237-000-000-001
 BOOKED 2-7-83 FROM DRH 15

on map 5-59

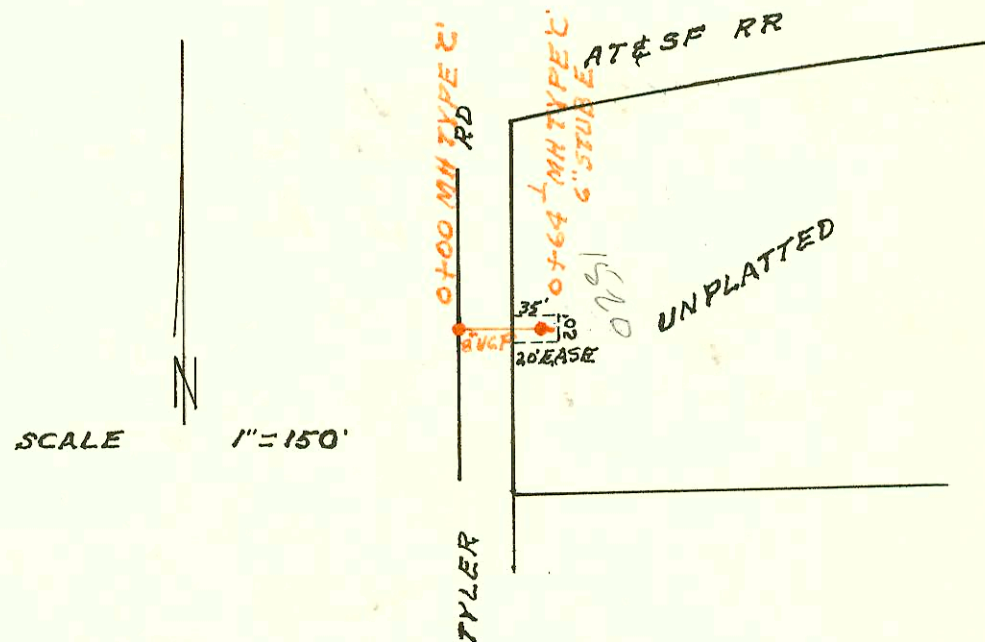


SANITARY SEWER FOR LOT 1 McLEAN PARK ADDN
 BUILT BY: TRIPLE C CONST. CO.
 PROJ. N^o 468-76-245-80000-000-000-008
 BOOKED 2-11-83 FROM TCD 52

on map 7-48

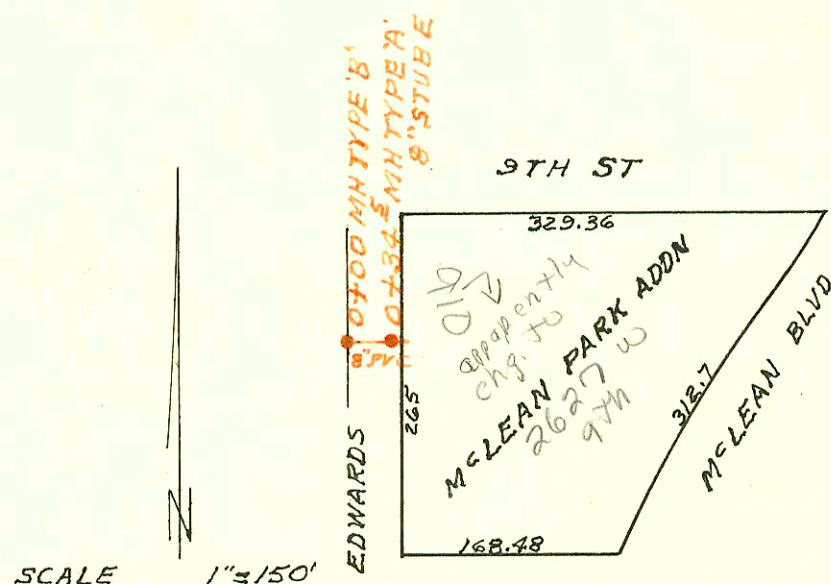

SANITARY SEWER FOR BLK 1 GARDNERS RIVERLAWN ADDN
 BUILT BY: BARNES & MORRIS
 PROJ. N^o 468-76-245-80000-000-000-008
 BOOKED 2-14-83 FROM TCD 52

on map 8-35

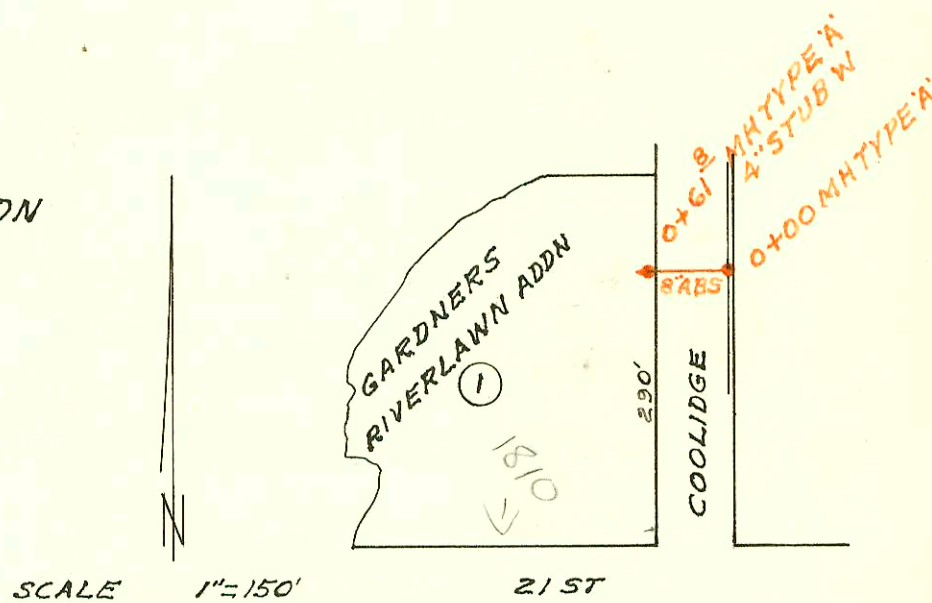

SANITARY SEWER FOR LOT 1 PARK PLAZA 3RD ADDN
 BUILT BY: MID STATES CONST. CO.
 PROJ. N^o 468-76-245-80000-000-000-008
 BOOKED 2-15-83 FROM JLA 2

on map 9-46

