

SCALE 1" = 200'


12-29

LATERAL 27 MAIN 7 SAN SEWER N^o 23
 BUILT BY: MID STATES CONST. CO.
 PROJ. N^o 468-76-245-81195-000-000-001
 BOOKED 3-3-83 FROM AG 12

MH 01-20.8 is
 to be abandoned
 per Red Lewis
 4/12/89
 BK

8/28/00
 1622 PPS
 old 35" line filled
 with flowable fill -
 line re-routed.

SCALE 1" = 150'

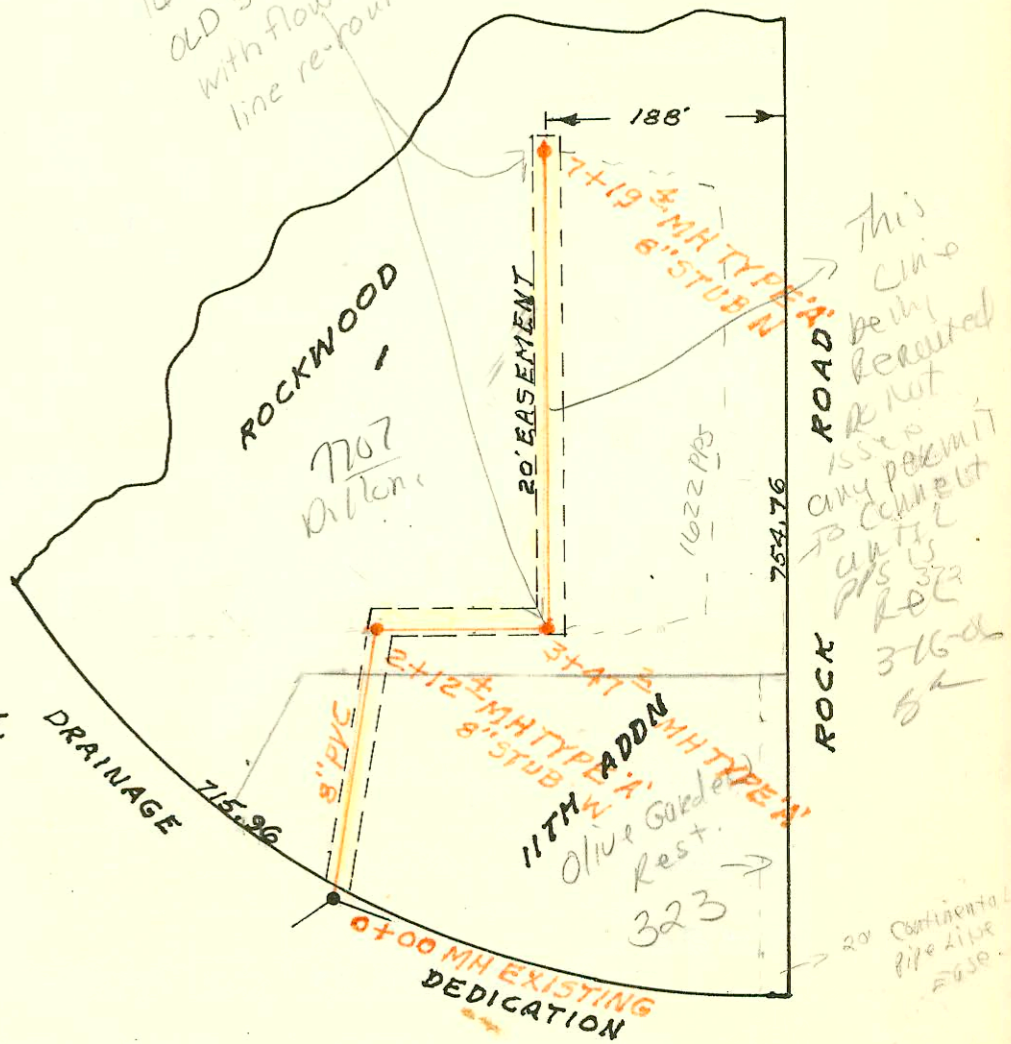

SANITARY SEWER FOR LOT 1 ROCKWOOD 11TH ADDN PHASE I
 BUILT BY: BARNES & MORRIS
 PROJ. N^o 468-76-245-80000-000-000-008
 BOOKED 3-18-83 FROM 11E

(DATA: Page 220)

12-30

20' Continental
 Pipe 21" dia
 2000'

CONSTRUCTION RECORD							SERVICE RECORD					
STATION	ELEVATION		Depth	MANHOLE	4-INCH "Y" BRANCHES		No. of Permit		House Number		DATE OF PERMITS	
	Ground	Grade			North West	South East	North West	South East	North West	South East	North West	South East
LAT LINE 1B	27 MAIN	75.5 N#23	(CONT'D)									
0+00	198.9	189.36	9.5	0+00=11+07.1 LINE 1								
	199.4	189.87	9.5	0+79.7	4" STUB NE		16066		3003-5 Kangellow		4-7-86	
LINE 1C	0+00	199.0	188.84	10.2	0+00=13+84.3 LINE 1							
	1+00	201.0	189.23	11.8				14025		3013-15 Kangellow		6-19-85
	2+00	202.2	189.62	12.6		2+46.7 2+48.4	1+77.4 9746	16814	3023 Kangellow	3017-17 Kangellow	11-30-83	8-7-86
		201.3	189.97	11.3	2+90.4	6" STUB NE 6" STUB SE	953087 94-7737		3015 Rock Rd	3005 N Rock Rd	3-16-85	5-25-84
LINE 2	0+00	200.4	189.12	11.3	0+00							
	1+00	201.3	189.59	11.7		0+23.7 0+60.7	23770	22729	17605 winter beech	17609 winter beech	8-19-89	3-15-89
		201.3	189.78	11.5	1+40.7							
		201.3	189.88	11.2								
	2+00	201.7	190.09	11.6		2+64.7 2+75.3	22910	11213	17613 winter beech	3119 Kangellow	4-12-89	6-15-84
		202.3	190.45	11.9								
		202.7	190.73	12.0	3+50.3	3+18.3	22730		17617 winter beech	3191 Kangellow	3-15-84	6-15-84
	4+00	203.8	190.95	12.9								
	5+00	203.2	191.39	11.8								
		202.4	191.51	10.9	5+28.4	5+26.9 5+29.4	10766		3117 Kangellow		4-24-84	
			191.61	10.8			10767	18134	3135 Kangellow	1709-2110 Kangellow	4-24-84	4-14-87
	6+00	203.2	192.45	10.8								
		205.2	193.61	11.6		6+60.4	22104					2-16-88
		205.7	194.20	11.5	7+50.4	7+11.4 7+19.4	10770	20152	3123 Kangellow	1716-302 25-30th	4-24-84	2-22-88
		206.2	194.81	11.4			11215	20153	3132 Kangellow	17804 Kangellow	6-15-84	2-22-88
		207.3	196.03	11.3			11216	20154	3136 Kangellow	17816 Kangellow	6-15-84	2-22-88
		208.8	196.86	11.9	9+68.3	9+13.3						
		208.8	196.96	11.8								
	10+00	208.2	197.28	10.9				17834		3111 Rock Rd		2-20-87
	11+00	208.0	198.30	9.7								
		207.6	198.90	8.7	11+59.5							
LINE 2A	0+00	201.3	191.52	9.8	0+00=1+40.7 LINE 2	0+65.0	26049	10768	3114 Kangellow	3117 Kangellow	8-29-80	4-24-84
	1+00	200.6	192.52	8.1				10769				
		200.8	192.57	8.2	1+04.9	4" PVC 40 4" STUB SW	27165		3110 Kangellow		2-26-91	
LINE 2B	0+00	208.8	196.94	11.9	0+00=9+68.3 LINE 2							
		207.8	197.43	10.4	0+59.5	4" STUB NW 6" STUB E	11217	22760	3114 Kangellow	3111 Rock Rd	6-15-84	3-21-89
LINE 3	0+00	201.5	188.05	13.5	0+00 EXISTING							
		203.7	188.40	15.3	0+27.9 EXISTING							
						4" RISER N 0+50.8	0+94.0 4" RISER S	14847	17055 Kangellow	3162 Kangellow	10-15-85	10-16-85
	1+00	204.6	189.17	15.4			19375	14851	3140 Kangellow		10-23-87	
						1+44.8 4" RISER N	1+49.8 4" RISER S	109376			17613 Kangellow	
		205.3	190.23	15.1		2+25.8 4" RISER N	2+32.0 4" RISER S	17951	19594	3154 Kangellow	3169	11-17-87
		205.7	191.11	14.6	2+82.6 EXISTING		2703.6	19947	3159 Kangellow		1-12-88	
	3+00	206.0	191.29	14.7		3+05.8 4" RISER N	3+16.0 4" RISER S	17952	19592	3148 Kangellow	3-16-87	11-17-87
						3+86.8 4" RISER N	3+59.6 4" RISER S	17953	19593	3152 Kangellow	2-16-87	11-17-87
	4+00	206.5	192.34	14.2								
	5+00	206.6	193.40	13.2								
		207.0	194.05	13.0	5+62.1 EXISTING							