



SANITARY SEWER FOR UNPLATTED TRACT
NW CORNER 45TH ST S & HYDRAULIC
BUILT BY: W.B. CARTER CONST. CO.
PROJ. N^o 468-76-245-80000-000-000-008
BOOKED 3-25-83 FROM DCD 196

on map
2-84

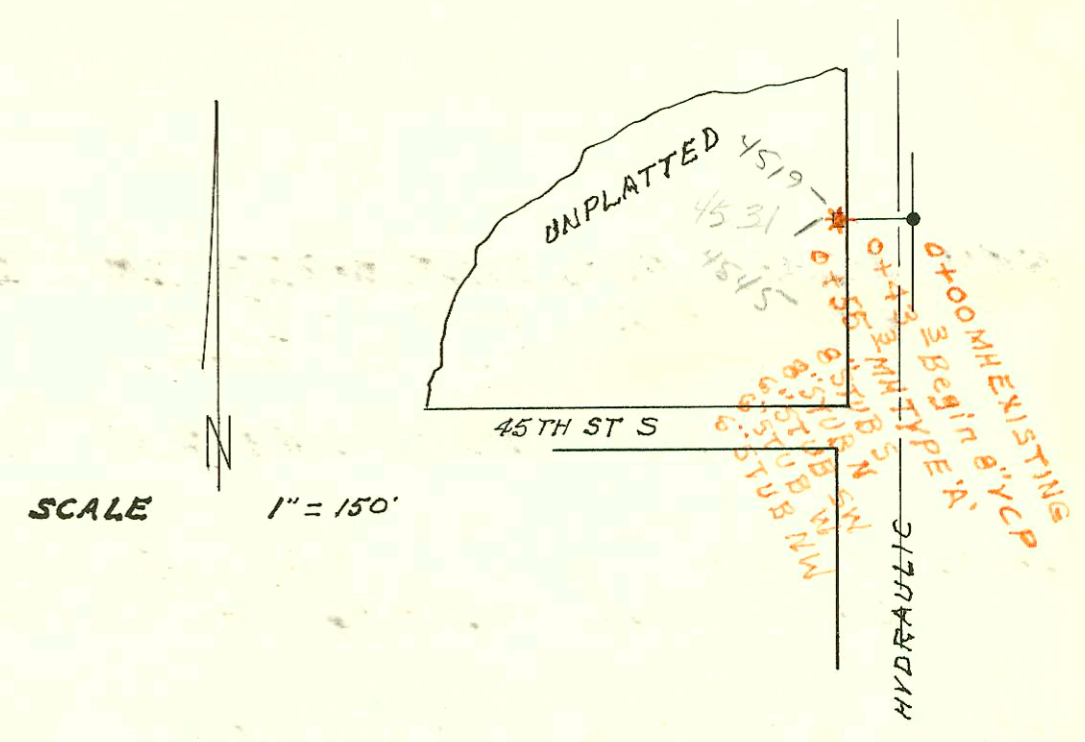


SANITARY SEWER FOR LOT 1 YOUNG ADDN
BUILT BY: W.B. CARTER CONST. CO.
PROJ. N^o 468-76-245-80000-000-000-008
BOOKED 3-28-83 FROM GG 21

on map
2-51

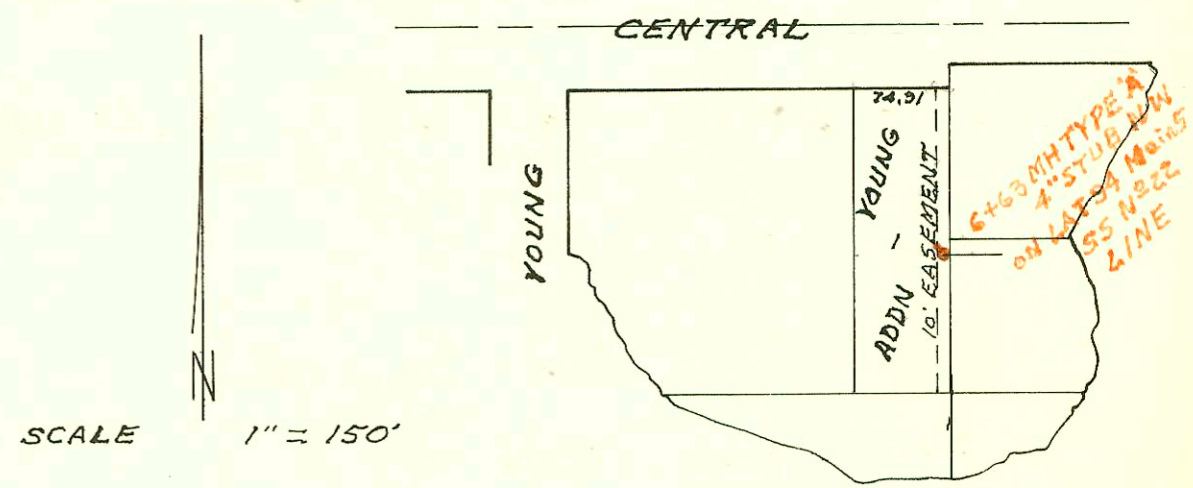

SANITARY SEWER FOR J.W. RUSSELL 1ST ADDN
BUILT BY: BARNES & MORRIS
PROJ. N^o 468-76-245-80000-000-000-008
BOOKED 3-29-83 FROM CG 21

on map
2-57

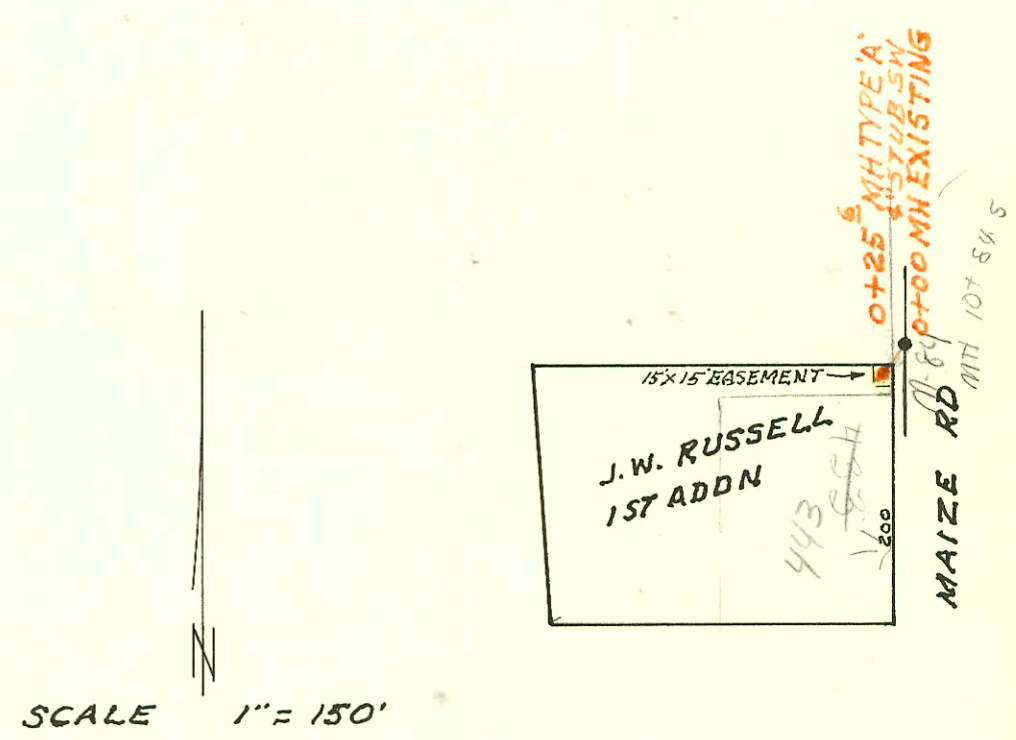

RELOC. PART OF LAT 18 MAIN 3 SWI FOR SWS N^o 193
BUILT BY: UTILITY CONTR. INC.
PROJ. N^o 468-76-245-80959-000-000-001
BOOKED 3-30-83 FROM TCD 37
(SEE PAGE D 261)

on map
2-80

