



SCALE 1"=150'

SANITARY SEWER FOR LOT 1
WESTLINK CENTER 3RD ADDN
BUILT BY: DULING CONST. CO.
PROJ. N^o 468-76-245-80000-000-000-008
BOOKED 4-7-83 FROM TCD 38

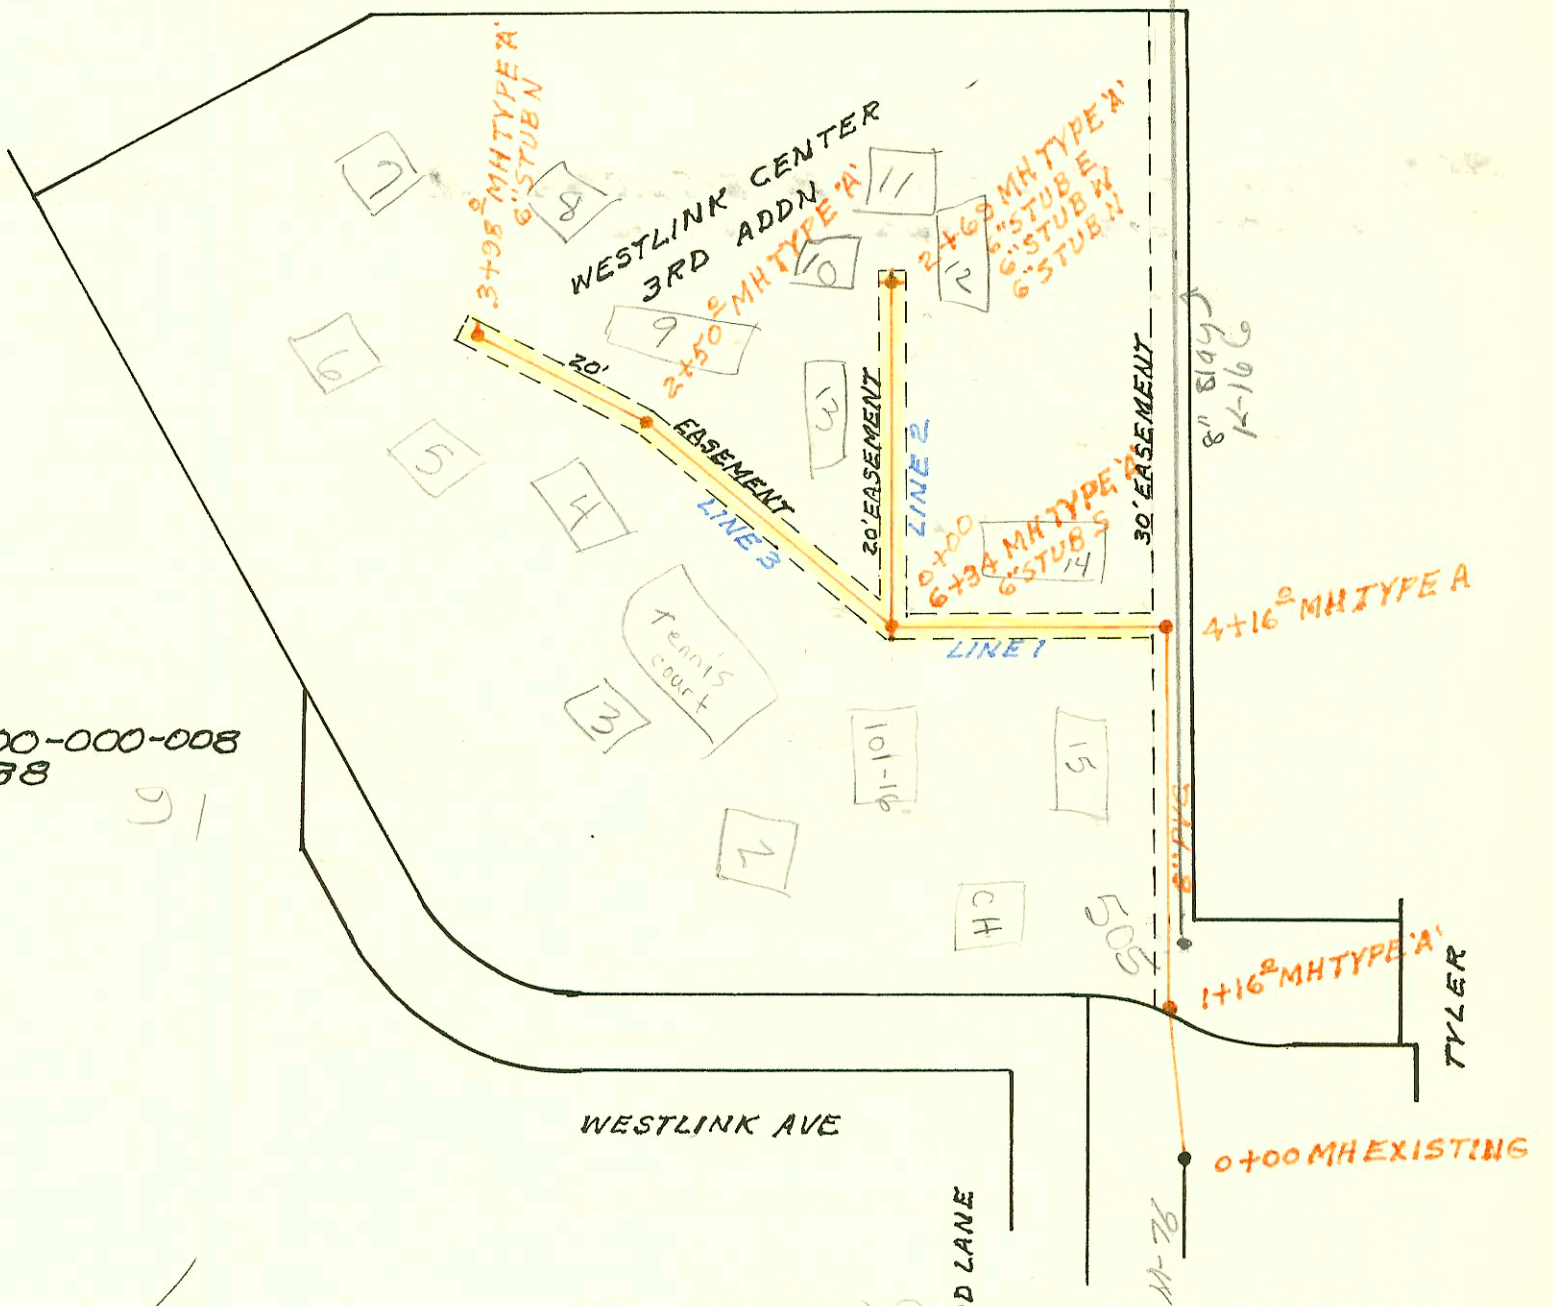


RECON PART OF SS N^o 8 IN ALLEY N OF DOUGLAS
SYCAMORE TO MCLEAN BLVD
BUILT BY: MID STATES CONST. CO.
PROJ. N^o 468-76-245-81233-000-000-001
BOOKED 4-8-83 FROM DLK 450

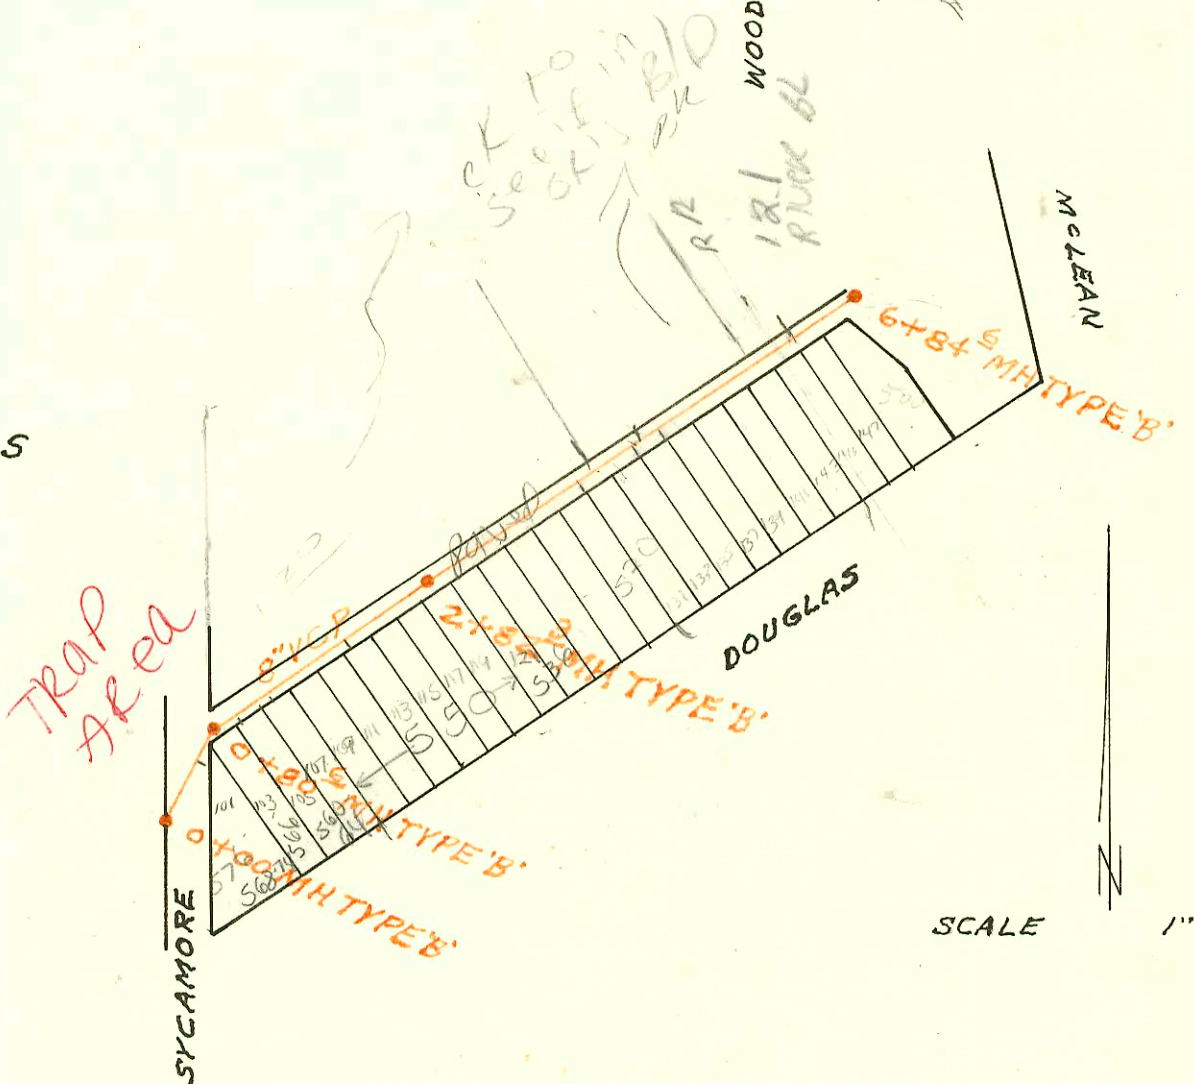

SCALE 1"=150'

SANITARY SEWER FOR LOT 6 BLK I WESTWOOD VILLAGE ADDN
BUILT BY: MID STATES CONST. CO.
PROJ. N^o 468-76-245-80000-000-000-008
BOOKED 4-14-83 FROM 13A

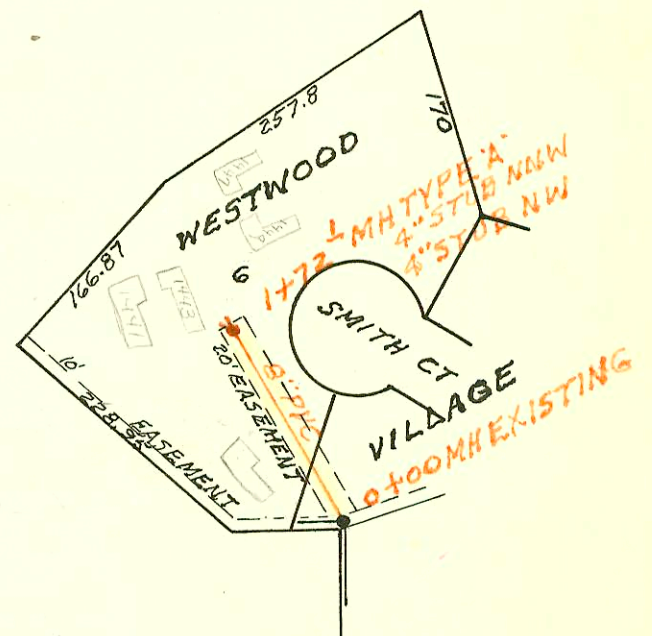

SCALE 1"=150'

