



SANITARY SEWER FOR LOTS 1 & 2 HECOX 2ND ADDN
BUILT BY: UTILITY CONTR. INC.
PROJ. NO 468-76-245-80000-000-008
BOOKED 4-19-83 FROM 13A

on map 7-58

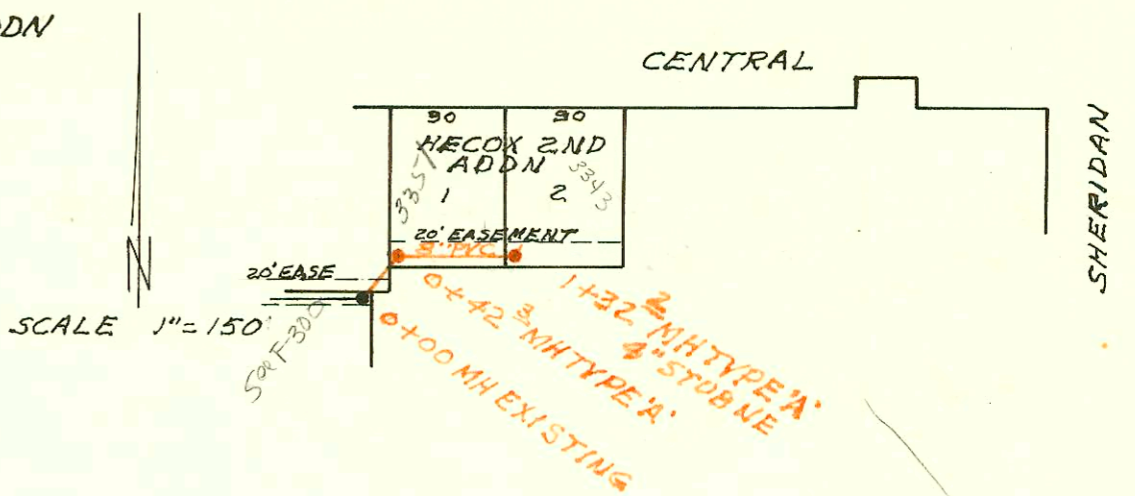


SANITARY SEWER FOR SOUTH 100' OF LOT 2, BLK A
BROWNIES 1ST ADDN
BUILT BY: BRATCHER CONST. CO.
PROJ. NO 468-76-245-80000-000-000-008
BOOKED 4-20-83 FROM JFG 201

on map 2-41

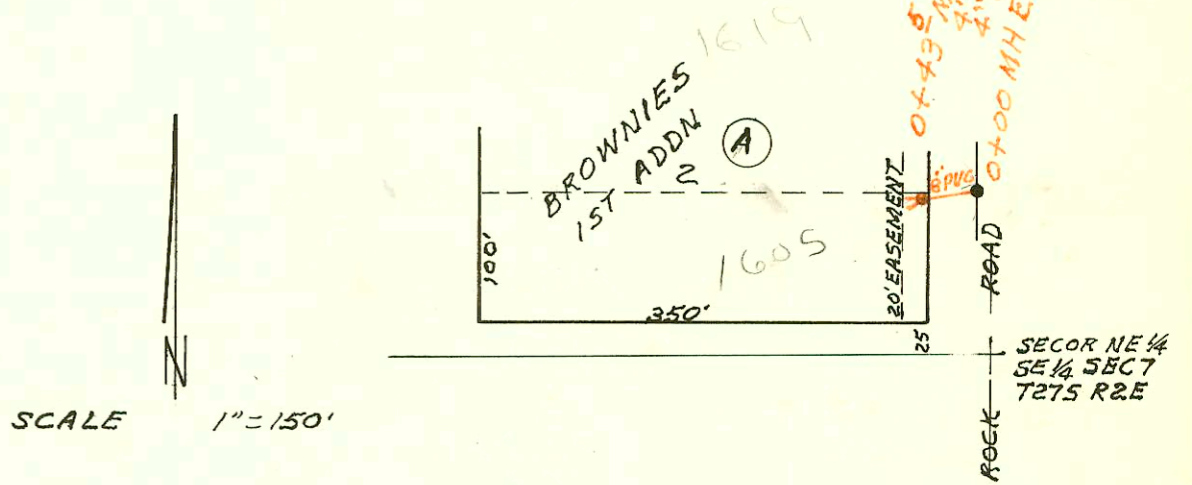


LATERAL 26 MAIN 3 SOUTHWEST INTERCEPTOR
BUILT BY: TRIPLE C OF WICHITA INC
PROJ. NO 468-76-245-80399-000-000-001
BOOKED 4-25-83 FROM DRH 18

on map

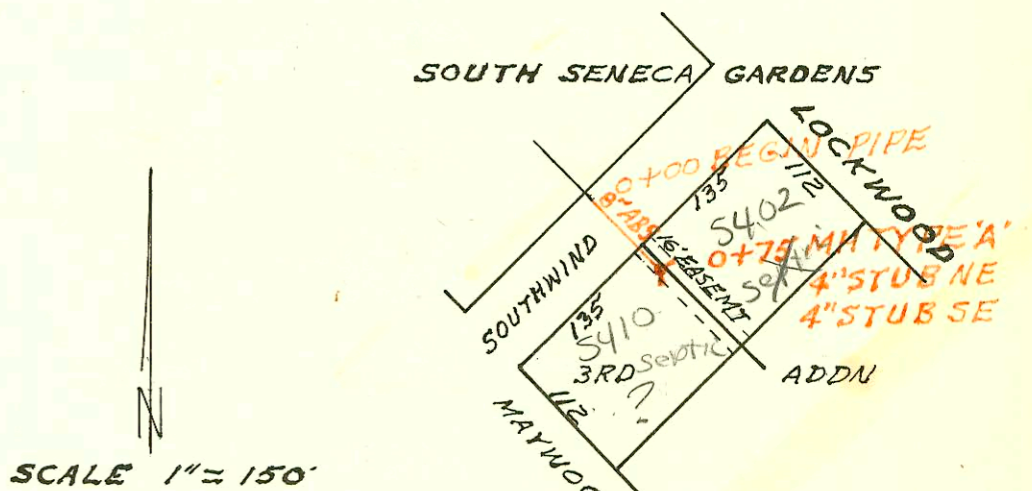

LATERAL 141 SAN SEWER NO 22
BUILT BY: UTILITY CONTR. INC.
PROJ. NO 468-76-245-81251-000-000-001
BOOKED 5-5-83 FROM DLK 369

on map 7-47

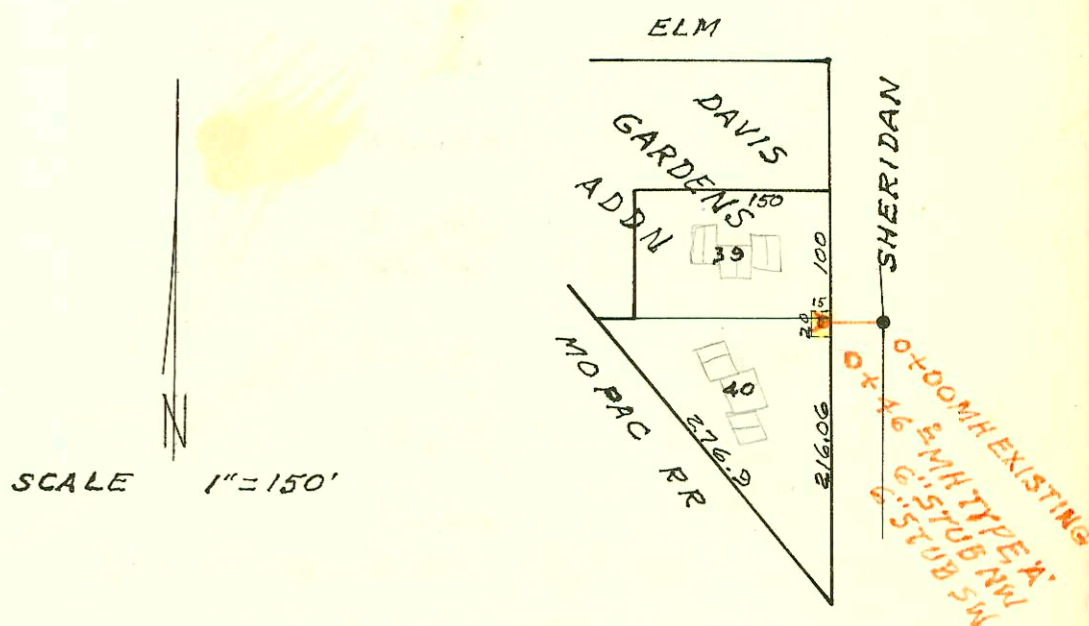

SANITARY SEWER FOR LOT 3 BLK 3
FARMINGTON SQUARE ADDN
BUILT BY: MID STATES CONST. CO.
PROJ. NO 468-76-245-80000-000-000-008
BOOKED 5-18-83 FROM JLA 2

on map 6-19

SCALE 1"=150'

CONSTRUCTION RECORD						SERVICE RECORD						
STATION	ELEVATION		Depth	MANHOLE	4-INCH "Y" BRANCHES		No. of Permit		House Number		DATE OF PERMITS	
	Ground	Grade			North West	South East	North West	South East	North West	South East	North West	South East
SAN SEWER FOR LOTS 1 & 2 HECOX 2ND ADDN												
0+00	123.3	116.40	6.9	EXISTING								
	123.3	116.56	6.7	0+42.3								
					0+49.8		15772		3351 W			3-10-86
1+00	121.3	116.84	4.5									
	121.4	117.0	4.4	1+32.4	4" STUB NE		5968		3343 W			6-7-82
SAN SEWER FOR S 100' OF LOT 2 BLK A BROWNIES 1ST ADDN												
0+00	193.3	184.46	8.9	EXISTING								
	194.5	184.86	9.6	0+43.5	4" STUB W 4" STUB SW MHTmp		197703 10268		1105 11 ROCK 1619 W 120-2-1-8			3-18-83 2-21-84
LATERAL 26 MAIN 3 SWI												
0+00	80.8	76.18	4.6	BEGIN PIPE								
	81.5	76.52	5.0	0+75	4" STUB NE 4" STUB S		7258 60040	7254 0288	5202 SOUTH W	5010 SOUTH W		1-6-03 10-21-04
LATERAL 141 SS N ^o 22												
0+00	119.0	112.61	6.4	EXISTING								
	118.9	113.07	5.8	0+46.2	6" STUB NW 6" STUB SW		8147	8149	739 400 SOUTH W	739 400 SOUTH W		5-16-83 8-16-83
SAN SEWER FOR LOT 3 BLK 3 FARMINGTON SQUARE												
0+00	136.1	127.29	8.8	0+00	0+35.6		7269		6747 200 SOUTH W			12-29-82
					0+87.9	0+64.8	7267	7270	6747 100 SOUTH W	6747 400 SOUTH W		12-29-82 12-29-82
1+00	136.1	127.73	8.4									
					1+58.6	1+71.1	7268	7271	6747 200 SOUTH W	6747 500 SOUTH W		12-29-82 12-29-82
2+00	135.6	128.17	7.4									
						2+94.5		7272	6747 600 SOUTH W	600+1000		12-29-82
3+00	135.3	128.61	6.7									
	135.6	128.97	6.6	3+80.4	4" STUB E							
4+00	135.4	129.05	6.4									
					4+04.4	4+46.7	7279	7275	1500+1600	1100		12-29-82 12-29-82
						4+66.5		7276	6747 SOUTH W	600+1200		12-29-82
5+00	136.2	129.45	6.8									
	136.6	129.67	6.9	5+56.6	4" STUB E		7278	7277	6747 1400+1700 SOUTH W	6747 1300 SOUTH W		12-29-82 12-29-82
SAN SEWER FOR PARK MEADOW STATES LAT SEWER DISTRICT												
LINE 1 0+00	156.42	139.90	16.5	0+00								
1+00		140.02										
2+00		140.14										
	154.6	140.17	14.4	2+23								
3+00		140.21										
4+00		140.27										
	154.5	140.30	14.2	4+46								
5+00		140.40										
6+00		140.59										
7+00		140.77										
	154.7	140.89	13.8	7+61.7								
8+00		140.92										
9+00		140.99										
10+00		141.06										
	154.0	141.08	12.9	10+34								
11+00		141.20										
	153.4	141.23	12.2	11+17.7								
12+00		141.37										