


As Built's in
System Planning.
However, Bill said
we can use this drawings.
Just compare it with
Arc view

SCALE 1" = 300'

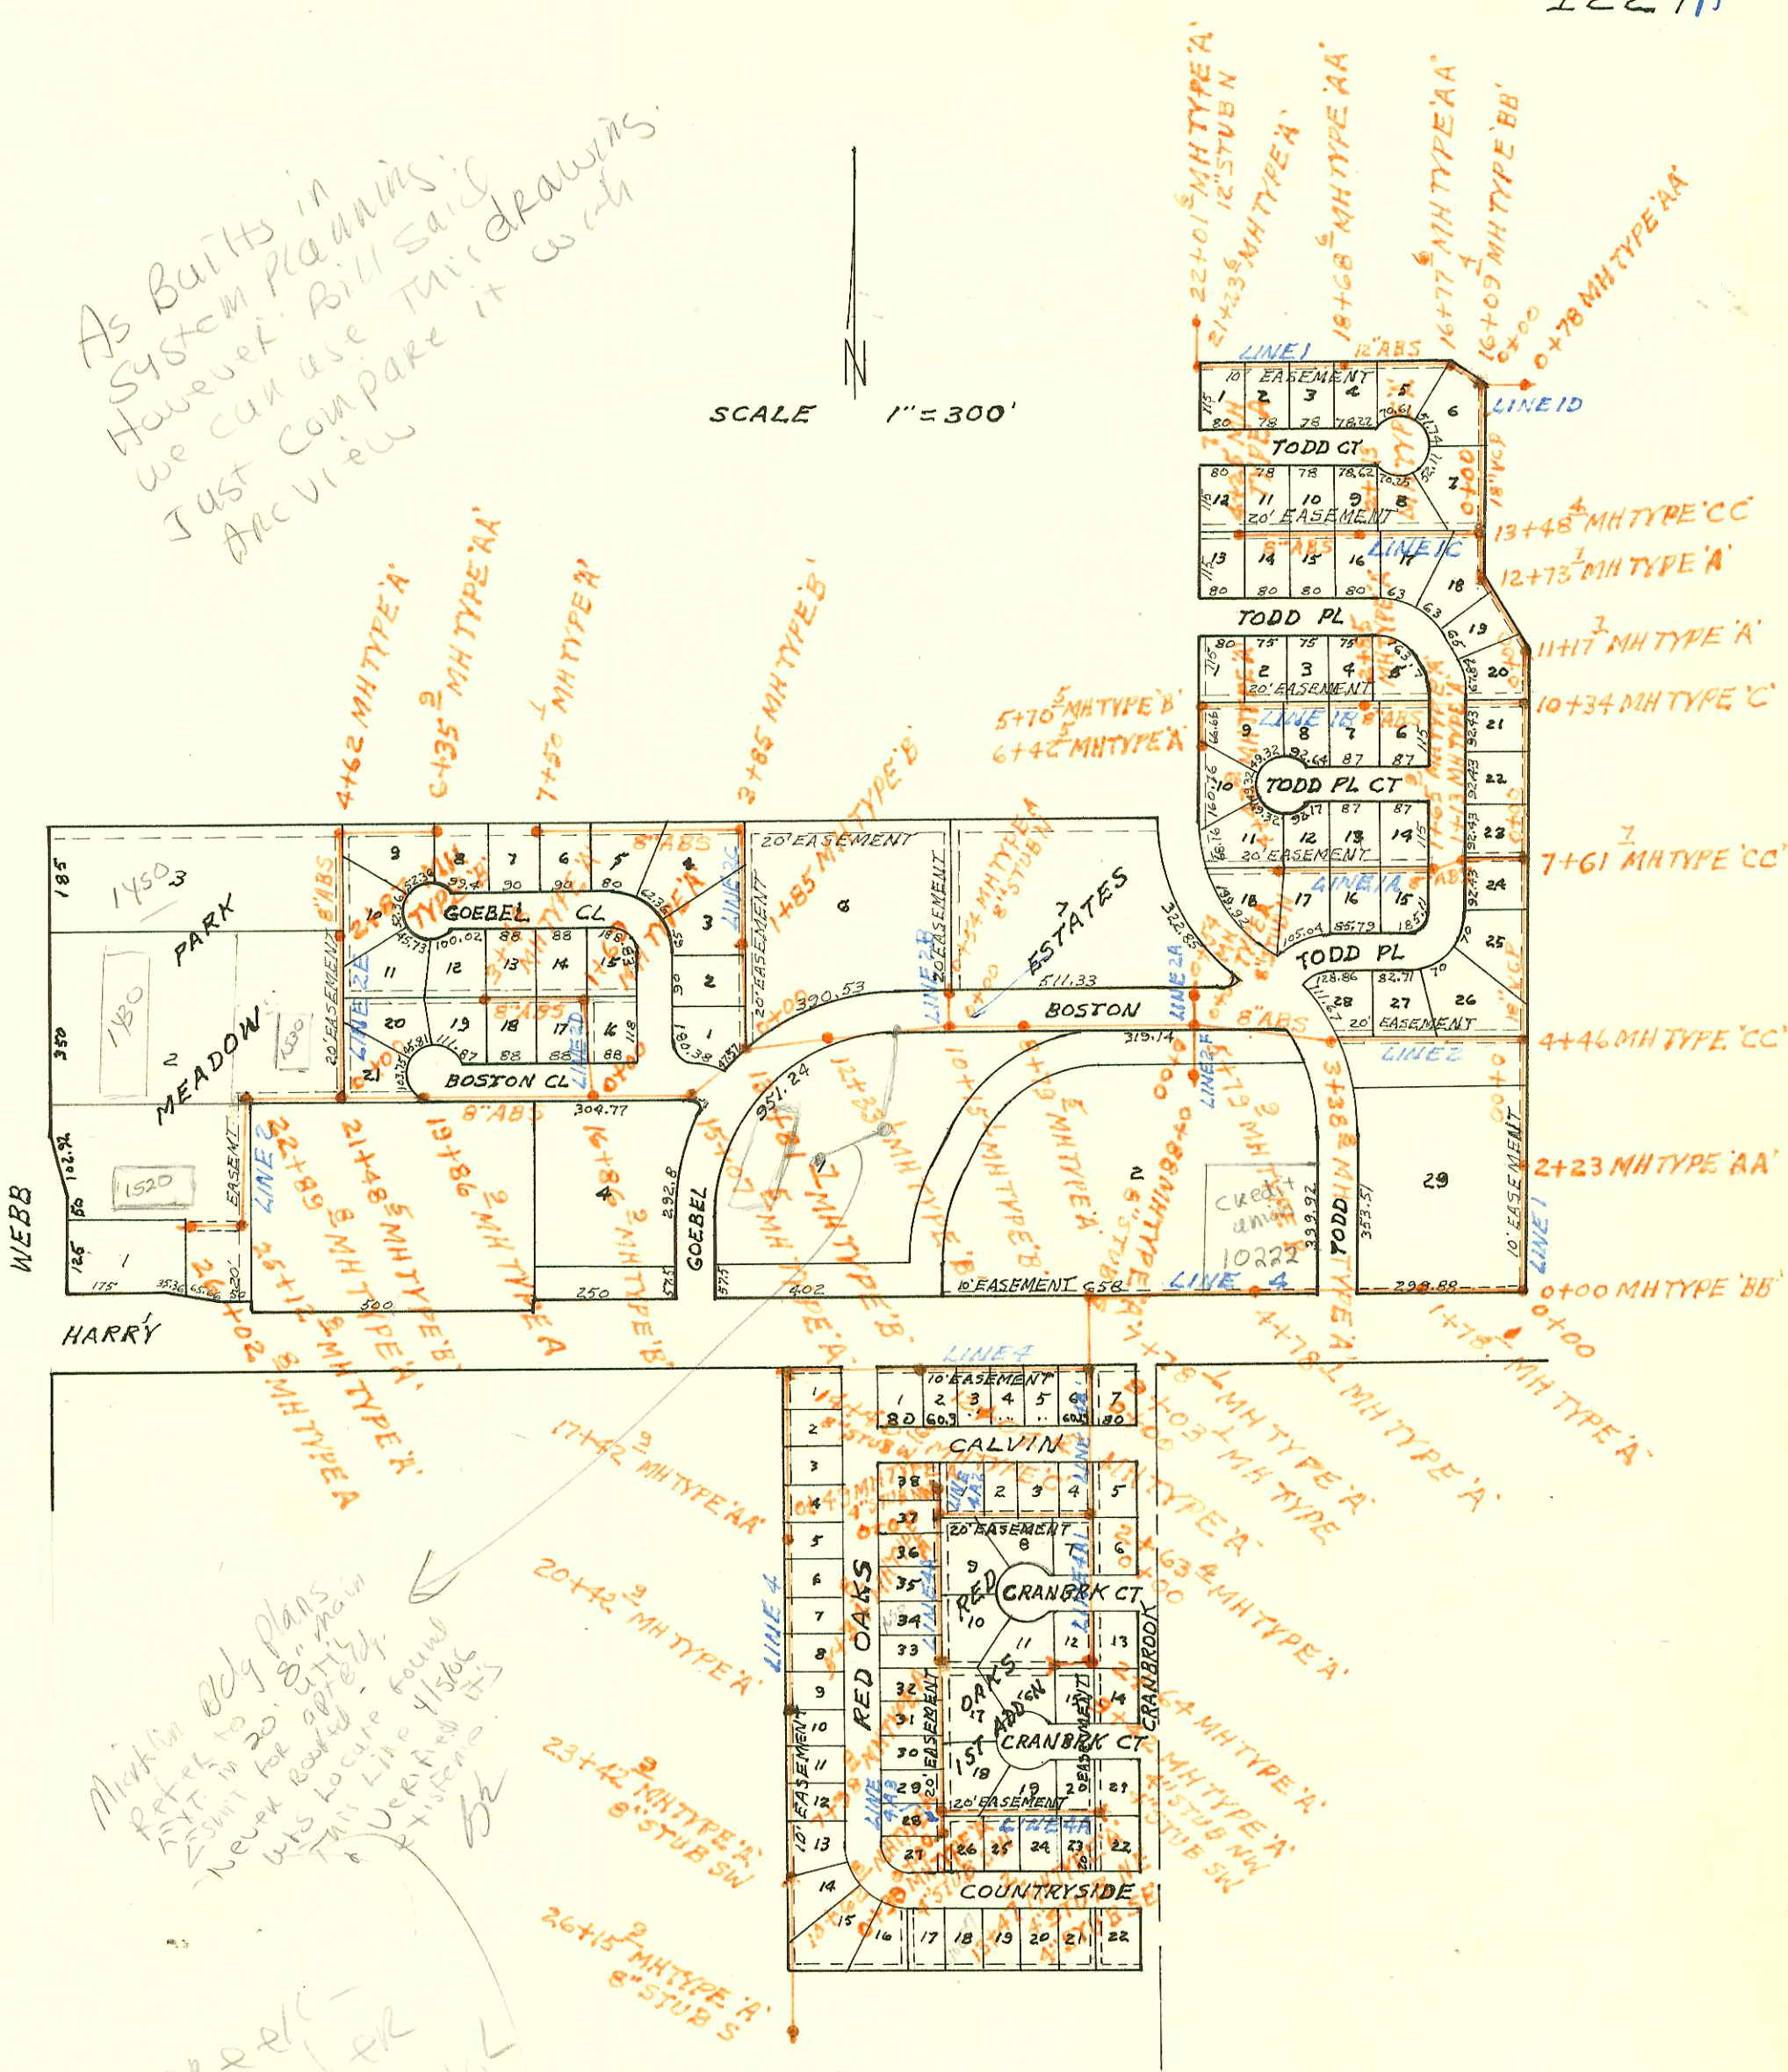

Marked by plans
Refer to 20' or main
25' SWM for apt. bldg.
Never located found
this location found
Verify 4' slope
+ systems
bz

4 mile creek -
now under
City Control
4/1/01
BK


SANITARY SEWER FOR PARK MEADOW ESTATES
LATERAL SEWER DISTRICT
BUILT BY: (IN COUNTY)
PROJ. NO 30-76496-024 & NO 30-76496-4-024
BOOKED 7-27-83 FROM 'AS BUILT' PLANS
PHASE 1A & 2A

~~Do not Issue Permits for Sewer~~
~~see Sedy. County for Comm~~
~~Permits~~
call County
268-7951
DRB
8-4-83

4-mile creek

CONSTRUCTION RECORD						SERVICE RECORD						
STATION	ELEVATION		Depth	MANHOLE	4-INCH "Y" BRANCHES		No. of Permit		House Number		DATE OF PERMITS	
	Ground	Grade			North West	South East	North West	South East	North West	South East	North West	South East
SAN SEWER PARK MEADOW ESTATES LAT SEWER DIST (CONT'D)												
LINE 1C CONT'D	3+00	148.68										
	4+00	149.95										
LINE 1D	0+00	158.2	8.6	4+25.7								
		158.2	15.6	0+00=16+03.4								
		160.0	17.2	0+78		10" STUB E						
LINE 2	0+00	154.5	10.0	0+00=4+46								
	1+00	145.55										
	2+00	146.59										
	3+00	147.64										
		157.9	9.9	3+38.8								
		148.09	9.8									
	4+00	148.34										
	5+00	148.75										
		160.1	11.0	5+79.9								
	6+00	149.15										
	7+00	149.54										
	8+00	149.92										
		159.2	9.0	8+79.5								
	9+00	150.31										
	10+00	150.72										
		161.6	10.8	10+15.1								
	11+00	151.10										
	12+00	151.48										
		164.8	13.2	12+33.1								
		151.61	10.8									
		154.03										
	13+00	154.31										
		165.7	11.0	13+81.7								
		154.66	10.9									
		154.76										
	14+00	154.81										
	15+00	155.09										
		165.5	10.4	15+07.5								
		153.71	10.1									
		153.44										
	16+00	155.99										
		166.6	10.1	16+86.9								
		156.81	9.9									
		156.66										
	17+00	156.71										
	18+00	157.12										
	19+00	157.52										
		168.8	10.9	19+86.9								
		157.87										
	20+00	157.91										
	21+00	158.19										
		167.5	9.2	21+48.5								
		158.33	9.1									
		158.38										
	22+00	158.66										
		169.2	10.1	22+89.8								
		159.43	10.1									
		159.14										
	23+00	159.18										
	24+00	159.58										
	25+00	159.98										
		167.3	7.3	25+12.8								
		160.03	6.9									
		160.42										

2004 00969 1530 Webb 4-8-04

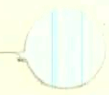

Handwritten mark or signature at the bottom left corner.