
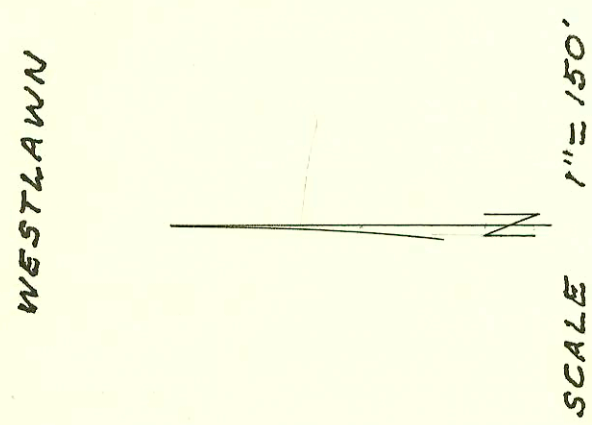


TYLER RD

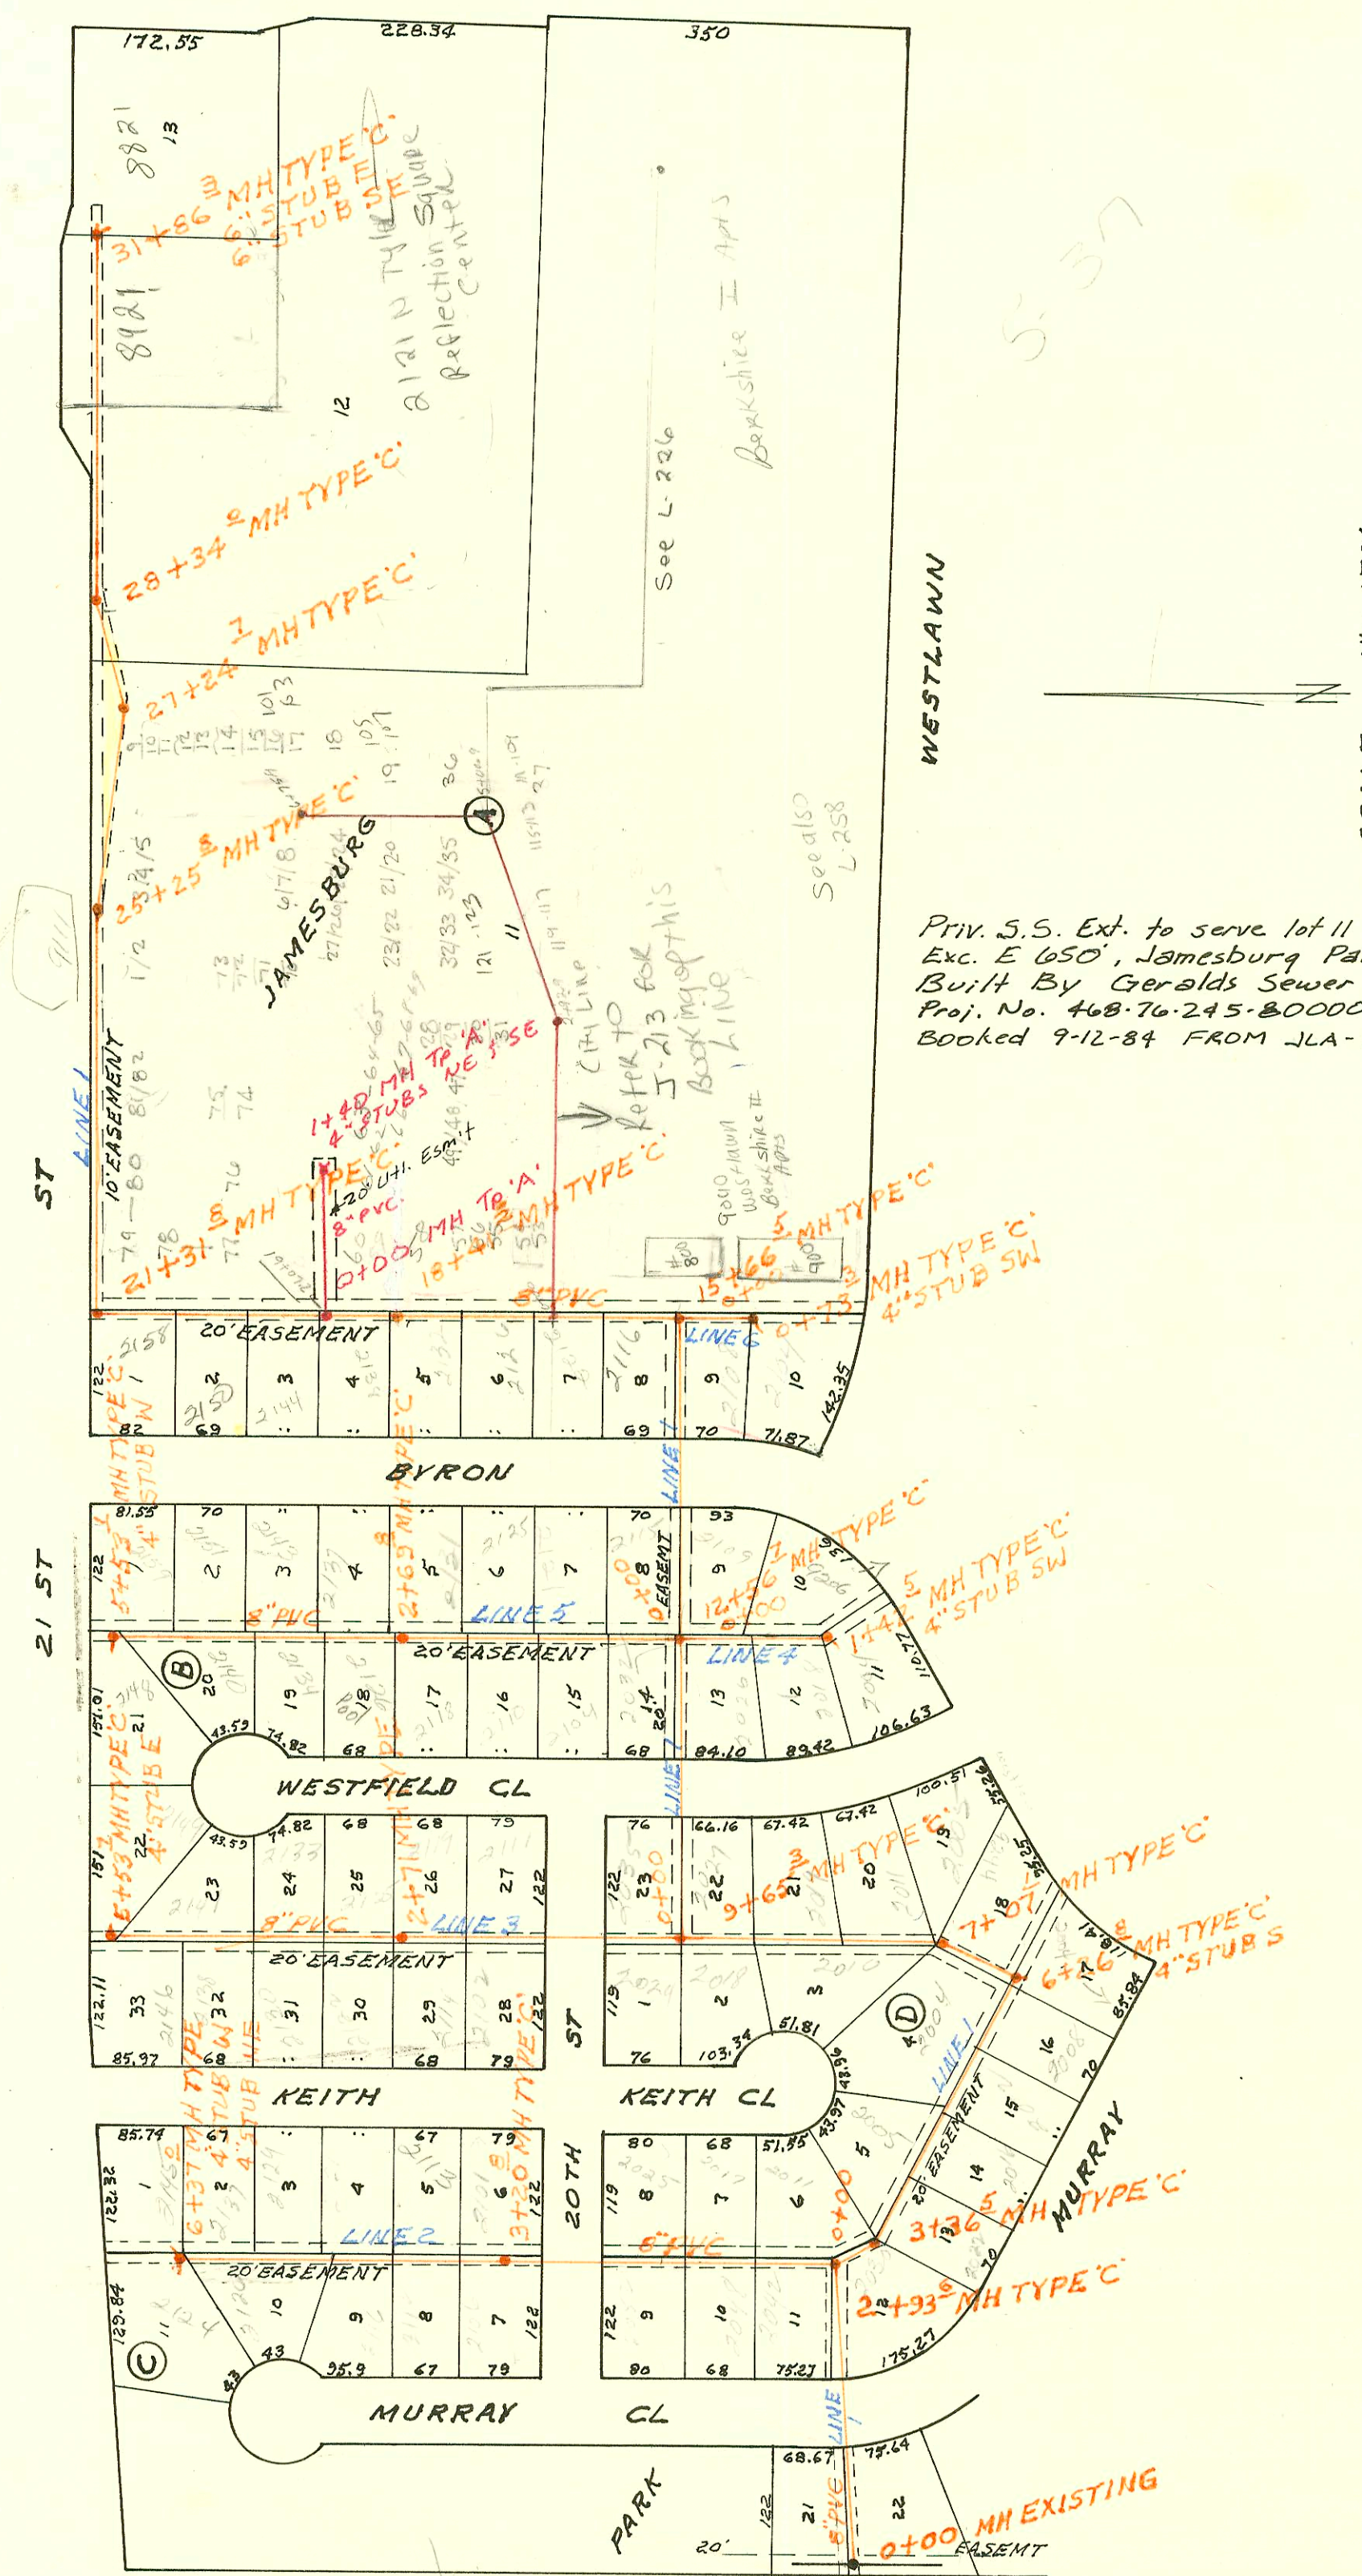

Priv. S.S. Ext. to serve lot 11 Blk A
 Exc. E 650', Jamesburg Park
 Built By Gerald's Sewer & Sanitation
 Proj. No. 468-76-245-80000-000-000-008
 Booked 9-12-84 FROM JLA-2

LATERAL 2 MAIN 4 WESTLINK SEWER
 BUILT BY: MID STATES CONST. CO.
 PROJ. NO. 468-76-245-80980-000-000-001
 BOOKED 7-20-83 FROM DLX 404

2000
 Initial fee
 required
 for
 4/27

CONSTRUCTION RECORD						SERVICE RECORD							
STATION	ELEVATION		Depth	MANHOLE	4-INCH "Y" BRANCHES		No. of Permit		House Number		DATE OF PERMITS		
	Ground	Grade			North West	South East	North West	South East	North West	South East	North West	South East	
LATERAL 2 MAIN 4 WESTLINK SEWER													
LINE 1 0+00	156.7	145.26	11.4	2+00 EXISTING									
1+00	155.5	145.57	9.9										
2+00	156.2	145.88	10.3										
	158.1	146.20	11.9	2+93.6									
					2+99.6			12072	2030 Murray		9-21-84		
3+00	156.2	146.21	10.0										
	158.2	146.23	11.9	3+36.5									
					3+95.5	3+93.5	11260	11674	2005 N Smith Co	2022 Murray	6-21-84	8-2-84	
4+00	156.1	146.49	9.6										
					17' E. of W. P.L.			11873	2016 Murray			8-2-84	
5+00	156.7	146.80	9.9										
						5+32.8		13071	2012 Murray			9-21-84	
						5+72.8		11240	2008 Murray			6-30-84	
6+00	157.7	147.11	10.6										
	157.7	147.19	10.5	6+26.8		4" STUB S		9973	2004 Murray			1-9-84	
					16+77.8	6+735.8	11250	10138	2004 Keith Co	2014 Westlaw	6-20-84	2-6-84	
7+00	157.9	147.48	10.4										
	158.5	147.51	11.0	7+07.1		7+16.1		13258	2003 Westfield			8-11-85	
						7+65.1		13237	2011 Westfield			3-15-85	
8+00	156.0	147.83	8.2										
					8+24.3			14209	2010 Keith Co			7-17-85	
						8+62.8		13238	2011 Westfield			3-15-85	
9+00	156.2	148.17	8.4										
	158.9	148.42	10.5	9+65.3		9+32.3		14270	2011 Keith Co			7-17-85	
						9+34.3		13240	2021 Westfield			3-15-85	
10+00	156.3	148.53	7.8										
11+00	156.5	148.86	7.6										
12+00	156.7	149.19	7.5										
	158.1	149.38	8.7	12+56.7		4" STUB S		14426	2020 Westfield			8-13-85	
						12+50.7							
13+00	157.4	149.50	7.9										
						13+08.7		13466	2109 Byron			4-12-85	
14+00	157.7	149.77	7.9										
15+00	158.0	150.04	8.0										
	158.6	150.22	8.4	15+66.5		9+12.5		10285	2116 Byron			2-23-84	
16+00	158.6	150.32	8.3										
						16+72.5		10699	2122 Byron			4-16-84	
17+00	159.0	150.62	8.4										
						17+64.8		10025	2126 Byron			1-17-84	
						17+94.8	17+68.2	10024	14944	2132 Byron	9111 W# 59	1-17-84	10-31-85
18+00	159.6	150.93	8.7										
	159.9	151.05	8.9	18+41.2		18+54.7		14966	9111 W. 21st St 58			11-4-85	
						18+94.8	18+70.2	10137	14930	2138 Byron	9111 W. 21st St 60	2-6-84	10-31-85
19+00	160.2	151.22	9.0										
					19+07.2 mh	19+47.8		9964	2144 Byron			1-6-84	
						19+57.0		11710	9111 W. 21st St 77			8-8-84	
20+00	160.9	151.51	9.4										
						20+13.8	20+37.8	13807	11711	2150 Byron	9111 W. 21st St 78	5-21-85	2-8-84
						20+83.8		13210	2154 Byron			5-21-85	
21+00	161.5	151.81	9.7										
	161.9	151.96	9.9	21+31.8									
						21+78.2		11721	9111 W. 21st St 79			5-9-84	
22+00	162.0	152.23	9.8										
						22+66.8		11722	9111 W. 21st St 80			8-9-84	
23+00	162.2	152.62	9.6										
						23+55.8		11723	9111 W. 21st St 81			8-9-84	
						23+92.2		11724	9111 W. 21st St 82			8-9-84	
24+00	162.6	153.02	9.6										
						24+67.8		13118	9111 W. 21st St 7			2-28-85	
25+00	163.5	153.41	10.1										
	164.3	153.51	10.8	25+25.8		24+83.8		13256	9111 W. 21st St (2)			3-18-85	
						25+19.8		13268	9111 W. 21st St (3)			3-19-85	
						25+51.8		13269	9111 W. 21st St (4)			3-19-85	
26+00	165.5	153.81	11.7										
						25+73.8		13119	9111 W. 21st St 5			2-28-85	
27+00	166.1	154.21	11.9										
	166.5	154.31	12.2	27+24.7		27+44.3		11392	9111 W. 21st St 13			1-6-85	
								13747	9111 W. 21st St 11			5-20-85	
28+00	165.8	154.67	11.1										
	166.0	154.83	11.2	28+34		28+23.0		24420	2121 Tylor	Reflection Square		12-4-81	

