


TYLER RD

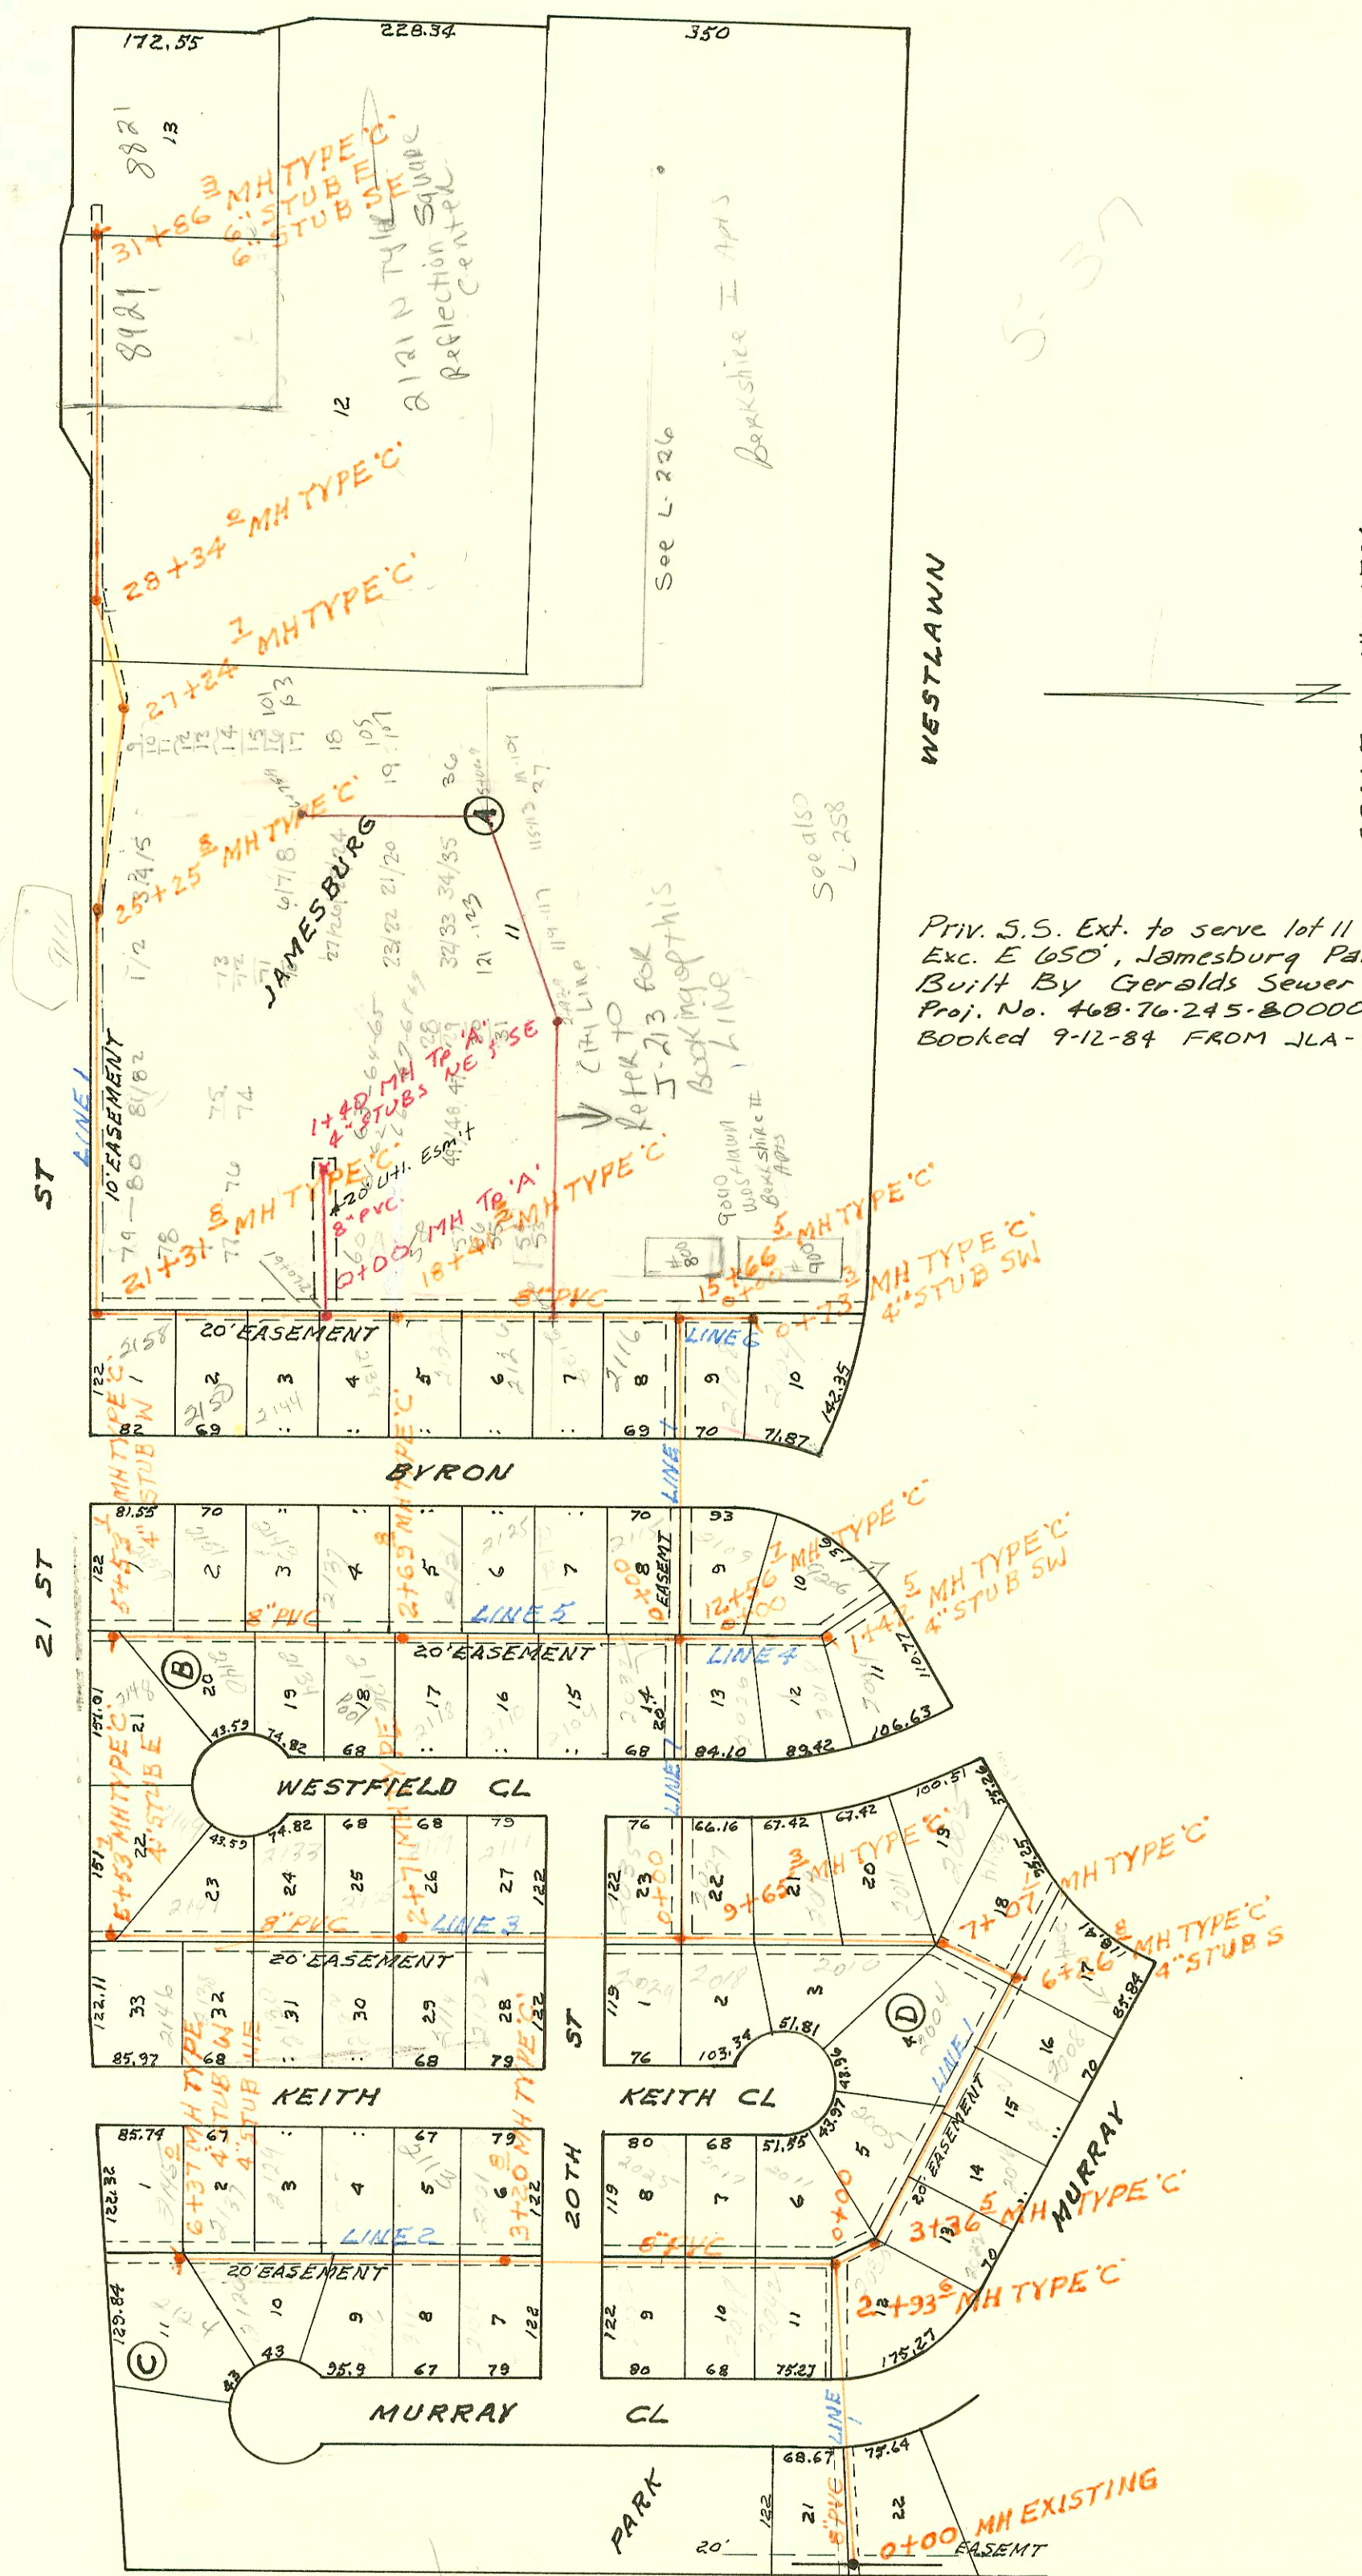

WESTLAWN

SCALE 1" = 150'

Priv. S.S. Ext. to serve lot 11 Blk A  
 Exc. E 650', Jamesburg Park  
 Built By Gerald's Sewer & Sanitation  
 Proj. No. 468-76-245-80000-000-000-008  
 Booked 9-12-84 FROM JLA-2

LATERAL 2 MAIN 4 WESTLINK SEWER  
 BUILT BY: MID STATES CONST. CO.  
 PROJ. NO. 468-76-245-80980-000-000-001  
 BOOKED 7-20-83 FROM DLX 404

2000  
 Initial fee  
 required  
 for  
 4/27

