



MAIN 9 SANITARY SEWER No 23
BUILT BY: MID STATES CONST. CO.
PROJ. No 468-76-245-81002-000-000-001
BOOKED 9-1-83 FROM AG27

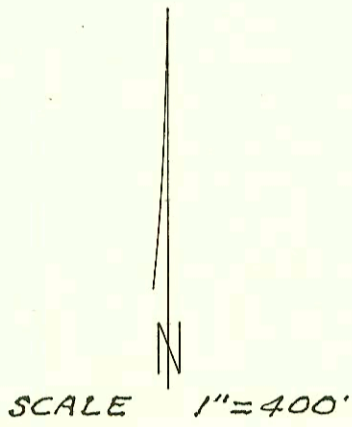

ADJUSTMENTS OF CITY OWNED UTILITIES
FOR THE K-96 BYPASS
INDEX No. 700021
Booked 11-12-91 from Plan
(See I-240 for ELEVATIONS)

SEC
36

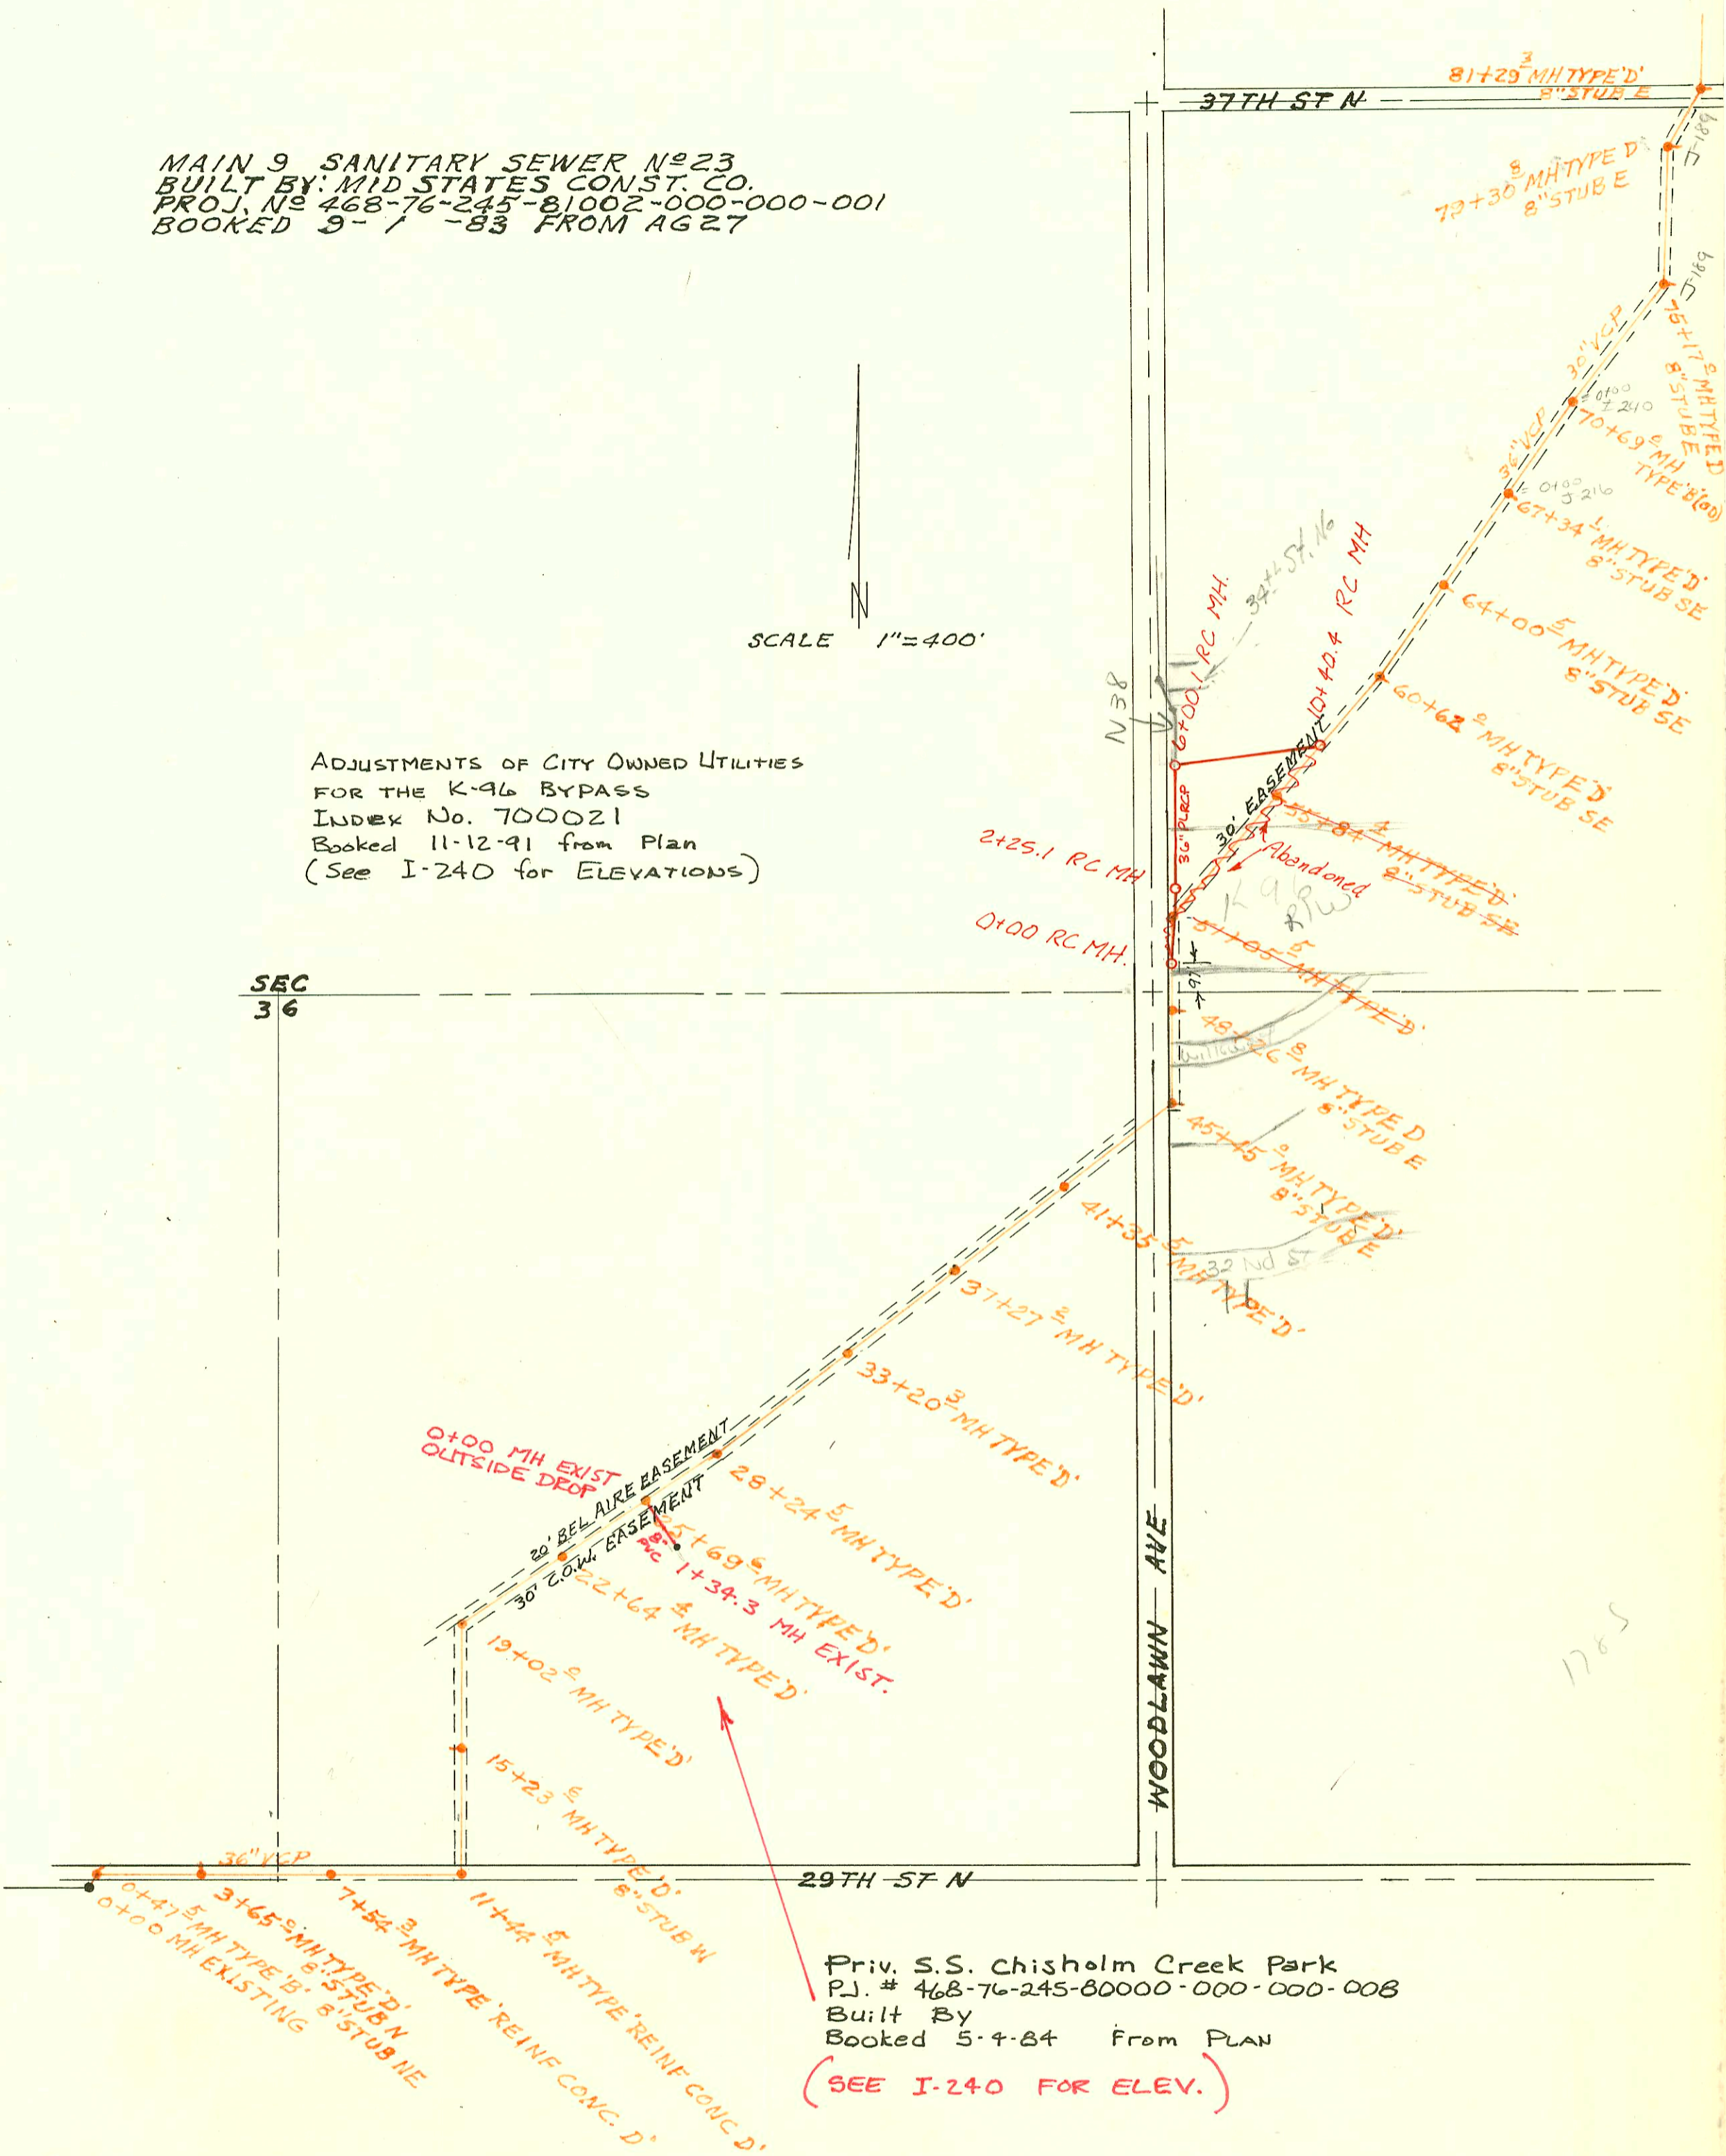

I234

CONSTRUCTION RECORD

SERVICE RECORD

MAIN
LINE 1
CONT'D

STATION	ELEVATION		Depth	MANHOLE	4-INCH "Y" BRANCHES		No. of Permit		House Number		DATE OF PERMITS	
	Ground	Grade			North West	South East	North West	South East	North West	South East	North West	South East
	MAIN 9 55 N° 23 (CONT'D)											
27+00	170.0	148.96	21.0									
28+00	166.7	149.10	17.6									
	167.2	149.13	18.1	28+24.5								
29+00	167.2	149.21	18.0									
30+00	165.4	149.31	16.1									
31+00	164.3	149.41	15.0									
32+00	163.9	149.51	14.4									
33+00	165.2	149.61	15.6									
	166.6	149.63	17.0	33+20.3								
34+00	166.6	149.71	16.9									
35+00	167.2	149.81	17.4									
36+00	167.4	149.90	17.5									
37+00	167.7	150.00	17.7									
	168.3	150.03	18.3	37+27.2								
38+00	167.7	150.08	17.6									
39+00	167.6	150.14	17.5									
40+00	167.9	150.21	17.7									
41+00	168.2	150.28	17.9									
	168.4	150.30	18.1	41+35.5								
42+00	168.7	150.38	18.3									
43+00	168.8	150.51	18.3									
44+00	168.8	150.64	18.2									
45+00	170.1	150.76	19.3									
	170.3	150.82	19.5	45+45.0		8" STUB E						
46+00	169.4	150.88	18.5									
47+00	169.4	150.99	18.4									
48+00	169.2	151.09	18.1									
	170.4	151.12	19.3	48+26.8		8" STUB E						
49+00	169.5	151.19	18.3									
50+00	169.4	151.28	18.1									
51+00	169.5	151.37	18.1									
	171.3	151.37	19.9	51+05.5								
52+00	169.6	151.48	18.1									
53+00	169.8	151.60	18.2									
54+00	170.0	151.72	18.3									
55+00	170.0	151.84	18.2									
	171.2	151.94	19.3	55+84.4		8" STUB SE						
56+00	170.1	151.96	18.1									
57+00	170.3	152.06	18.2									

