


MAIN 9 SANITARY SEWER No 23

SCALE 1"=400'

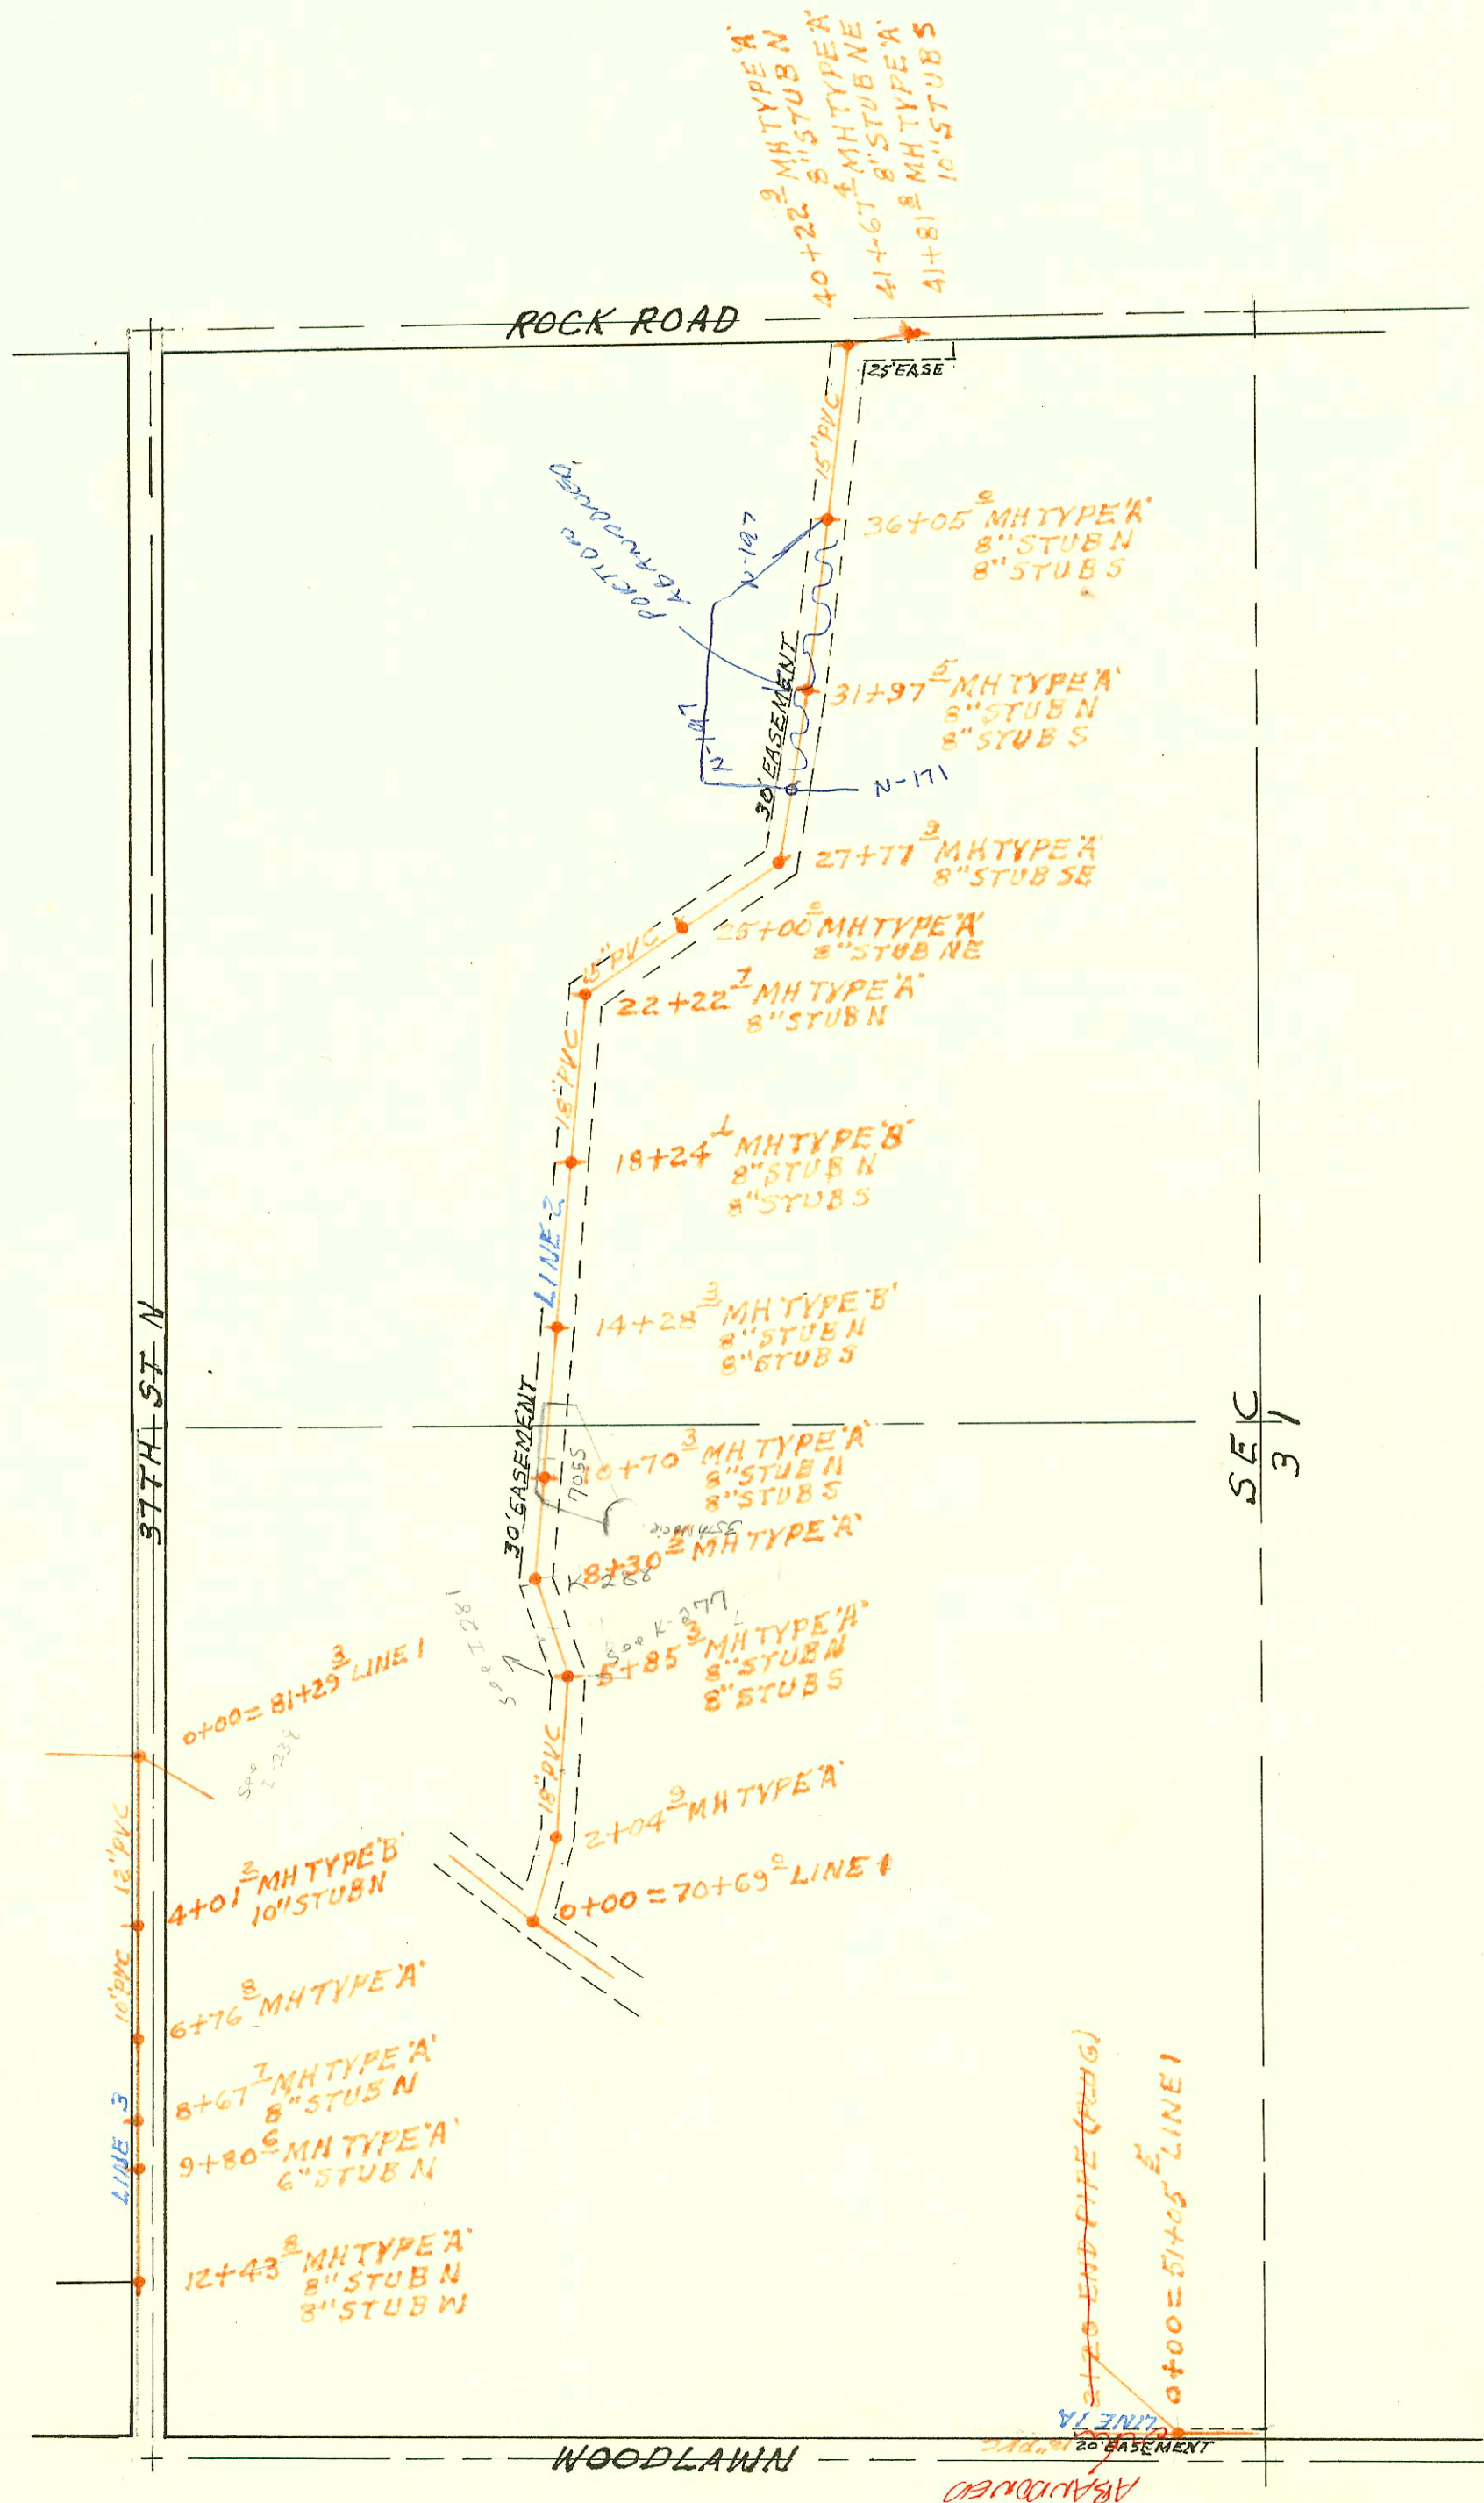

SEC 31

ASPAVED  
20' END PIPE (PUSH)  
LINE 1  
0+00=70+69

CONSTRUCTION RECORD

SERVICE RECORD

MAIN 9  
LINE 3

SS #23 (CONT'D)

STATION	ELEVATION		Depth	MANHOLE	4-INCH "Y" BRANCHES		No. of Permit		House Number		DATE OF PERMITS	
	Ground	Grade			North West	South East	North West	South East	North West	South East	North West	South East
0+00	176.6	157.26	19.3	0+00 = 81+29.3 LINE 1								
1+00	174.7	157.64	17.1									
2+00	173.0	158.02	15.0									
3+00	170.9	158.40	12.5									
4+00	171.5 175.1	158.78	12.7 16.3	4+01.2 10" STUB N								
5+00	172.1	159.62	12.5									
6+00	170.8 174.2	160.48	10.3 13.1	6+76.8								
7+00	172.7	161.31	11.4									
8+00	175.3 174.8	162.08	13.2 12.2	8+67.7 8" STUB N								
9+00	175.0 175.7	162.86	12.1 12.2	9+80.6 6" STUB N								
10+00	176.0	163.66	12.3									
11+00	176.6	164.42	12.2									
12+00	177.8 178.2	165.18	12.6 12.7	12+43.8 8" STUB W 8" STUB N								
Priv. S	S. for Chisholm Creek Park											
0+00	169.3	164.80	4.5	0+00 EXIST.								
1+00	172.0	166.01	6.0	1+34.3 EXIST.								
Reloc	on of a Portion of MAIN 9, S.S. #23											
LINE 1	0+40.1	191.79	174.99 OUT 175.49 IN	16.8	0+40.1							
	1+00	198.3	175.50 OUT 175.68 IN	17.8	1+63.9							
	2+00	190.2	175.71	14.5								
	3+00	191.5	175.80	15.7								
	4+00	191.0 190.40	175.88 175.90 OUT 175.95 IN	15.1 14.5	4+20.2							
	5+00	193.4	176.28 OUT 176.61 IN 175.37 OUT 182.29 IN	17.1	5+00.2 1+63.9 C-1 0+00							
LINE 2	0+00	190.60	182.29 IN	15.2	0+00							
	0+78.1	191.5	182.60	8.9								
ADJUSTMENTS	OF CITY OWNED UTILITIES FOR K-96 BYPASS											
	0+00	173.10	151.19	21.9	0+00							
	1+00	177.1	151.25	25.9								
	2+00	175.6 174.40	151.31 151.33	24.3 23.1	2+25.1							
	3+00	172.9	151.37	21.0								
	4+00	163.8	151.43	12.4								
	5+00	166.1 170.70	151.49	14.6 19.2	6+00.1							
	7+00	163.8	151.61	12.2								
	8+00	164.6	151.67	12.9								
	9+00	164.6	151.73	12.9								
	10+00	166.9 171.00	151.79	15.1 19.2	10+40.4							