


LATERAL 25 MAIN 7 SAN SEWER N#23  
 BUILT BY: MID STATES CONST. CO.  
 PROJ. N# 468-76-245-8111-000-000-001  
 BOOKED 10-25-83 FROM MGP 15

*on map*  
 12-32


SCALE 1"=150'

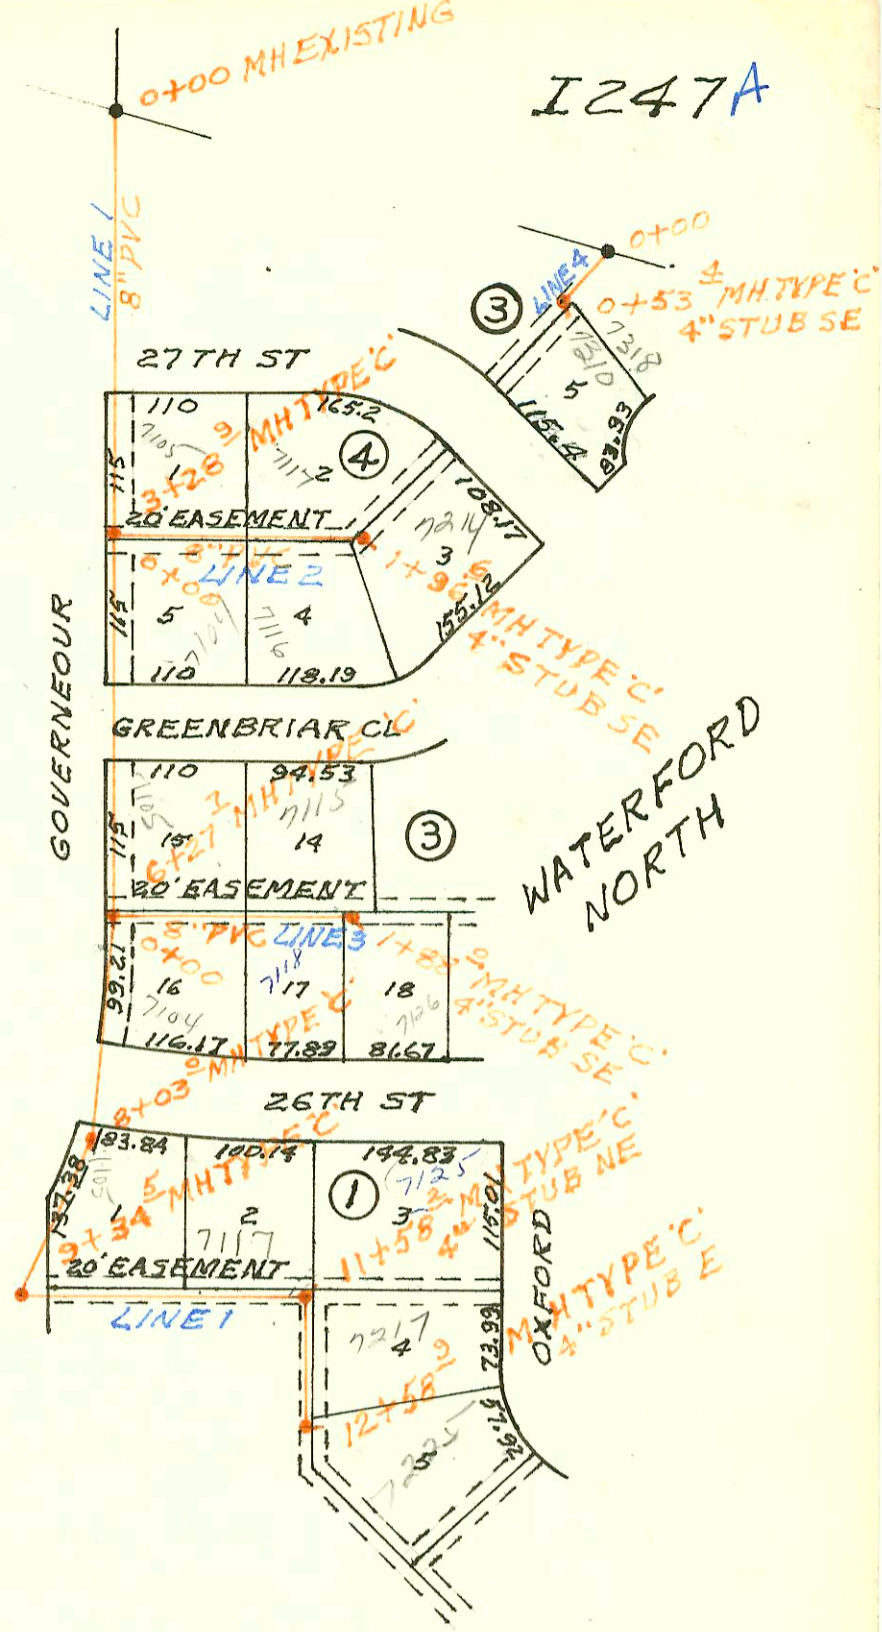

LATERAL 42 MAIN 5 SAN SEWER N#23  
 BUILT BY: W.B. CARTER CONST. CO.  
 PROJ. N# 468-76-245-81148-000-000-001  
 BOOKED 10-26-83 FROM AG 12

*on map*  
 11-39


SCALE 1"=150'

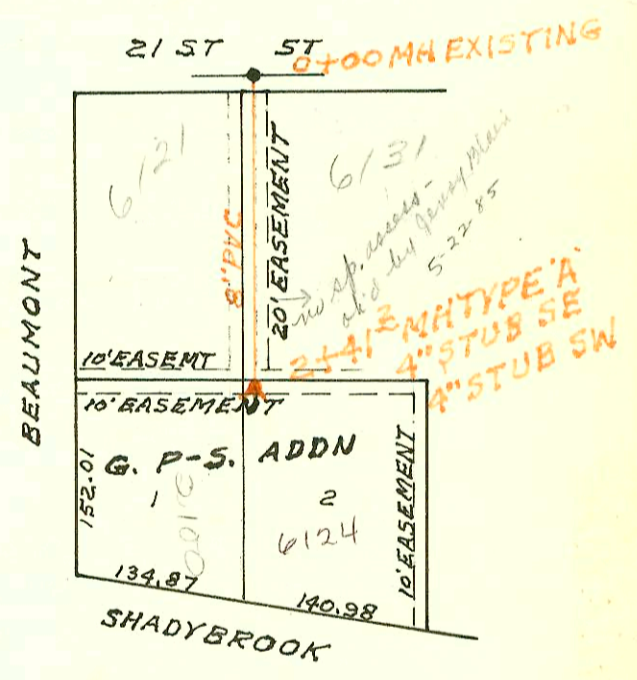

LATERAL 70 WESTLINK SEWER  
 BUILT BY: MID STATES CONST. CO.  
 PROJ. N# 468-76-245-81222-000-000-001  
 BOOKED 10-27-83 FROM DLK 454

*on map*  
 549

SCALE 1"=150'

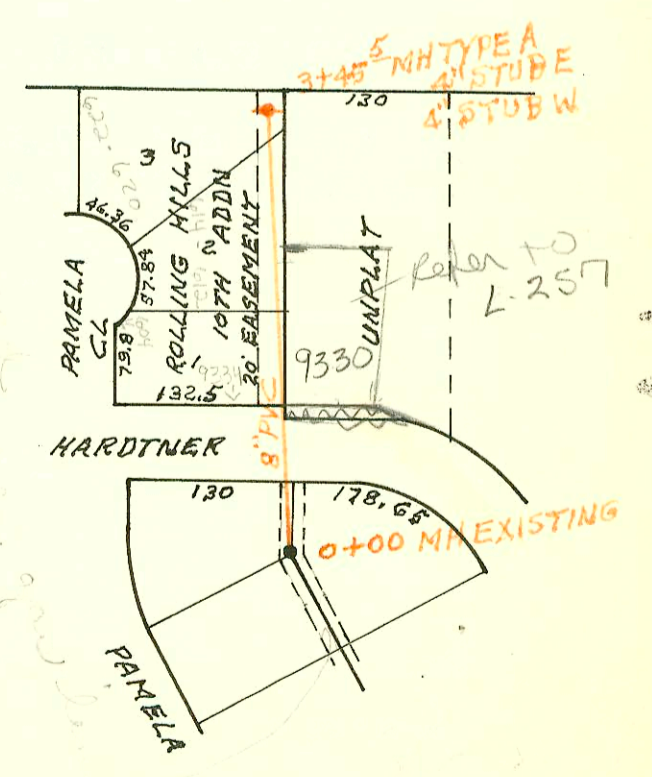

CONSTRUCTION RECORD						SERVICE RECORD						
STATION	ELEVATION		Depth	MANHOLE	4-INCH "Y" BRANCHES		No. of Permit		House Number		DATE OF PERMITS	
	Ground	Grade			North West	South East	North West	South East	North West	South East	North West	South East
LAT 25 MAIN 7 55 N#23 (CONT'D)												
LINE 1 CONT'D 6+00	192.2	183.19	9.0									
	192.4	183.31	9.1	6+27.7								
7+00	192.3	183.64	8.7									
8+00	192.6	184.11	8.5									
	192.9	184.12	8.8	8+03.0								
9+00	193.2	184.55	8.7									
	194.0	184.70	9.3	9+34.5								
10+00	194.5	185.03	9.5		10+72.5		12249		7105 E 2674 N		10-16-84	
11+00	196.3	185.54	10.8		10+92.9		11245		7117 E 2674 N		6-19-84	
	197.0	185.83	11.2	11+58.2		11753.2	12378		7125 E 2674 N		10-24-84	
12+00	197.2	186.03	11.2									
	198.2	186.32	11.9	12+58.9								
LINE 2 0+00	192.4	182.12	10.3	0+00=3+28.9 LINE 1	0+38.0		13273		7105 E 2674 N		3-20-85	
					0+76.0			12878	7104 E 2674 N		1-7-85	
1+00	193.5	182.63	10.9		1+52.1			13246	7116 E 2674 N		10-16-84	
	194.6	183.13	11.5	1+96.6	1+59.6		11894	11015	7117 E 2674 N	7214 E 2674 N	8-29-84	5-24-84
LINE 3 0+00	192.4	183.41	9.0	0+00=6+27.7 LINE 1	0+30.0		11792		7105 E 2674 N		8-16-84	
					0+65.0			11061	7104 E 2674 N		5-31-84	
1+00	194.1	184.18	9.9		1+34.0		11016	11762	7115 E 2674 N	7114 E 2674 N	5-24-84	8-14-84
	196.4	184.86	11.5	1+88.0				13274	7126 E 2674 N		3-20-85	
LINE 4 0+00	192.7	182.81	9.9	0+00 EXISTING								
	193.4	183.18	10.2	0+53.4								
LATERAL 42 MAIN 5 55 N#23 0+00	205.8	197.40	8.4	0+00 EXISTING								
1+00	208.2	199.44	8.8									
2+00	209.8	201.47	8.3					14026		6131 E 21.0		6-19-85
	211.4	202.31	9.1	2+41.2			9103	26228	6100 N Shadybrook	6124 Shadybrook	9-20-83	3-3-88
LAT 70 WESTLINK SEWER 0+00	143.3	134.36	8.7	0+00 EXISTING	0+04.4 TAP W							
1+00	142.7	134.63	8.1		1+70.5		12403		604 E Panola		10-20-84	
2+00	143.3	134.90	8.4		1+67.5		12679		612 E Panola		11-31-84	
					2+39.9			9237	614 E Panola		9-28-83	
3+00	142.8	135.18	7.6		2+70.3			9239	614 E Panola		9-28-83	
	144.1	135.30	8.8	3+45.5	3+36.4			9238	614 E Panola		9-28-83	

Handwritten notes on the right margin, including "7105 E" and "2674 N".