


NOTE
Lift station
and force line
eliminated
See Bottom
of page I251
BR
10/16/00

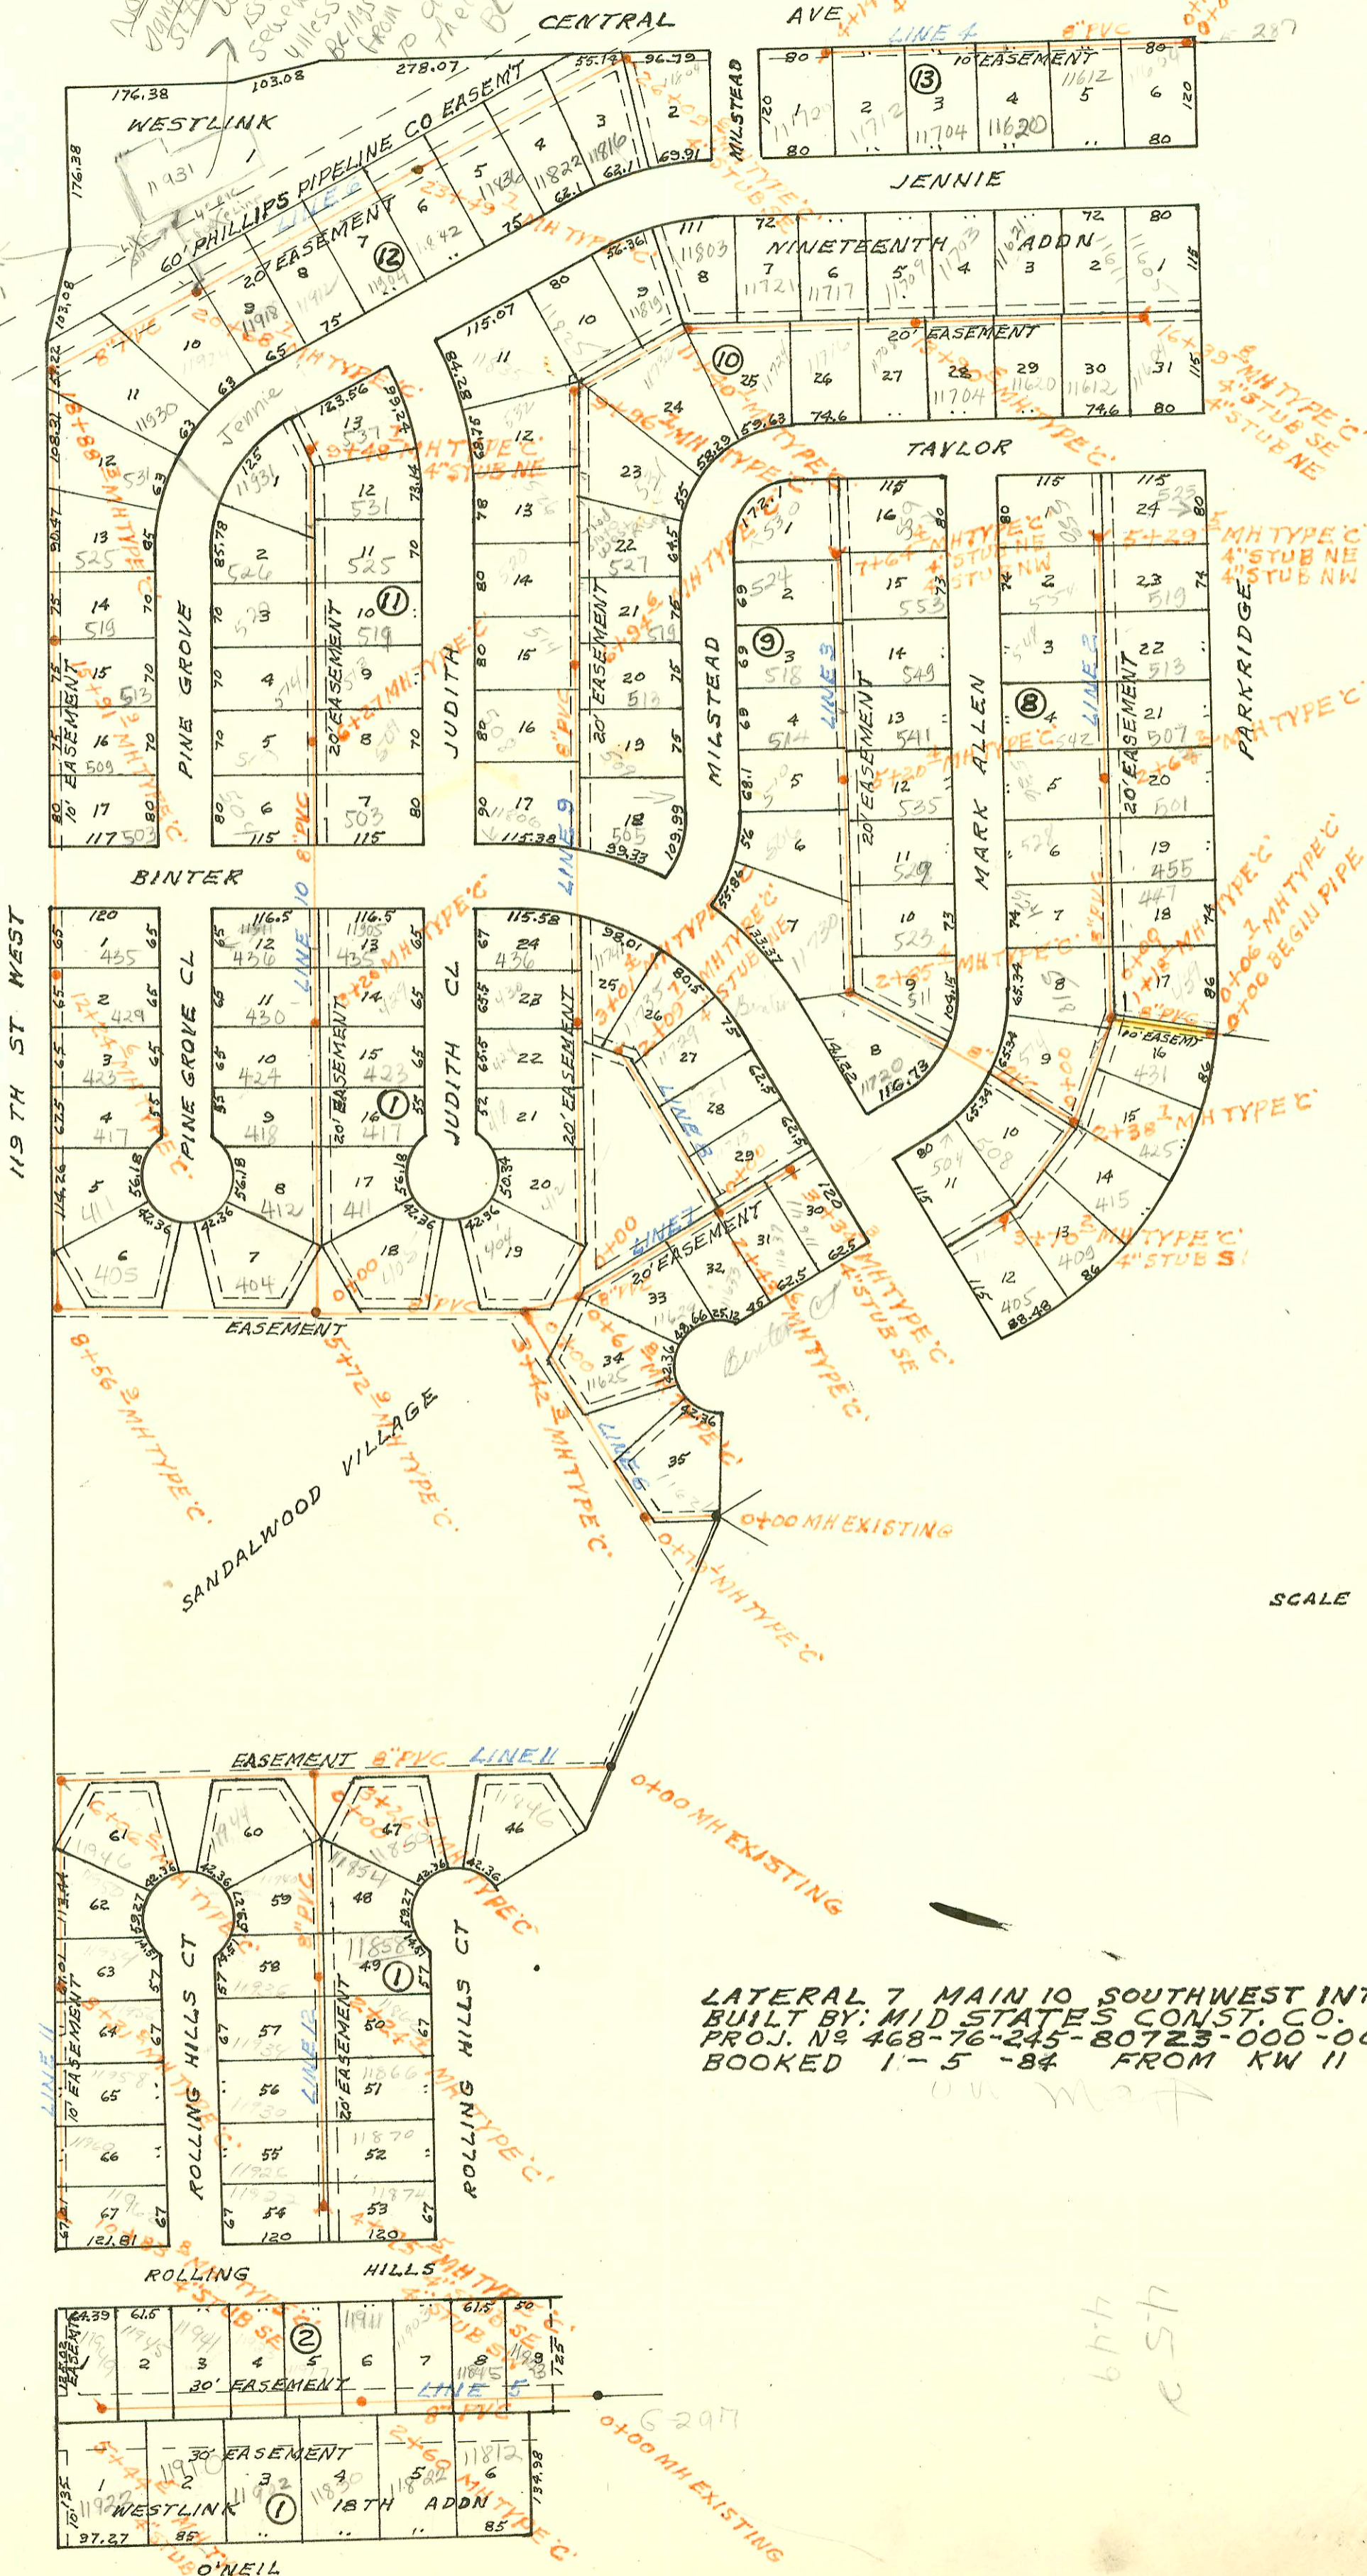

LATERAL 7 MAIN 10 SOUTHWEST INTERCEPTOR
 BUILT BY: MID STATES CONST. CO.
 PROJ. NO 468-76-245-80723-000-001
 BOOKED 1-5-84 FROM KW 11

SCALE 1" = 150'

677
EST

6207
0+00 MH EXISTING

O'NEIL

CONSTRUCTION RECORD							SERVICE RECORD					
STATION	ELEVATION		Depth	MANHOLE	4-INCH "Y" BRANCHES		No. of Permit		House Number		DATE OF PERMITS	
	Ground	Grade			North West	South East	North West	South East	North West	South East	North West	South East
LAT LINE 7	7 MAIN 10 SWI (CONT'D)											
0+00	154.6	144.10	10.5	0+00=3+42.3								
	155.3	144.42	10.9	0+61.8								
1+00	156.8	144.55	12.2									
2+00	156.6	144.90	11.7									
	154.8	145.05	9.7	2+43.6								
3+00	156.6	145.31	11.3									
	156.9	145.47	11.4	3+34.3								
LIN 8	0+00	154.8	145.47	9.3	0+00=2+43.6							
1+00	156.2	146.46	9.7									
2+00	155.8	147.44	8.4									
	156.8	147.54	9.3	2+09.7								
LIN 9	0+00	155.3	144.37	10.9	0+00=0+61.8							
1+00	156.2	144.71	11.5									
2+00	156.0	145.04	11.0									
3+00	155.7	145.37	10.3									
	156.6	145.38	11.2	3+01.4								
4+00	156.0	145.63	10.4									
5+00	156.4	145.89	10.5									
6+00	157.2	146.14	11.1									
	158.7	146.38	12.3	6+24.6								
7+00	158.0	146.40	11.6									
8+00	159.4	146.78	12.6									
9+00	160.1	147.17	12.9									
	160.7	147.54	13.2	9+96.7								
10+00	160.3	147.55	12.8									
11+00	160.0	147.83	12.2									
	160.9	147.94	13.0	11+40.1								
12+00	159.3	148.14	11.2									
13+00	158.6	148.48	10.1									
	160.5	148.78	11.7	13+90.8								
14+00	158.4	148.81	9.6									
15+00	158.6	149.14	9.5									
16+00	158.7	149.48	9.2									
	160.2	149.61	10.6	16+39.8								
LIN 10	0+00	155.9	144.81	11.1	0+00=5+72.3							
1+00	154.5	145.06	9.4									
2+00	155.1	145.32	9.8									
3+00	155.2	145.57	9.6									
	156.7	145.62	11.1	3+20.0								

7/10 12581-5200N Judith - 11-14-84 - Leon Broadlove - 61 946 - 100.00 - (11+94.6)

I252 A