


LATERAL 239 MAIN 5 S.S. N^o 22
 BUILT BY: DULING CONST. CO.
 PROJ. N^o 468-76-245-81290-000-000-001
 BOOKED 1-5-84 FROM DLK 363

Plot 6-50


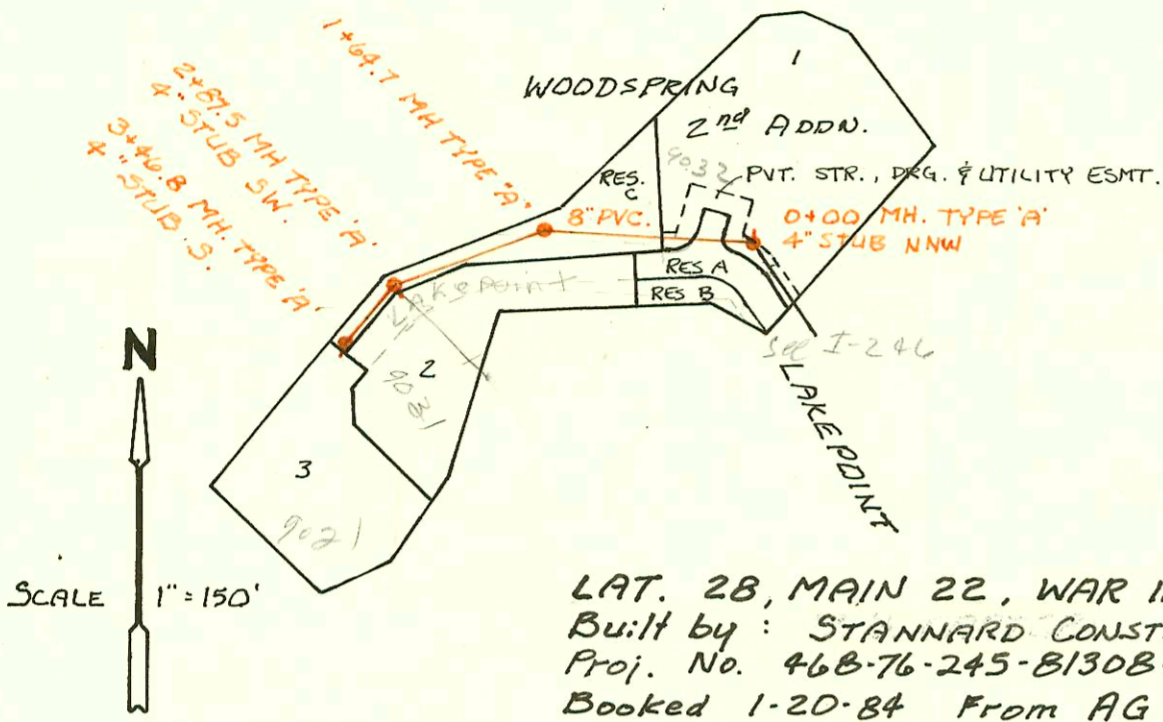


LAT. 28, MAIN 22, WAR INDUSTRIES SEWER
 Built by: STANNARD CONST.
 Proj. No. 468-76-245-81308-000-000-001
 Booked 1-20-84 From AG 13A

Plot 1-331


LAT 32, MAIN 21, S.S. # 22
 BUILT BY: STANNARD CONST.
 Proj. No. 468-76-245-80985-000-000-001
 BOOKED 1-23-84 From DCD-218

Plot 8-25

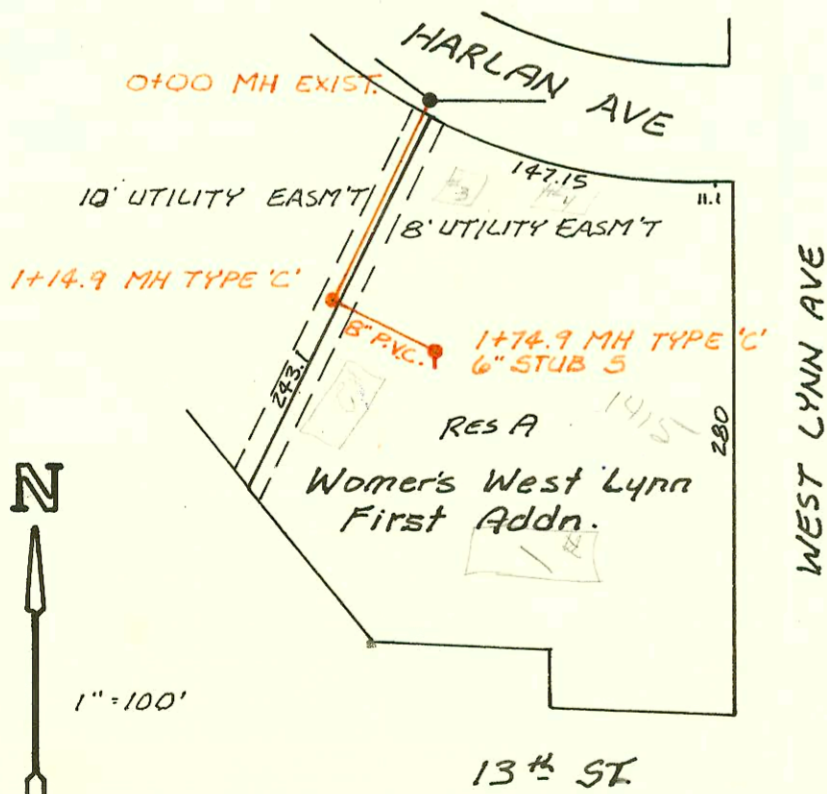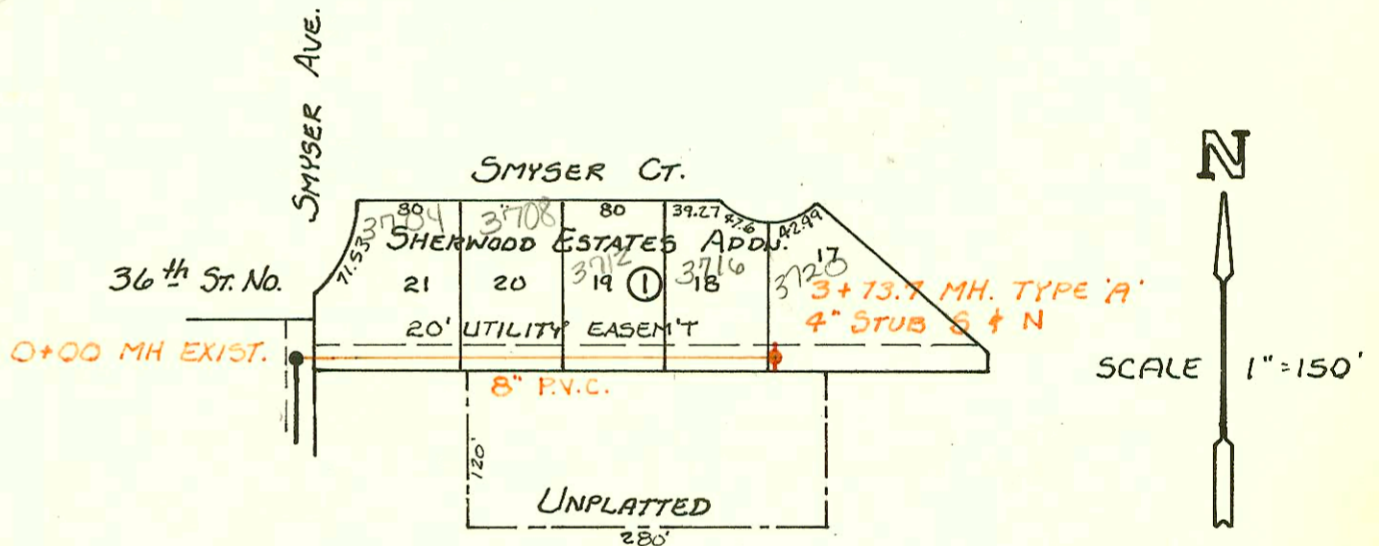


S.S. Extension to serve Res. A
 Womer's West Lynn 1st Addn.
 468-76-245-80000-000-000-008
 Built by: Duling Const. Booked 1-26-84 FROM 11-H

Plot 7-80

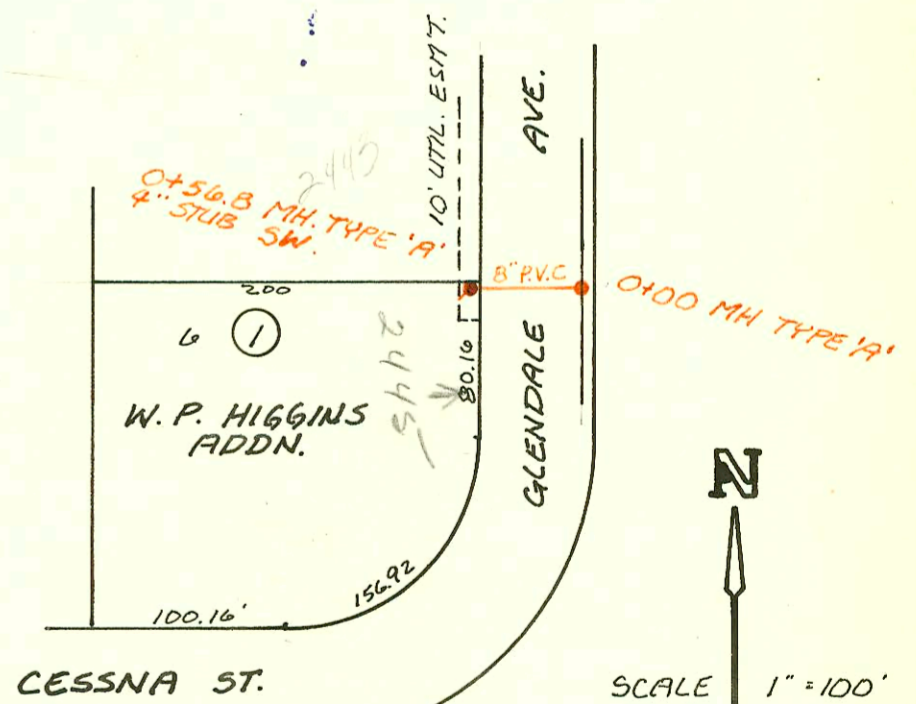

S.S. Extension to serve Graf Electric
 468-76-245-80000-000-000-008
 Built by: Stannard Const.
 Booked 1-26-84 From JLA #31

Plot 11-68

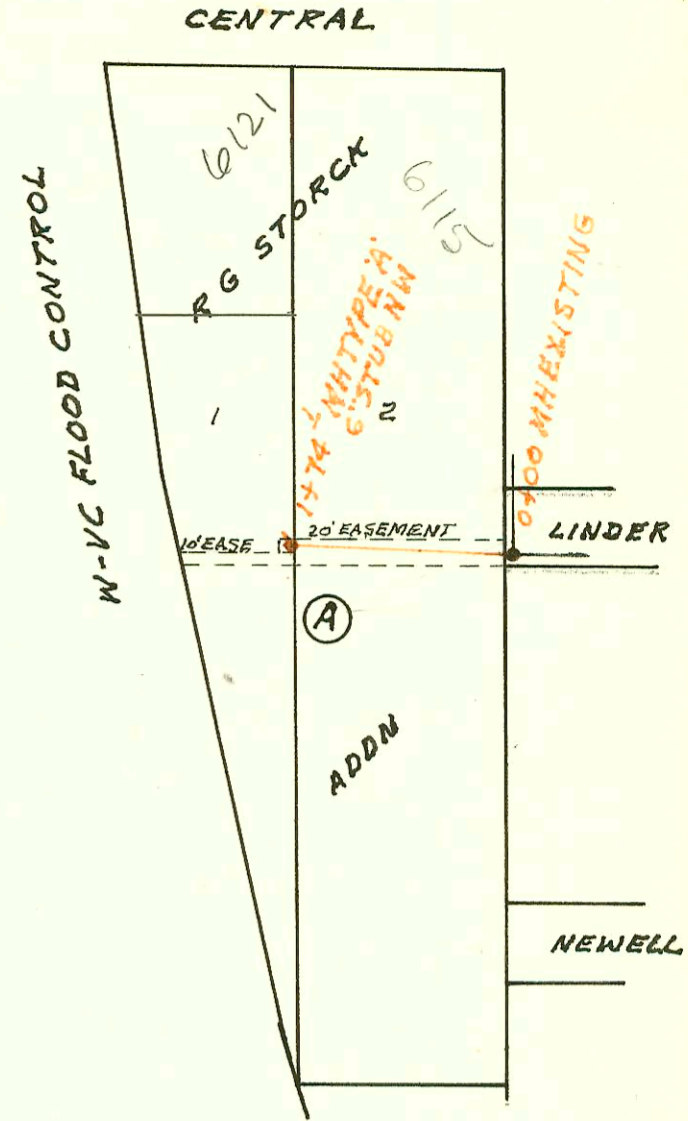

CONSTRUCTION RECORD						SERVICE RECORD						
STATION	ELEVATION		Depth	MANHOLE	4-INCH "Y" BRANCHES		No. of Permit		House Number		DATE OF PERMITS	
	Ground	Grade			North West	South East	North West	South East	North West	South East	North West	South East
LATERAL 239 MAIN 5 S S N ^o 22												
0+00	121.8	116.90	4.9	0+00 EXISTING								
1+00	122.1	117.26	4.8				16558					
	122.1	117.53	4.6	1+74.1	6" STUB NW		16546		16127		6-7-2886	6-30-86
LAT. 28, MAIN 22, W 15												
0+00	203.6	197.06	6.5	0+00	4" STUB NNW		11294		9032		6-27-84	
1+00	204.0	197.60	6.4									
1+64.7	206.6	197.95	8.9	1+64.7								
2+00	205.0	198.14	6.9									
2+87.5	204.9	198.61	6.3	2+87.5	4" STUB SW		9602		9031		1-1-84	11-2-83
							11311		9031			6-28-84
3+00	205.2	198.70										
3+46.8	204.2	199.03	5.2	3+46.8	4" STUB S		11129		9021		6-7-84	
LAT 32, MAIN 21, S.S. # 22												
0+00	133.8	125.77	8.0	0+00 EXIST.								
1+00	133.9	126.04	7.9		1+05.0 TAP		19487		3704		11-3-87	
					1+74.5 TAP		21550		3705		9-22-88	
2+00	132.9	126.32	6.6		2+24.7 TAP		21118		3712		9-20-88	
					2+97.2 TAP		21231		3716		2-20-90	
3+00	133.9	126.59	7.3									
	134.7	126.79	7.9	3+73.7	4" STUB N 4" STUB S		9924		3720		12-20-83	
S.S. EXTENSION TO SERVE GRAF ELECTRIC												
0+00	119.7	112.38	7.3	0+00								
	120.5	112.48	8.0	0+56.8	4" STUB SW		14616	8818	2443 S	2445	8-30-85	7-27-83
S.S. EXTENSION TO SERVE RES. A. WOMER'S WEST LYNN 1 st ADDN.												
0+00	128.0	117.18	10.8	0+00			11487		1415 #4		7-17-84	
							10448		1415 #5		3-12-84	
1+00	128.3	117.60	10.7									
	128.3	117.46 OUT	10.6	1+14.9			8882		1415 #2		9-2-83	
		117.75 IN										
	128.5	118.01	10.5	1+74.9	4" STUB S		9206		1415 #1		9-16-83	