


MAIN B, SW INTERCEPTOR
 P.J. # 448-76-245-80628-000-000-001

Plot 50

N



SCALE 1" = 300'

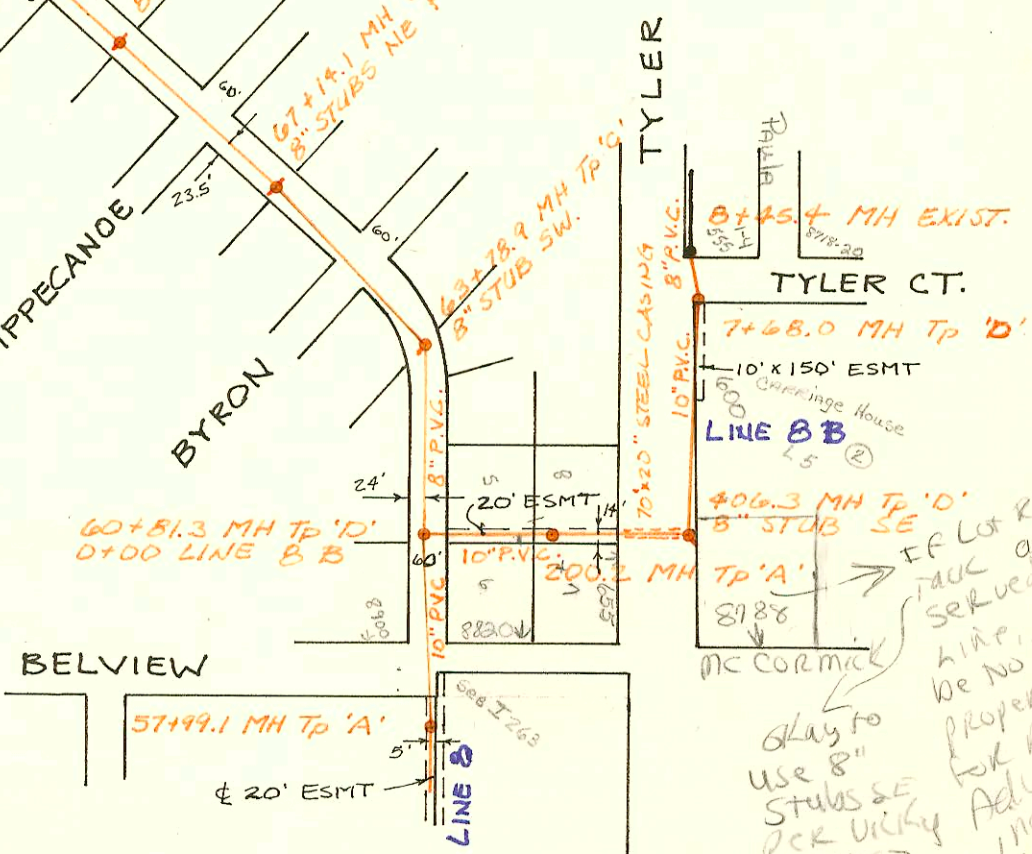

IF LOT REMAINS IN TRAC AND CAN BE SERVED BY 10" LINE, THERE WILL BE NO FEE IN LIOA PROPERTY IN BELVIEW FOR MAIN. ADVISE ALL INQUIRY THAT LINE IS 10" PER 3497

BR 1025-96

CONSTRUCTION RECORD						SERVICE RECORD						
STATION	ELEVATION		Depth	MANHOLE	4-INCH "Y" BRANCHES		No. of Permit		House Number		DATE OF PERMITS	
	Ground	Grade			North West	South East	North West	South East	North West	South East	North West	South East
MAIN 8 LINE 8 (CONT.)	(CONT.)											
SWI	136.25	121.76 OUT 121.93 IN	14.5	60+81.3								
61+00		122.04										
62+00	137.0	122.63	14.4									
63+00	137.1	123.22	13.9									
	137.03	123.68	13.3	63+78.9		8" STUB SW						
64+00	137.5	123.74	13.8									
65+00	136.0	124.04	12.0									
66+00	137.5	124.35	13.1									
67+00	138.2	124.65	13.5									
	138.04	124.69	13.3	67+14.1	8" STUB NE	8" STUB SW						
68+00	138.8	125.08	13.7									
69+00	139.7	125.53	14.2									
70+00	140.1	125.98	14.1									
	140.28	126.18	14.1	70+44.6	8" STUB NE	8" STUB SW						
71+00	140.2	126.39	13.8									
72+00	141.3	126.77	14.5									
73+00	141.5	127.15	14.3									
	141.93	127.42	14.5	73+69.8	8" STUB NE	8" STUB SW						
74+00	142.0	127.66	14.3									
75+00	143.1	128.45	14.6									
76+00	143.1	129.24	13.9									
	143.95	129.95	14.0	76+90.3	8" STUB NE	8" STUB SW						
77+00												
78+00	144.8	130.94	13.9									
79+00	145.1	131.85	13.2									
80+00												
	145.72	132.84	12.9	80+09.8	8" STUB NE	8" STUB SW						
81+00	146.2	133.63	12.6									
82+00	147.1	134.51	12.6									
83+00	148.0	135.38	12.6									
	148.36	135.65	12.7	83+30.3	8" STUB NE	8" STUB SW						
84+00	149.6	136.06	13.5									
85+00	151.7	136.65	15.0									
	152.58	137.16	15.4	85+86.2								
86+00	153.0	137.31	15.7									
87+00	154.5	138.41	16.1									
	154.70	138.59	16.1	87+16.2	8" STUB NE	8" STUB SW						
LINE 8B	0+00	136.25	125.40	10.9	0+00 60+81.3 L-8							
	1+00	136.7	125.80	10.9			150' RISE S. OK	22590	8820 W. Bellmew		22889	
	2+00											
		138.66	126.20	12.5	2+00.2		2+60' RISE S. OK	20694	605 S. Tyler		51388	
	3+00	142.2	126.58	15.6								
	4+00											
		143.63	126.99	16.6	4+06.3		8" STUB SE					
	5+00	143.3	127.26	16.0								
	6+00	143.9	127.55	16.3								
	7+00	143.8	127.84	16.0								
		142.34	128.04 OUT 130.56 IN	14.3	7+68							
	8+00	142.0	130.69	11.3								
		142.74	130.87	11.9	EXIST. MH. 8+45.4							
LINE 8C	0+00	127.14	113.98	13.2	0+00 EXIST.							
	1+00	126.6	115.18	11.4								
	2+00	126.9	116.38	10.5								
	3+00	127.1	117.58	9.5								
		125.68	117.88	7.8	3+24.6							
	4+00	127.5	118.40	9.1								
	5+00	127.9	119.09	8.8								
	6+00	128.0	119.78	8.2								
		128.32	120.12	8.2	6+49.4							
	7+00	130.5	123.13	7.4								
	8+00	138.7	129.07	9.6								
		141.40	131.86	9.5	8+46.9	8" STUB N	8" STUB S					