



2101

MACARTHUR ROAD

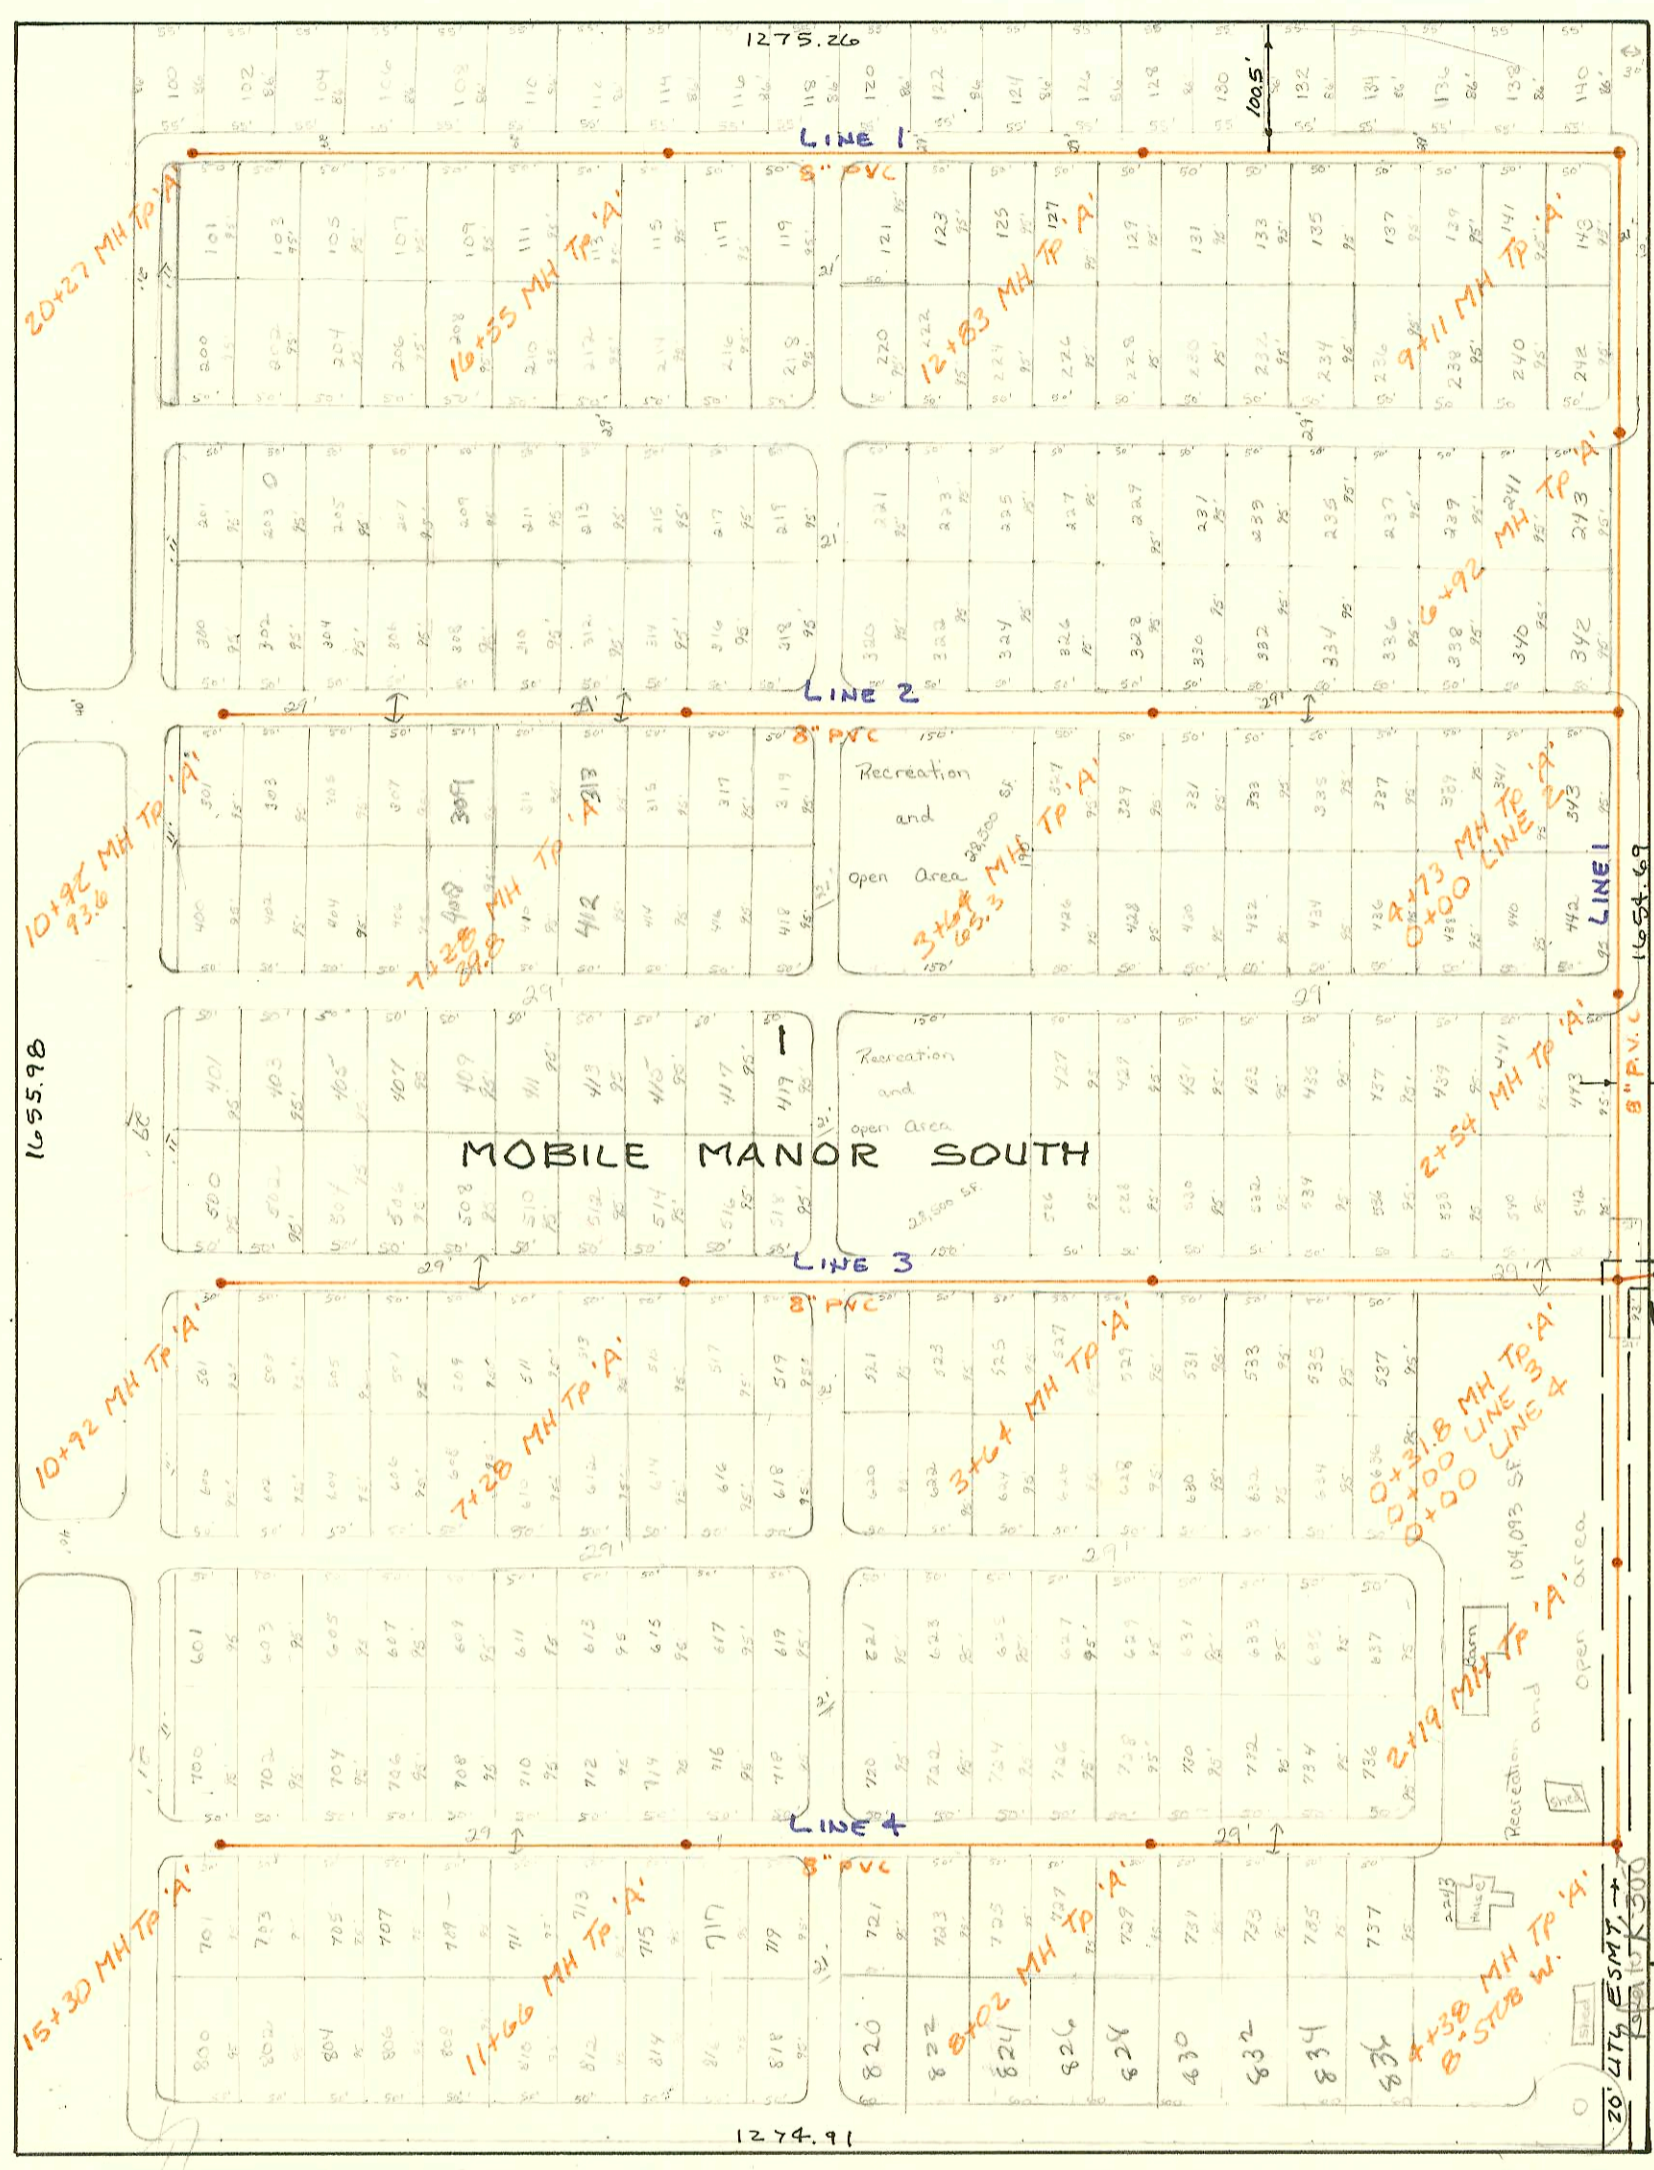

LINE 1 4173 to 20+27  
 ALL LINE 2  
 LINE 4 4138 to 15+30

ARE NOT BUILT  
 CLEAR

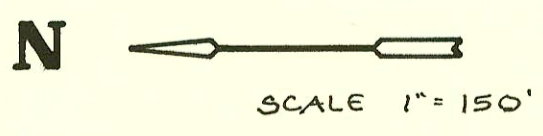

PRIV. S.S. TO SERVE LOT 1 MOBILE MANOR SOUTH  
 P.L. # 46B-76-245-80000-000-000-008  
 BUILT BY: MID-STATES CONST.  
 BOOKED 4-25-84 FROM PLAN # DRH-11  
 KW-13

8-79

CONSTRUCTION RECORD							SERVICE RECORD						
STATION	ELEVATION		Depth	MANHOLE	4-INCH "Y" BRANCHES		No. of Permit		House Number		DATE OF PERMITS		
	Ground	Grade			North West	South East	North West	South East	North West	South East	North West	South East	
PRIV. S LINE 1	S. Lot 1 MOBILE MANOR SOUTH												
0+00	93.79	84.92	8.9	0+00 EXIST.									
	92.34	85.14	7.2	0+31.8									
1+00	93.8	85.36	8.4										
2+00	93.5	85.66	7.8										
	93.0	85.82	7.2	2+54									
3+00	93.5	85.96	7.5										
4+00	93.5	86.26	7.2										
	93.0	86.47	6.4	4+73									
5+00	93.5	86.55	6.9										
6+00	93.5	86.85	6.6										
	93.0	87.13	5.9	6+92									
7+00	93.5	87.15	6.3										
8+00	93.5	87.45	6.0										
9+00	93.5	87.75	5.7										
	93.0	87.79 OUT 87.89 IN	5.2	9+11									
10+00	93.1	88.14	5.0										
11+00	93.2	88.42	4.8										
12+00	93.3	88.70	4.6										
	93.7	88.93	4.8	12+83									
13+00	93.7	88.98	4.7										
14+00	93.9	89.26	4.6										
15+00	94.1	89.54	4.6										
16+00	94.3	89.82	4.5										
	94.3	89.97	4.3	16+55									
17+00	94.5	90.10	4.4										
18+00	94.6	90.38	4.2										
19+00	94.8	90.66	4.1										
20+00	95.0	90.94	4.1										
	95.0	91.01	4.0	20+27									
LINE 2	0+00	93.0	86.57	6.4	0+00 4+37 L-1	0+31.0	0+30.0	13626 13627 13627 13625	13657 13658 13655 13654	442 443 440 441	342 343 340 341	4-30-85 4-30-85 4-30-85 4-30-85	4-30-85 4-30-85 4-30-85 4-30-85
	1+00	93.1	86.87	6.2	1+20.5	1+30.0	13623 13619 13620	13653 13654 13653	438 439 437	338 339 337	4-30-85 4-30-85 4-30-85	4-30-85 4-30-85 4-30-85	
	2+00	93.3	87.17	6.1	2+34.3	2+31.0	13617 13615 13616	13649 13670 13671	434 432 433	334 332 333	4-30-85 4-30-85 4-30-85	4-30-85 4-30-85 4-30-85	
	3+00	93.5	87.47	6.0	3+32.3	3+27.0	13613 13614	13663 13662	430 429	330 329	4-30-85 4-30-85	4-30-85 4-30-85	
		93.7	87.66	6.0	3+65.3	3+80.3	13611 13612	13666 13667	428 429	328 329	4-30-85 4-30-85	4-30-85 4-30-85	
	4+00	93.7	87.77	5.9	4+33.3	4+30.0	13609 13610	13664 13665	426 427	326 327	4-30-85 4-30-85	4-30-85 4-30-85	
	5+00	93.9	88.07	5.8		5+32.8		13663 13664 13647 13648		324 325 323 323	4-30-85 4-30-85 4-30-85 4-30-85	4-30-85 4-30-85 4-30-85 4-30-85	
	6+00	94.1	88.37	5.7				13645 13646		320 321	4-30-85 4-30-85	4-30-85 4-30-85	
	7+00	94.3	88.67	5.6	6+53.3	6+51.8	13607 13608	13643 13644	418 419	318 319	4-30-85 4-30-85	4-30-85 4-30-85	
		94.3	88.75	5.5	7+29.8	7+52.8	13604 13605	13649 13660	416 417	316 317	4-30-85 4-30-85	4-30-85 4-30-85	
	8+00	94.5	88.97	5.5	8+03.8	8+02.8	13602 13603	13641 13642	414 415	314 315	4-30-85 4-30-85	4-30-85 4-30-85	
		94.6	89.27	5.3	9+02.6	9+00.8	13600 13601	13637 13640	412 413	312 313	4-30-85 4-30-85	4-30-85 4-30-85	
	9+00	94.8	89.57	5.2	10+04.6	10+03.1	13598 13599	13637 13638	410 411	310 311	4-30-85 4-30-85	4-30-85 4-30-85	
		94.9	89.85	5.0	10+93.6	10+87.6	13594 13595	13635 13636	408 409	308 309	4-30-85 4-30-85	4-30-85 4-30-85	
							13593 13594	13633 13634	406 407	306 307	4-30-85 4-30-85	4-30-85 4-30-85	
							13592 13593	13631 13632	404 405	304 305	4-30-85 4-30-85	4-30-85 4-30-85	
							13591 13592	13629 13630	402 403	302 303	4-30-85 4-30-85	4-30-85 4-30-85	
							13589 13590	13628 13629	400 401	300 301	4-30-85 4-30-85	4-30-85 4-30-85	

NOT CLEAR

(CONT NEXT PAGE)

Tap #18139 210 W. Mac Arthur (connect for swim pool)  
(Tied into existing line stubbed across street)

