
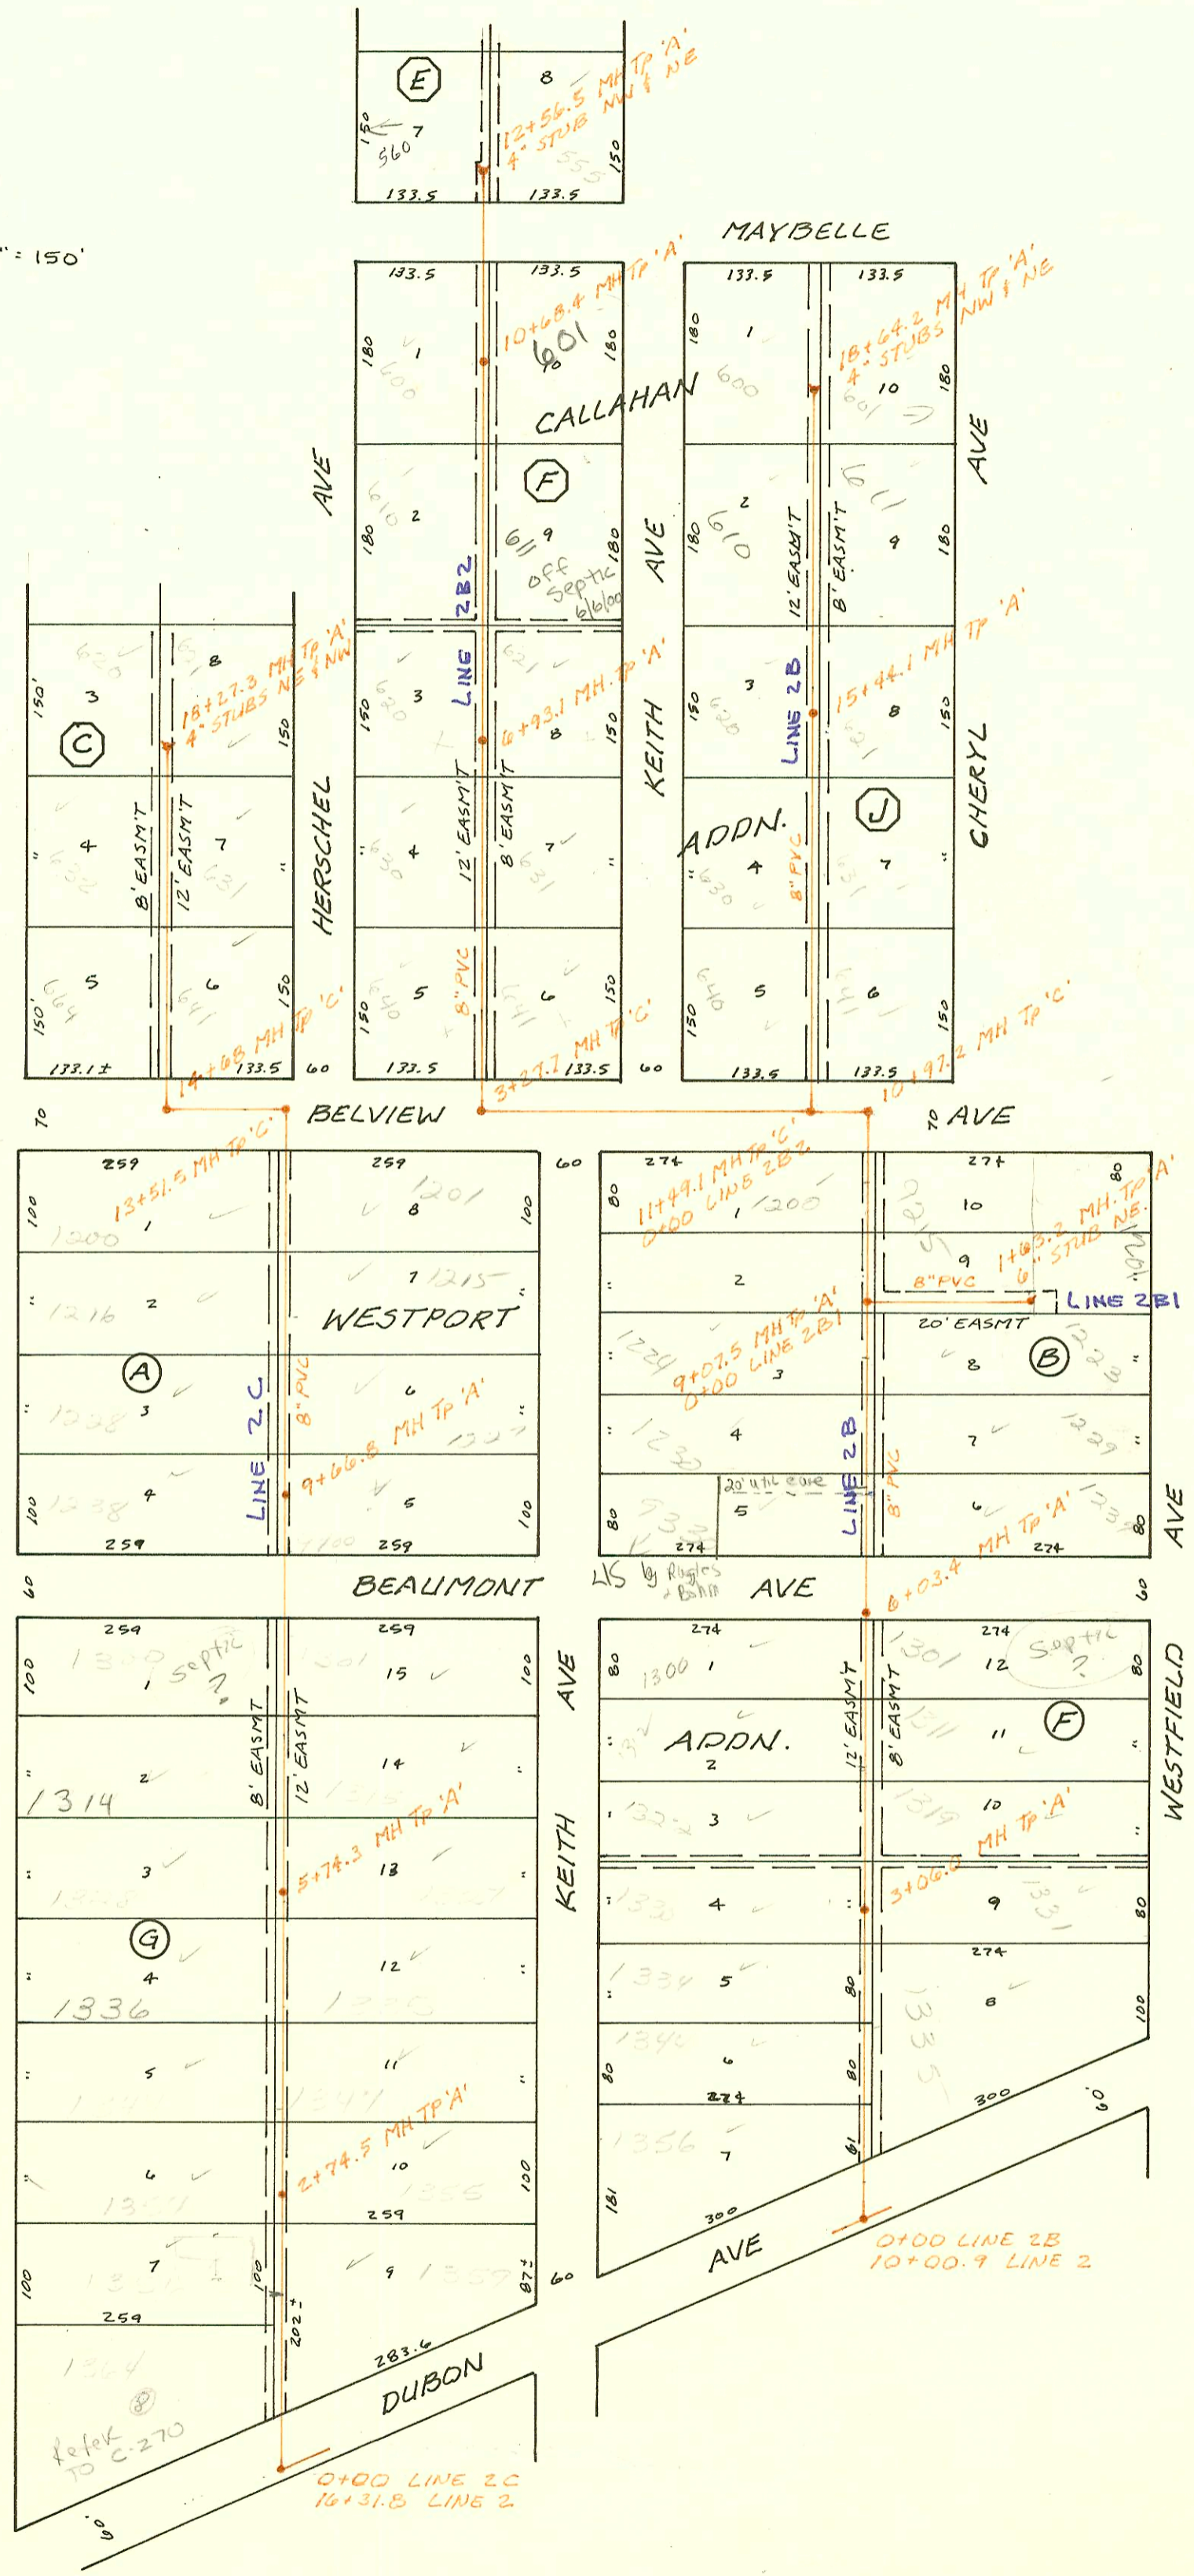


LAT 1, MAIN 8, SWI
468-76-245-81160-000-000-001

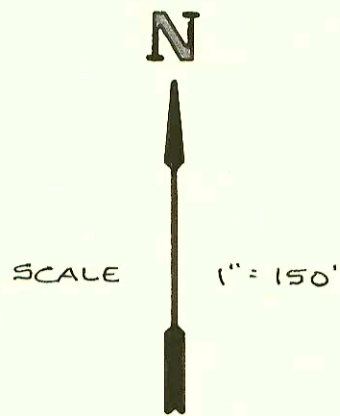

Plot
0-000

LAT 1, MAIN
LINE 2B

LINE 2B1

LINE 2B2

CONSTRUCTION RECORD						SERVICE RECORD						
STATION	ELEVATION		Depth	MANHOLE	4-INCH "Y" BRANCHES		No. of Permit		House Number		DATE OF PERMITS	
	Ground	Grade			North West	South East	North West	South East	North West	South East	North West	South East
IN 8, SW I (CONT.)												
0+00	140.48	130.76	9.7	0+00 10+00.9 L-2								
1+00	140.7	131.49	9.2									
2+00	141.5	132.22	9.3									
3+00	142.6	132.95	9.6									
	142.87	132.99	9.9	3+06.0								
4+00	143.9	133.69	10.2									
5+00	145.5	134.44	11.1									
6+00	147.3	135.19	12.1									
	147.68	135.22	12.5	6+03.4								
7+00	149.5	136.00	13.5									
8+00	150.5	136.80	13.7									
9+00	149.9	137.60	12.3									
	149.56	137.66	11.9	0+00 L-2B1 9+07.5								
10+00	149.3	137.80	11.5									
	149.26	137.94	11.3	10+97.2								
11+00		138.00										
	149.34	138.35 OUT 138.46 IN	11.0	0+00 L-2B2 11+49.1								
12+00	148.71	138.71	10.0									
13+00	149.0	139.20	9.8									
14+00	149.2	139.69	9.5									
15+00	149.1	140.18	8.9									
	149.41	140.40	9.0	15+44.1								
16+00	149.4	140.85	8.5									
17+00	150.5	141.67	8.8									
18+00	151.9	142.48	9.4									
	152.75	143.00	9.8	18+64.2								
0+00	149.56	138.62	11.5	0+00 9+07.5 L-2B								
1+00	150.6	140.10	10.5									
	150.96	141.41	9.6	1+63.2								
0+00	149.34	139.96	9.4	0+00 11+49.1 L-2B								
1+00	149.9	140.47	9.4									
2+00	151.6	140.98	10.6									
3+00	153.6	141.49	12.1									
	154.28	141.63	12.7	3+27.7								
4+00	154.39	141.99	12.4									
5+00	153.4	142.49	10.9									
6+00	152.5	142.99	9.5									
	153.46	143.46	10.0	6+93.1								
7+00	153.2	143.50	9.7									
8+00	154.1	144.09	10.0									
9+00	154.7	144.68	10.0									
10+00	154.7	145.27	9.4									
	154.63	145.67	9.0	10+68.4								
11+00	154.6	145.87	8.7									
12+00	154.62	146.52	8.1									
	154.06	146.89	7.2	12+56.5								