



SI 12/69  
Refer to Slo  
Cekmit. 0A13  
4" stubs sep.  
Line slo sep.  
Rear of exist house -  
Dbe Reused (for  
New house  
BSR

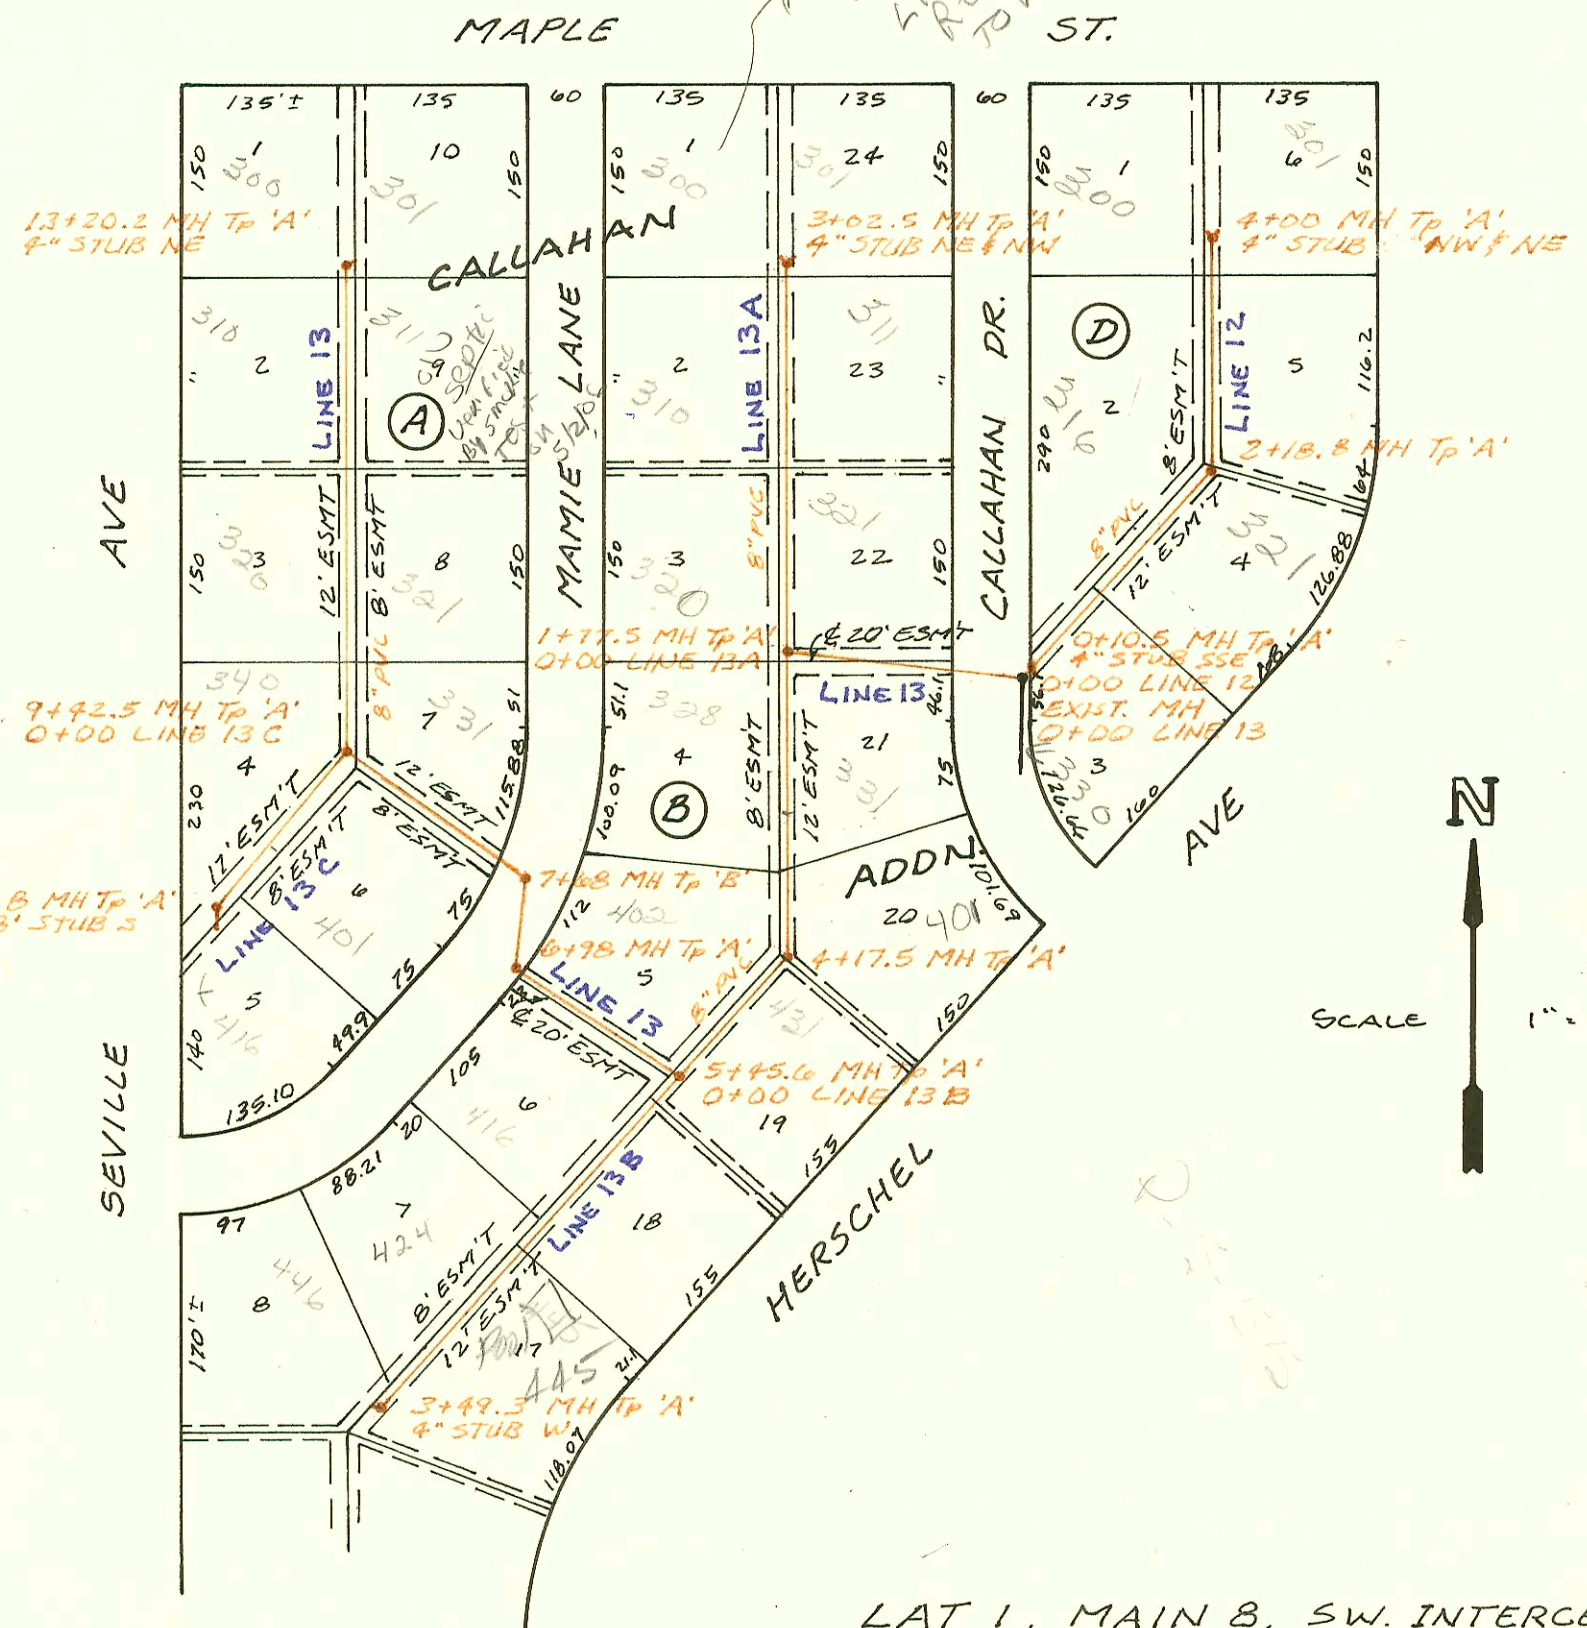

LAT 1, MAIN 8, SW. INTERCEPTOR  
468-76-245-81160-000-000-001

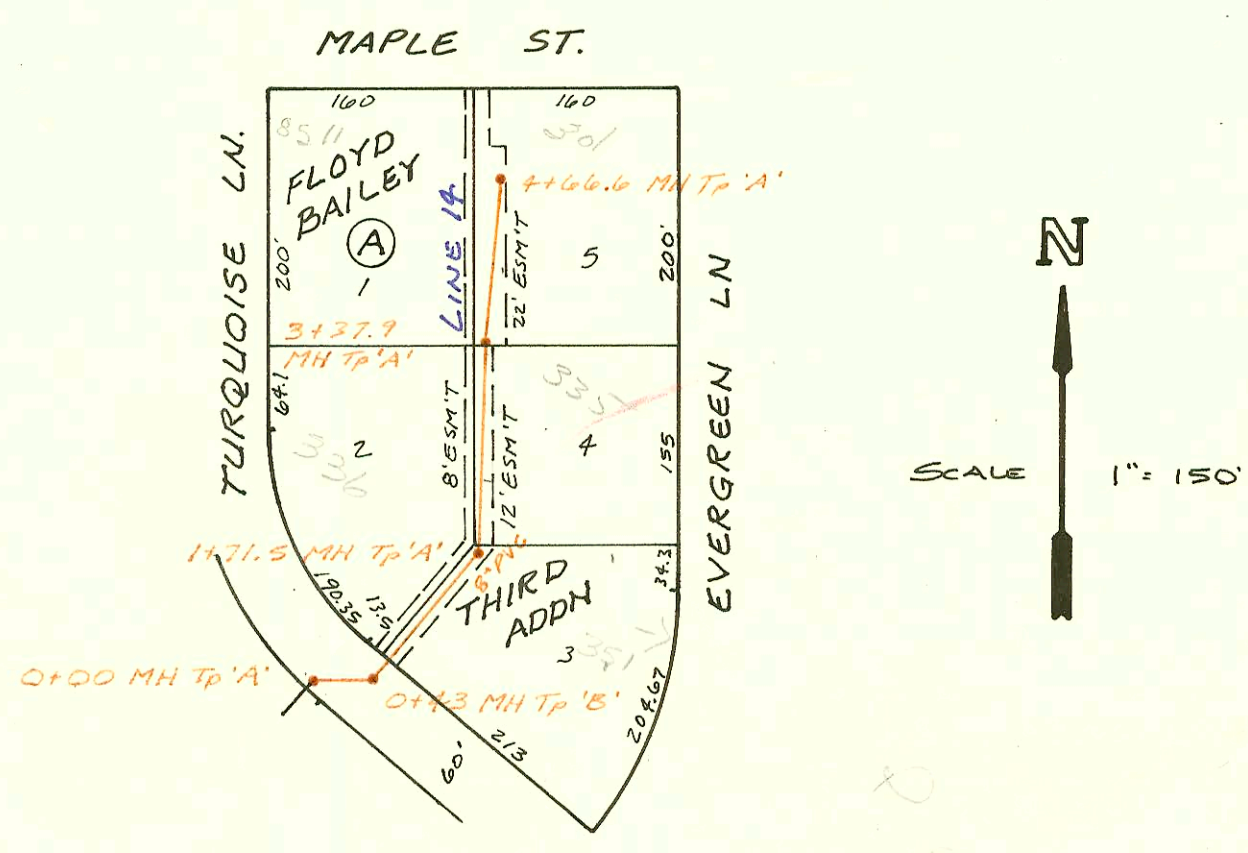

CONSTRUCTION RECORD						SERVICE RECORD						
STATION	ELEVATION		Depth	MANHOLE	4-INCH "Y" BRANCHES		No. of Permit		House Number		DATE OF PERMITS	
	Ground	Grade			North West	South East	North West	South East	North West	South East	North West	South East
LAT 1, MAIN 8, SW I												
LINE 12	0+00	154.71	144.49	10.2	0+00 EXIST.							
		155.07	144.67	10.4	0+10.5	4" STUB SSE		14787		300 S. Ballala		9-22-85
	1+00	156.6	145.67	10.9						301 Mamie		11-30-85
						1+52 4" RIS. W. 1+49 4" RB. E.		15026				
	2+00	157.9	146.78	11.1								
		158.39	146.99	11.4	2+18.8							
	3+00	159.5	147.81	11.7		2+49 4" RIS. W. 2+46 4" RB. E.	12702		316 S. Mikan		12-6-84	
	4+00	158.99	148.82	10.2	4+00.0	4" STUB NW 4" STUB NE	12703		300 Mamie		12-6-84	
LINE 13	0+00	154.71	139.38	15.3	0+00 EXIST. 0+00 L-12							
	1+00	154.2	139.83	14.4								
			153.34	140.17	13.2	0+00 L-13A 1+77.5						
	2+00	152.4	140.26	12.1								
	3+00	151.8	140.68	11.1		3+00 4" RIS. W. 3+55 RIS. E.	12162		328 Mamie		10-2-84	
	4+00	150.6	141.09	9.5		3+03 4" RB. E. 3+73.9	12171		331 S. Mamie 401 S. Mamie		10-4-84	12-22-86
			150.48	141.16	9.3	4+17.5	4+55.6 4+98.6	12900	12969	402 Mamie 431 Mamie	1-7-85	1-22-85
	5+00	150.5	141.58	8.9					14114	416 Mamie		6-27-85
			150.60	141.81	8.8	5+45.6 0+00 L-13B						
	6+00	150.9	142.30	8.6								
			151.73	143.19	8.5	6+98.0						
	7+00	151.3	143.20	8.1								
			151.62	143.56	8.1	7+68.0						
8+00	152.7	143.69	9.0			4" SCH 40 8+33.5		99-5942-7	401 S. Mamie		4-21-99	
9+00	153.3	144.11	9.2									
		154.14	144.29 007 144.35 1W	9.9	9+42.5 0+00 L-13C							
10+00	153.6	144.58	9.0			4" SCH 40 10+30.5	12570		321 Mamie		11-13-84	
						10+53.5	14814		320 S. Mamie		10-1-85	
11+00	153.5	144.99	8.5									
12+00	153.4	145.39	8.0			12+35.23	12118		310 Mamie		9-26-84	
13+00	153.6	145.80	7.8			13+14 4" RIS. W.						
		154.37	145.88	8.5	13+20.2	MHTAP. 4" STUB NE	12823	19163	300 Sewille 301 S. Mamie	3-21-85	9-30-87	
LINE 13A	0+00	153.34	142.94	10.4	0+00 1+77.5 L-13							
1+00	153.2	143.94	9.3		0+62.0 0+63.0		13029	13028	300 Mamie 321 Mamie	2-5-85	2-5-85	
2+00	154.2	144.93	9.3			2+37.5 TH 2+08.5	17019	12672	310 Mamie 311 S. Mamie	10-1-86	11-29-84	
3+00	154.4	145.93	8.5				2004	7	300 Mamie 301 S. Mamie	4-9-84	10-31-84	
		154.95	145.95	9.0	3+02.5 0+00 5+45.6 L-13	4" STUB NE 4" STUB NW	12397	12129				
LINE 13B	0+00	150.60	142.45	8.2								
1+00	150.2	142.66	7.5									
2+00	151.0	142.88	8.1									
3+00	151.9	143.09	8.8			3+07.3 TH 3+49.3	26746		424 S. Mamie 446 Mamie	10-13-90	10-25-84	
		153.06	143.20	9.9	3+02.5 0+00 9+42.5 L-13	4" STUB W	12385					
LINE 13C	0+00	154.14	144.43	9.7								
1+00	154.2	145.52	8.7			4+61 TH	14768		340 S. Mamie		10-1-85	
		154.51	146.17	8.3	1+59.8	4" x 18" STUB S.		12365	416 Mamie		10-22-84	
LINE 14	0+00	141.75	134.35	7.4	0+00							
			140.78	134.46	6.3	0+43						
1+00	141.6	134.72	6.9									
		143.13	135.04	8.1	1+71.5		1+89.5 TH 2+21.0	17487	9791	351 S. Mamie 335 Mamie	2-17-86	12-5-83
2+00	143.3	135.14	8.2			2+50.0 TH	9868		336 Mamie		12-12-83	
3+00	143.1	135.50	7.6									
		142.98	135.63	7.4	3+37.9							
4+00	142.4	135.83	6.6			1+05.9 TH MHTAP.	10822	10822	301 Mamie		5-9-84	
		142.49	136.04	6.5	4+66.6		10825		301 Mamie		5-9-84	

SWR 2009-01407 5/18/04 300 S. Mamie L10 (New Home)  
 Padged NYC