

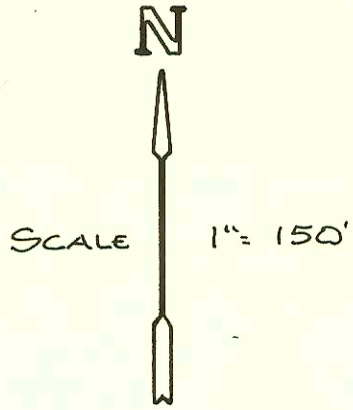


LAT 3, MAIN 11, SW INTERCEPTOR  
468-76-245-81106-000-000-001  
BUILT BY: UTILITY CNTR.  
BOOKED 11-29-84 FROM DCD-203

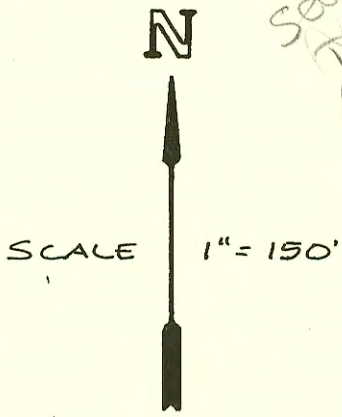

Plot 463

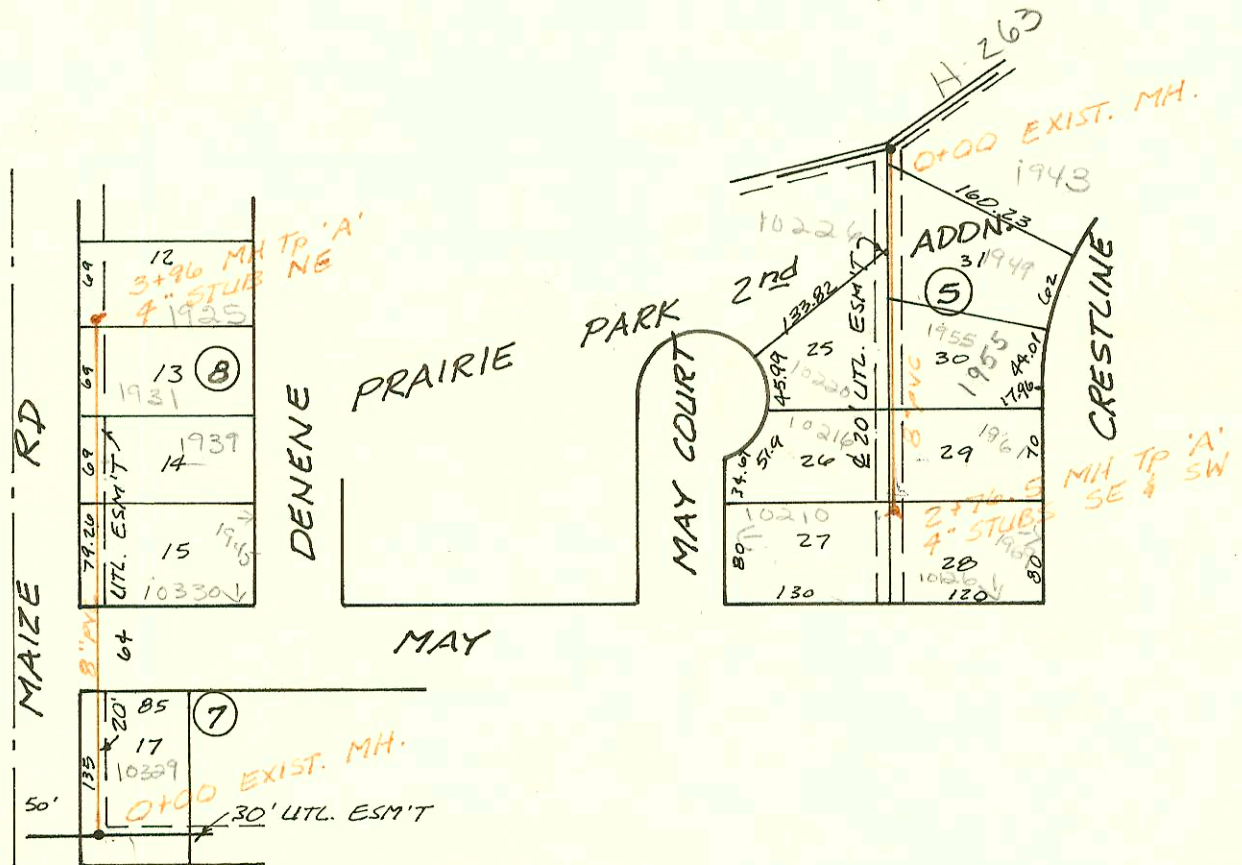

0+00

# 302  
Sewer main  
Tvd Lat #2  
and found fault  
Tvd Lat #3  
73' 50"  
MH 5748710-  
could not  
determine  
how far it  
went  
10/28/84

0+00 LINE 4  
MH TP 'A'

PRIV. SANITARY SEWER EXT. TO SERVE  
PHASE I, LOTS 2 & 3 TIMBER GROVE  
LAKES ADDN.  
468-76-245-80000-000-000-008  
BUILT BY MID-STATES CONST.  
BOOKED 11-30-84 FROM 11-E

Plot 4-47

901 D Maize Rd # 314  
# 23868 - 6/16/84 FOR LOTS 105-108 (MH 31964 T1+D TO SUBD OUT OF SW CORNER OF MH)

909 D Maize Rd

