
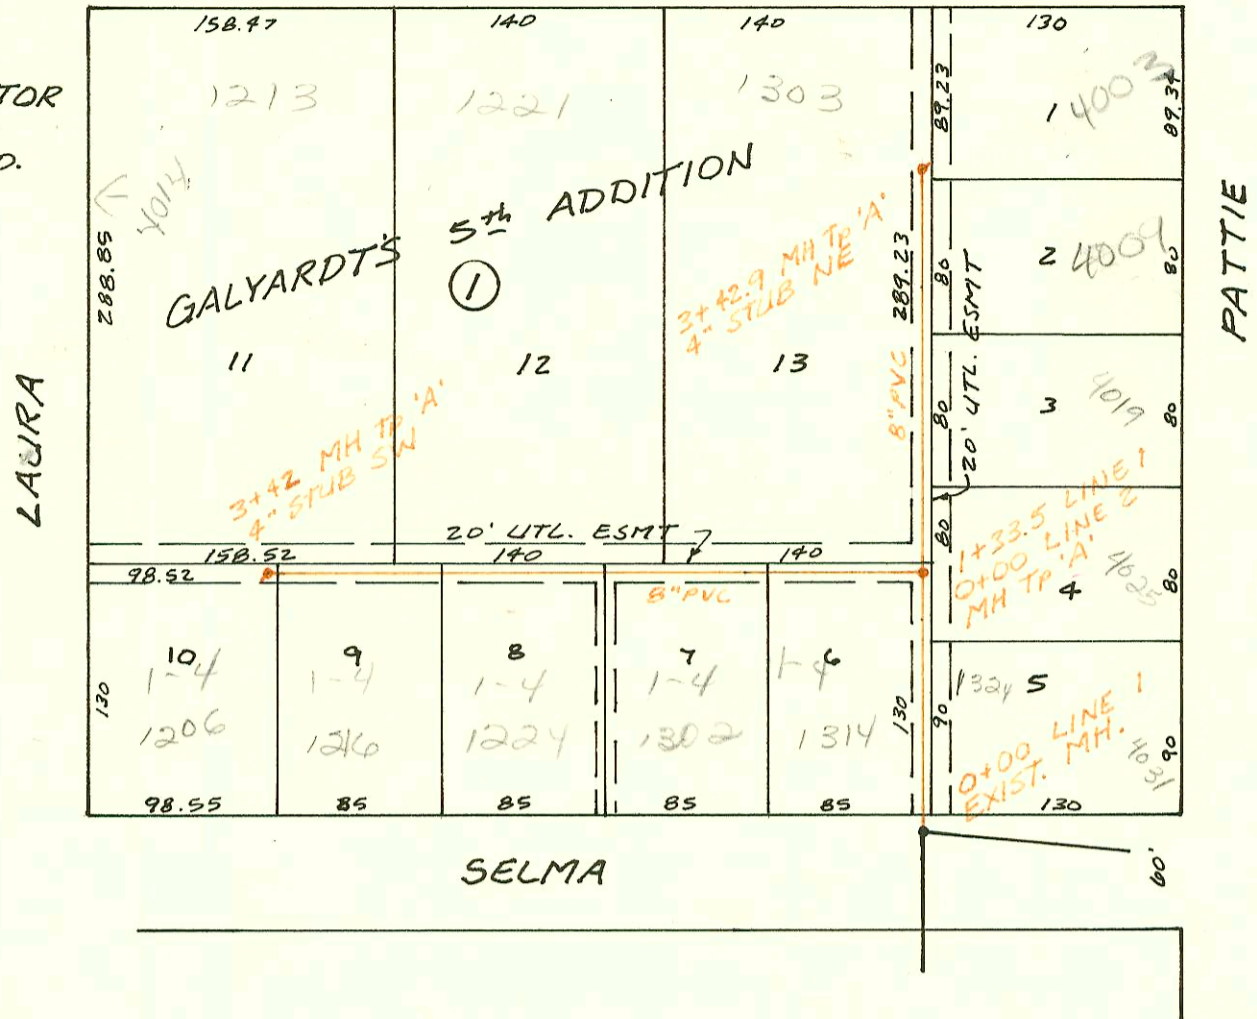



MACARTHUR

LAT 49, MAIN 1, SW. INTERCEPTOR  
 468-76-245-80511-000-000-001  
 BUILT BY STANNARD CONST. CO.  
 Booked 12-4-84 FROM AG10

9-81

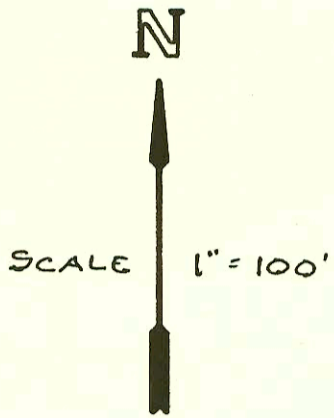

MACARTHUR

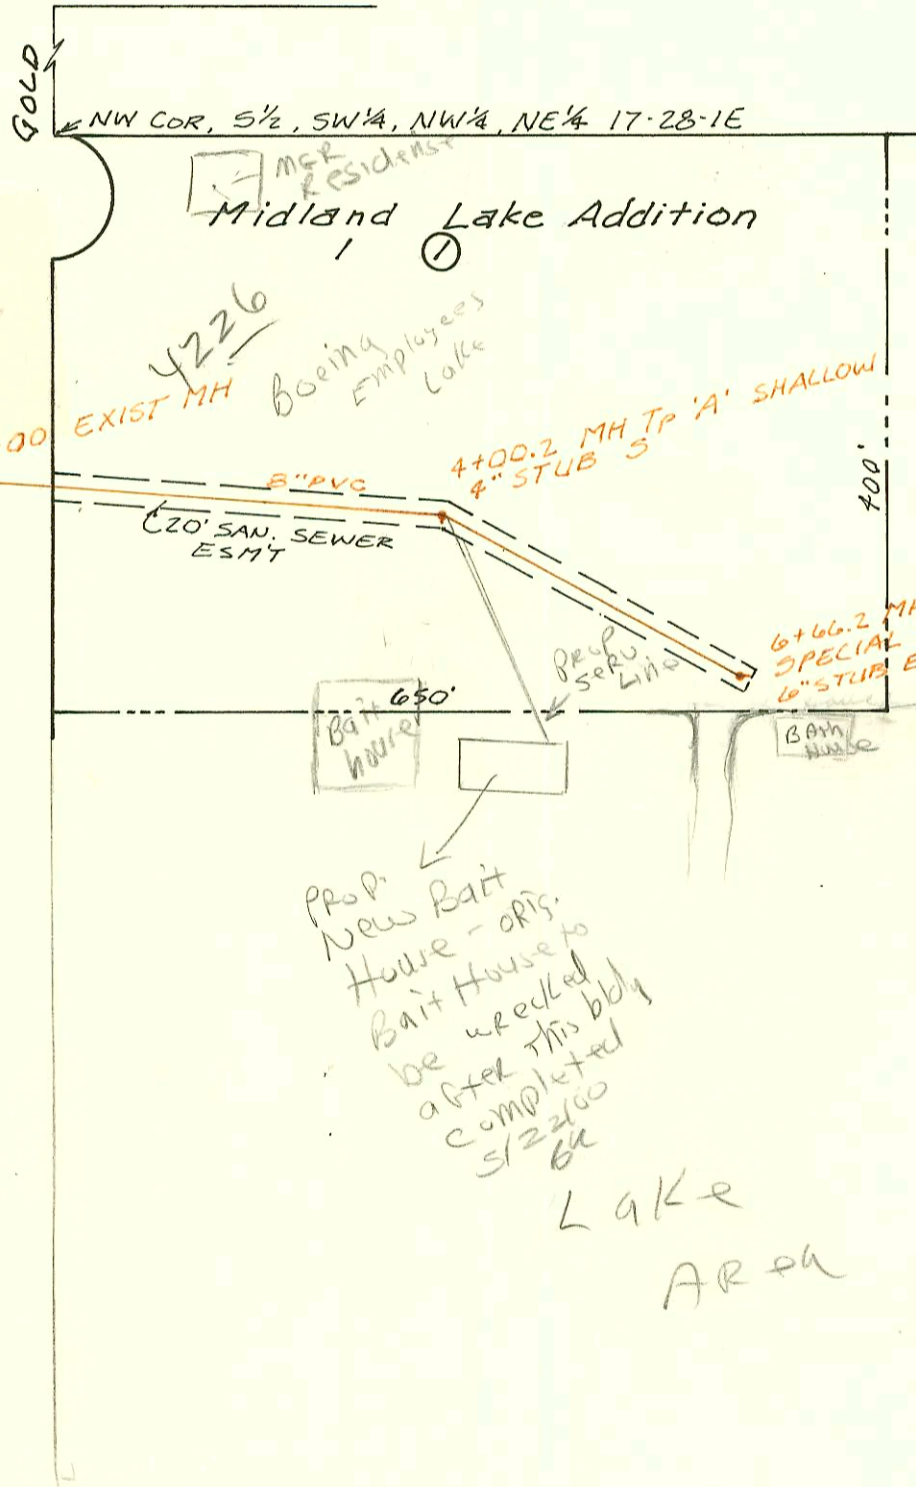

LAT 177, SW. INTERCEPTOR  
 468-76-245-81214-000-000-001  
 Built By Mid-States Const.  
 Booked 3-27-85 From TCD-38

MP

