


LATERAL 71 SUB. 5 S.S. 22
 W. B. CARTER CONSTR. CO. 1-20-59
 BK. NO. K-58 PROJ. NO. C 28-78

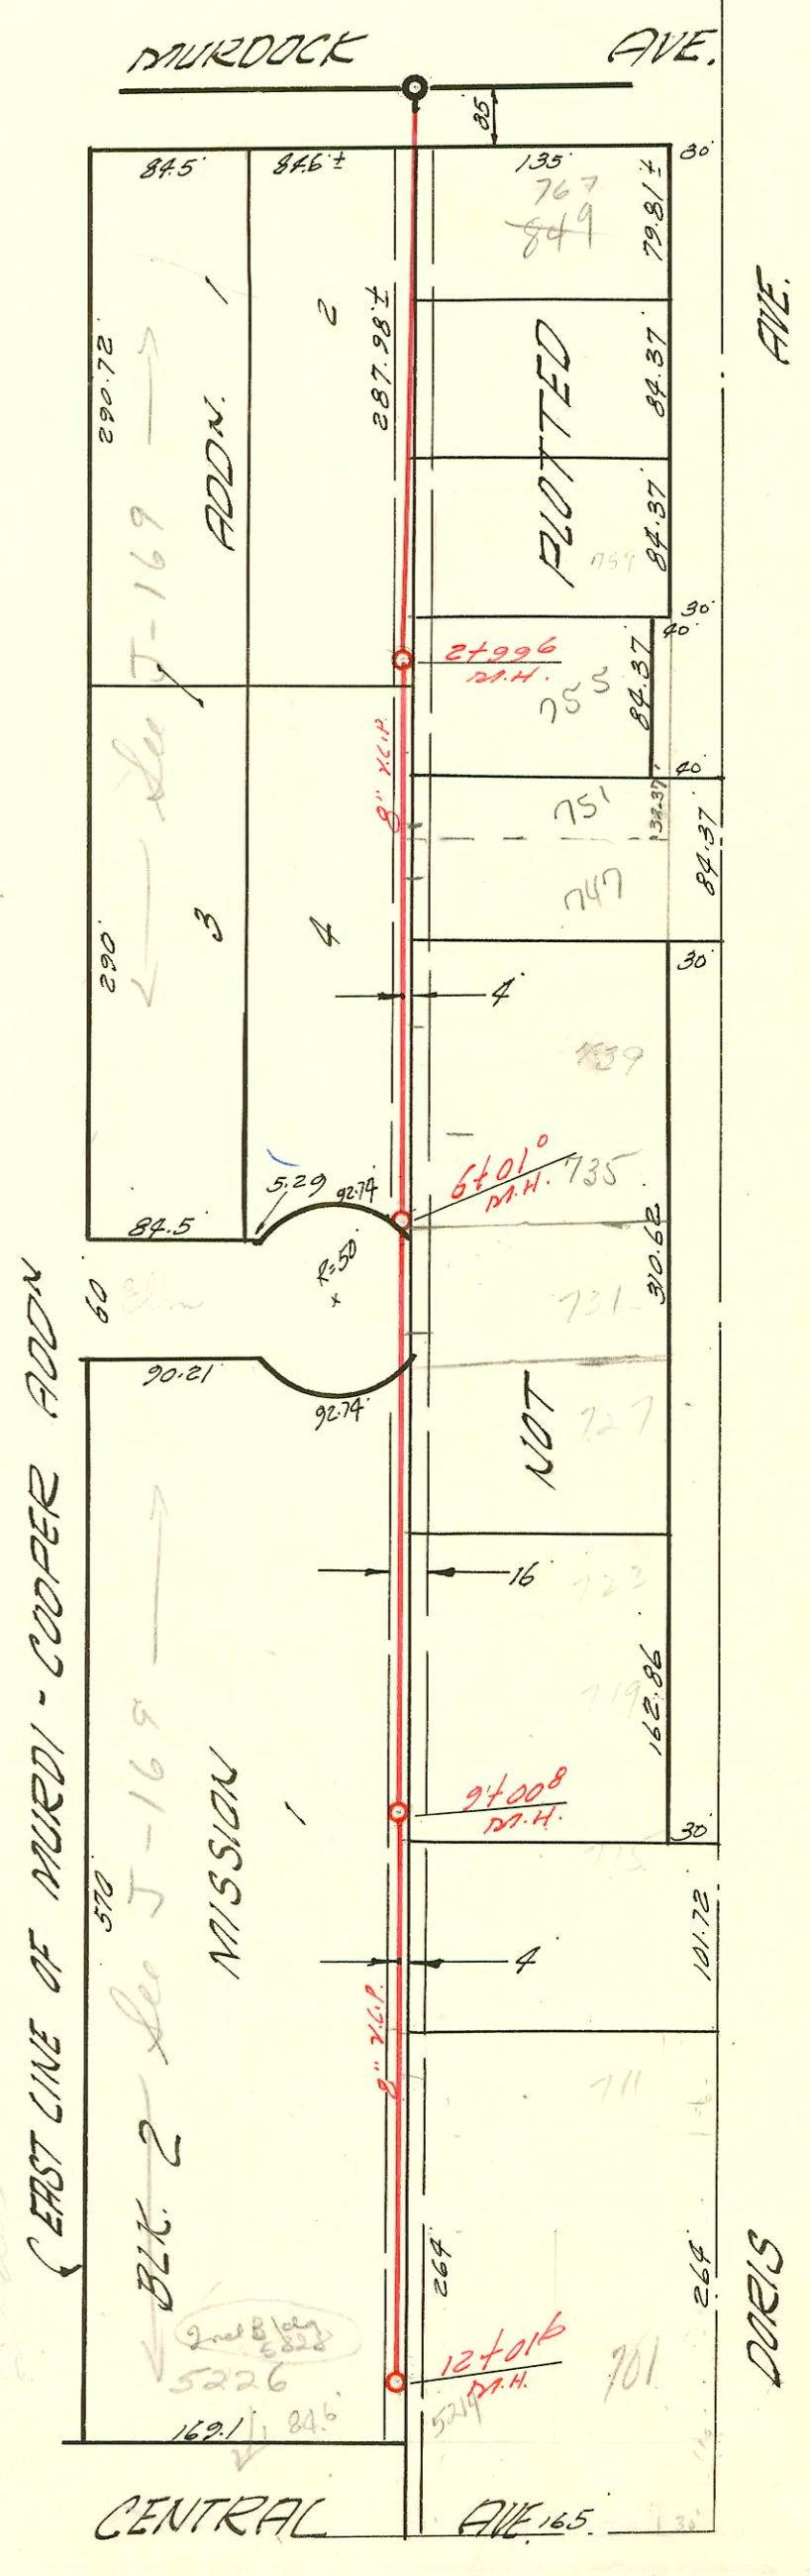

LATERAL 56 SUB. 5 S.S. 22
 W. B. CARTER CONSTR. CO. 1-20-59
 BK. NO. K-44 PROJ. NO. C 28-56

CONSTRUCTION RECORD						SERVICE RECORD						
STATION	ELEVATION		Depth	MANHOLE	4-INCH "Y" BRANCHES		No. of Permit		House Number		DATE OF PERMITS	
	Ground	Grade			North West	South East	North West	South East	North West	South East	North West	South East
LAT. 71 SUB 5 0+00	123.3	114.18	9.1	Existing MH.	+64°	+50°	15636	15636	801 N. Anna	801 N. Anna	9-17-62	5-15-62
1+00	125.3	114.58	10.7		+49°	+36°	11869	11869	805 N. Anna	805 N. Anna	7-19-59	11-17-59
2+00	126.1	114.98	11.1		+31°	+21°	13620	13620	809 N. Anna	809 N. Anna	10-22-62	11-14-60
3+00	125.3	115.38	9.9	2+996	+06°	+08°	15023	15023	813 N. Anna	813 N. Anna	12-10-62	12-7-61
4+00	125.0	115.78	9.2		+61°	+63°	10970	10970	818 R. Anna	818 R. Anna	9-5-62	7-21-59
5+00	125.7	116.18	9.5		+48°	+46°	9099	9099	846 N. Anna	846 N. Anna	2-20-64	2-10-59
6+00	123.7	116.58	7.1	6+00°	+33°	+31°	14155	14155	846 N. Anna	846 N. Anna	2-16-59	5-8-61
7+00	122.8	116.83	6.0		+68°	+86°	12620	12620	858 N. Anna	858 N. Anna	2-16-59	4-7-60
8+00	122.7	117.08	5.6		+48°	+70°	9241	9241	863 N. Anna	863 N. Anna	3-29-60	2-24-59
9+00				9+00°	+41°	+43°	15250	15250	899 N. Anna	899 N. Anna	2-27-59	3-6-62
10+00	123.1	117.33	5.8		+17°	+19°	11601	11601	913 N. Anna	913 N. Anna	10-7-59	9-12-62
11+00	123.2	117.58	5.6		+27°	+29°	16090	16090	917 N. Anna	917 N. Anna	3-6-59	2-23-62
12+00	123.6	117.83	5.8		+84°	+86°	15697	15697	921 N. Anna	921 N. Anna	6-12-62	5-31-62
LAT. 56 SUB 5 0+00	124.0	114.50	9.5	Existing MH.	+79°	+77°			844 N. Anna	844 N. Anna		
1+00	123.1	114.70	8.4		+31°	+29°	9041	9041	845 N. Anna	845 N. Anna		1-16-59
2+00	123.9	114.90	9.0		+49°	+47°	9040	9040	842 N. Anna	842 N. Anna		1-16-59
3+00	124.5	115.10	9.4	2+996	+51°	+49°	2000-00939	2000-00939	844 N. Anna	844 N. Anna	4-17-60	1-16-59
4+00	124.0	115.30	8.7		+16°	+14°	9037	9037	845 N. Anna	845 N. Anna		1-16-59
5+00	124.1	115.50	8.6		+02°	+00°	9036	9036	844 N. Anna	844 N. Anna	6-13-61	1-16-59
6+00	124.3	115.70	8.6	6+01°	+38°	+36°	9035	9035	844 N. Anna	844 N. Anna		1-16-59
7+00	123.8	115.90	7.9		+89°	+91°	9034	9034	844 N. Anna	844 N. Anna		1-16-59
8+00	123.3	116.10	7.2		+64°	+62°	9033	9033	844 N. Anna	844 N. Anna		1-16-59
9+00	123.5	116.30	7.2	9+00°	+96°	+94°	9032	9032	844 N. Anna	844 N. Anna		1-16-59
10+00	122.8	116.50	6.3		+90°	+88°	9031	9031	845 N. Anna	845 N. Anna		1-16-59
11+00	123.3	116.70	6.7		+46°	+44°	9030	9030	844 N. Anna	844 N. Anna		1-16-59
12+00	123.5	116.90	6.6	12+01°	+94°	+92°	9029	9029	844 N. Anna	844 N. Anna		1-16-59
					+80°	+78°	14173	14173	711 N. Anna	711 N. Anna		5-11-61
					+44°	+42°	15699	15699	711 N. Anna	711 N. Anna		5-31-62
					+98°		12120	12120	844 N. Anna	844 N. Anna		12-12-60

12930 Tap 5214 W. Central Justice Bldg. 4-10-60 (1172.6)
 #15636 Tap 801 N. Anna - Frederick Bldg. 5-15-62 (0+48)