




EASTGATE SHOPPING CENTER  
PRIVATE CONTRACT 3-2-59  
BK. NO. R-56

Not maintained by City  
Privately Maintained  
Line by Eastgate Mall  
Sewer permits and inspections  
are required.

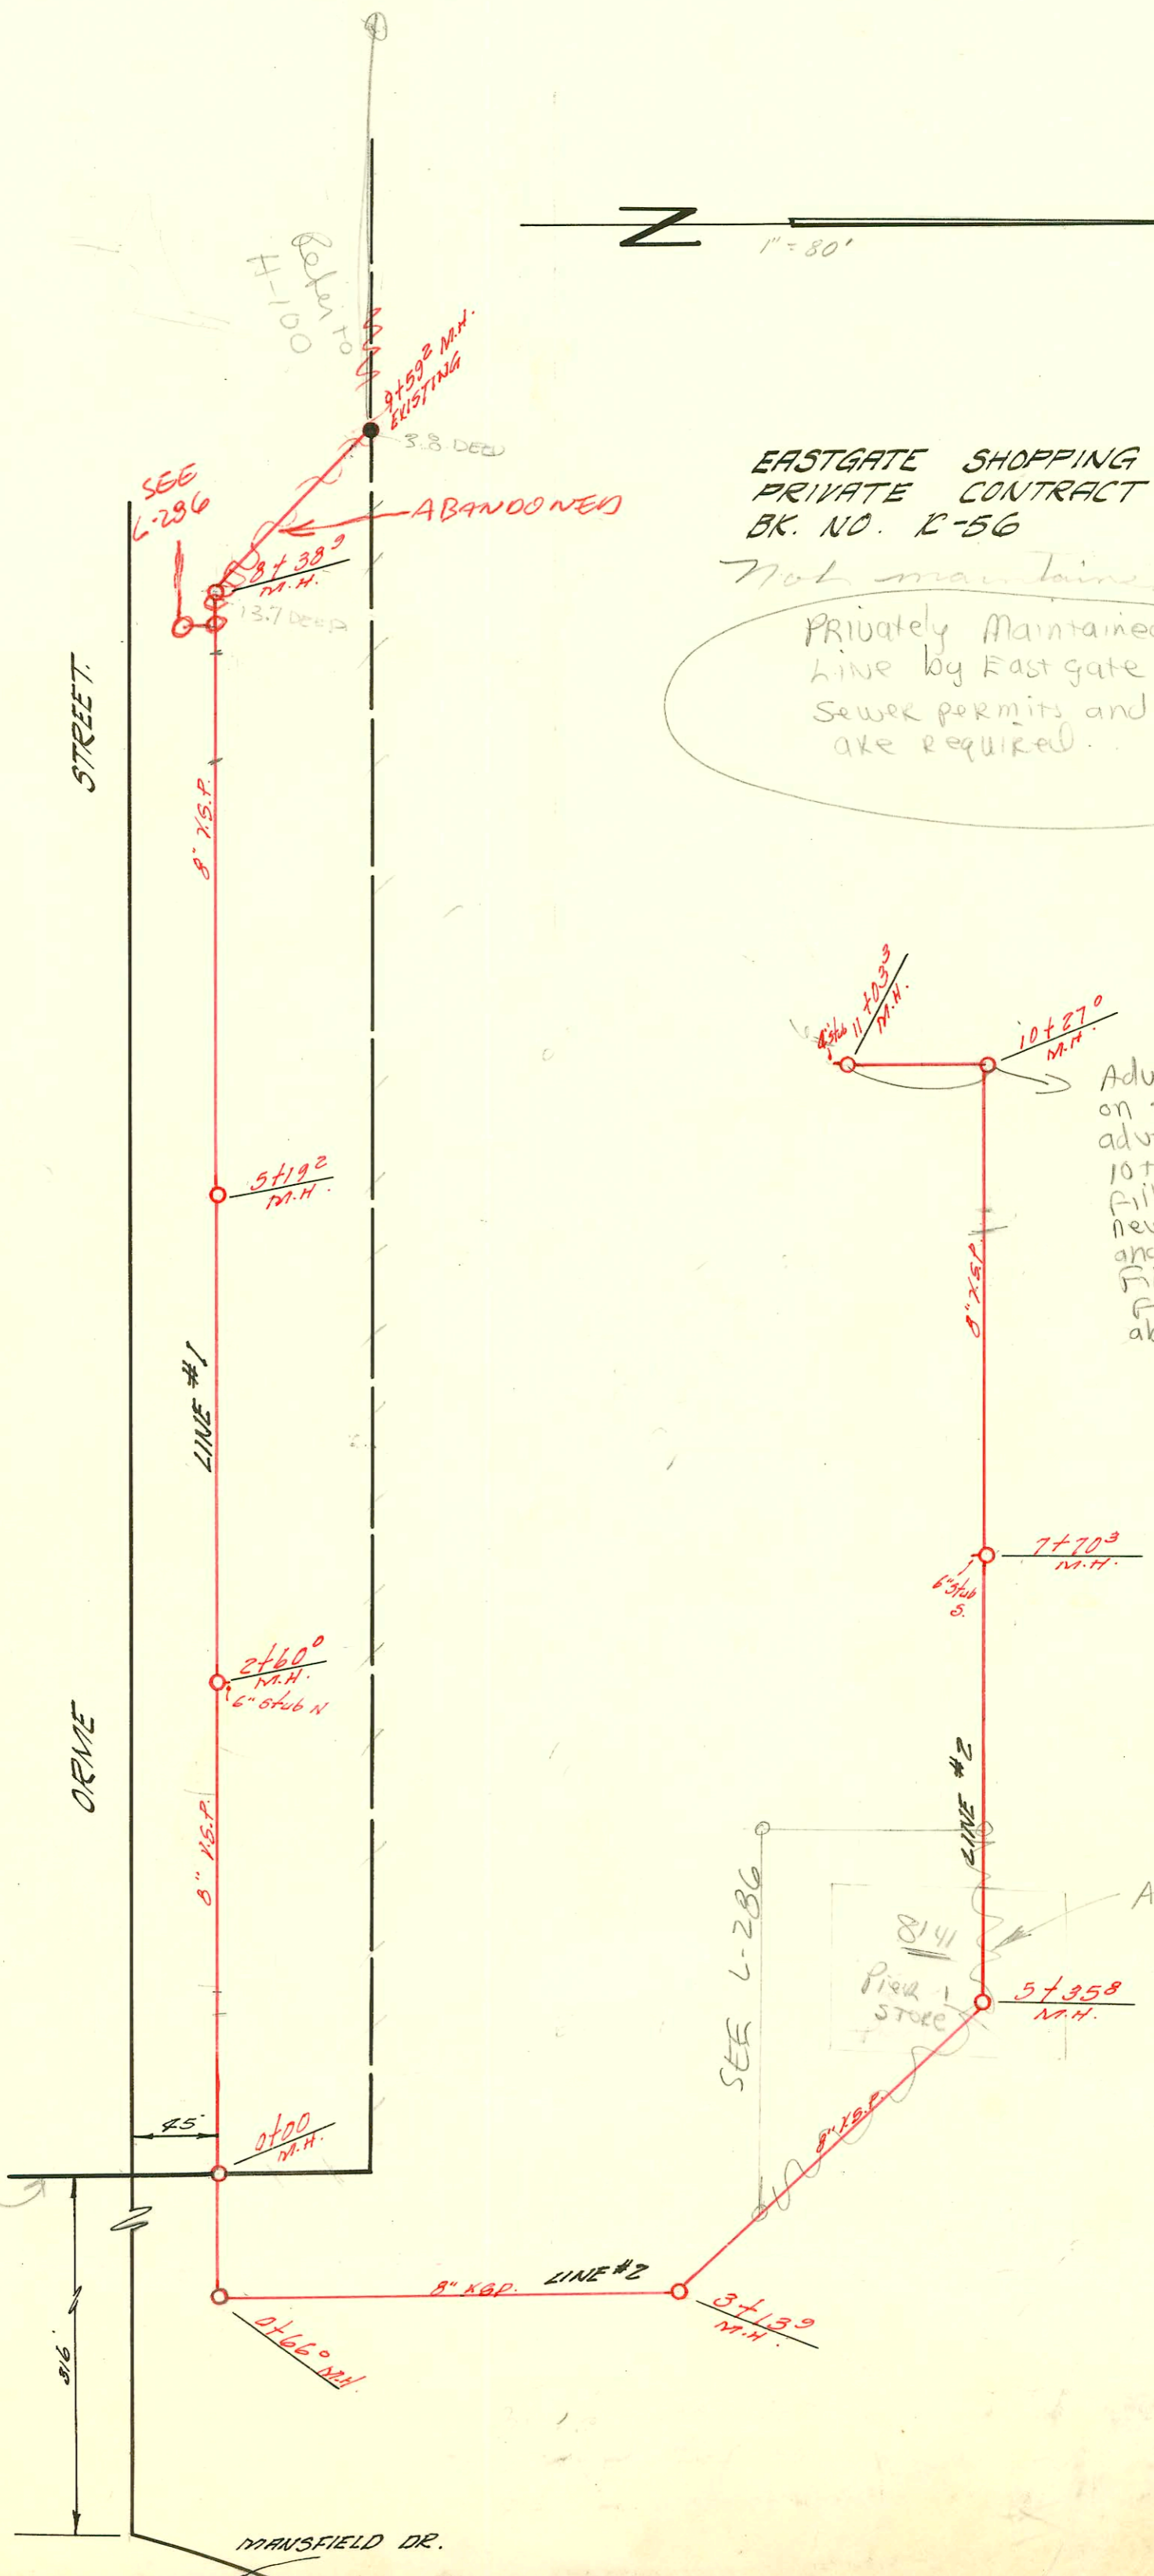

Advised by Vicki (CING DIV)  
on 3-12-91 that C.J. Lefler  
advised M117033 and  
10+27 were abandoned and  
filled by Contractor on  
New Bldg with no inspection  
and verification by an E.I.N.S.  
Firm and that New bldg  
Foundation took over  
abandoned M1's.  
3-12-91  
BR

ABANDONED

