


KELLOGG ST. (U.S. 54 HIGHWAY)

SO. EDGE OF KELLOGG PAVEMENT

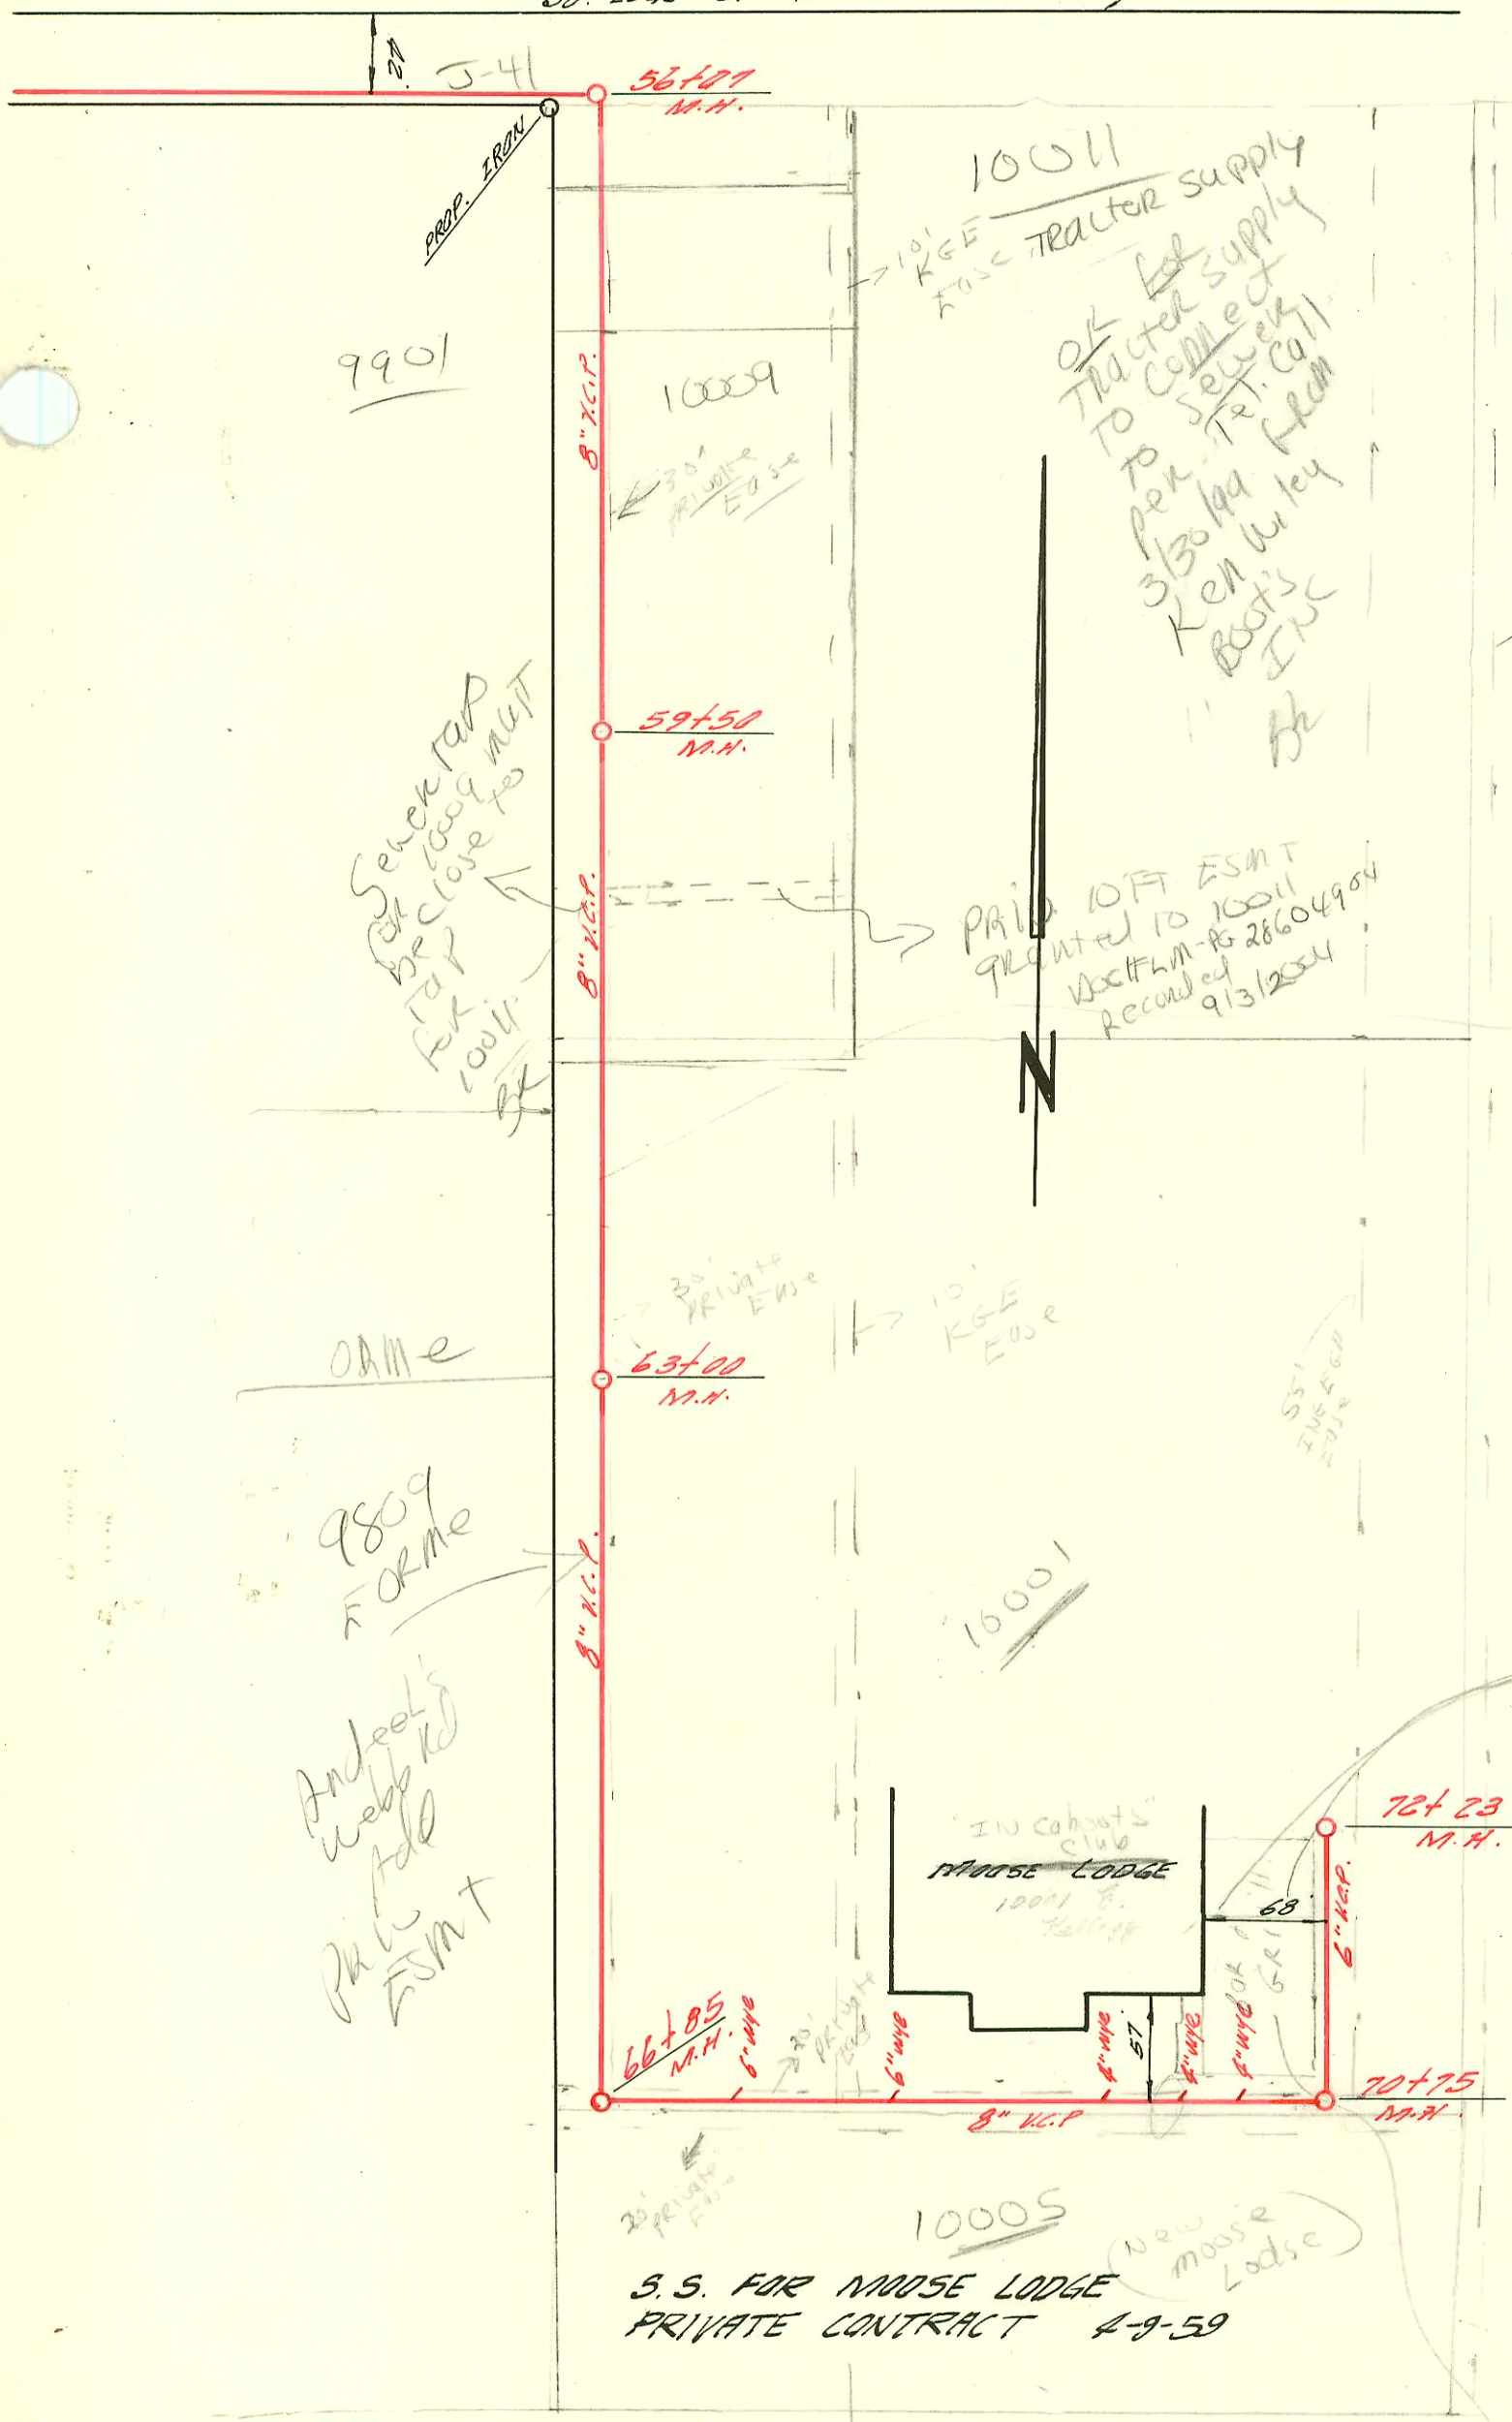

9901

10009

10011  
 10' KGE  
 FASE TRACTOR SUPPLY  
 OK TRACTOR SUPPLY  
 TO CONNECT  
 TO PER. TR. CALL  
 3130 W. Hwy  
 Ken Wilkey  
 BOOTS  
 INC  
 BK

SEWER TAP  
 FOR 10009 MHT  
 FOR 10011  
 BK

PRIVATE 10 FT ESMT  
 GRANTED TO 10011  
 V. B. THOMAS - PG 28604904  
 RECORDED  
 9131254

JUSTO  
 CALL KAREN LIDGE  
 MID KANSAS  
 #684-9600  
 RELOCATE OF  
 PRIVATE LINE  
 BSK  
 3-11-01

0A11e

9809 FORME

ANDREAS  
 WEBB RD  
 ADD  
 ESMT

10001

IN CAHONS  
 CLUB  
 MOOSE LODGE  
 10001 E.  
 KELLOGG

12-3-98  
 ADJUST 15' FOR  
 PERM. MHT FOR  
 W/O PERMISS. FROM MOOSE LODGE  
 BK

Have already been  
 account for and main  
 for use for 11-10-69

Prop. H. H.  
 (10225)  
 2/14/77

10005  
 S.S. FOR MOOSE LODGE  
 PRIVATE CONTRACT 4-9-59

SOEPS. 41  
 FOR REQUIREMENTS  
 TO CONNECT TO THIS  
 PRIVATE LINE  
 BK 2/15/89

10001 E Kellogg given  
 following address  
 3/3/2000  
 IN CAHONS 10001 E Kellogg STE 111  
 PACKET SPORT GRILL 10001 E Kellogg STE 115

92-33799-7 10/2/92 10001 E. Kellogg. Rep. BK aka p/hy - (4 inch 40 P.C. Tap 8' 13' MHT)

CONSTRUCTION RECORD						SERVICE RECORD						
STATION	ELEVATION		Depth	MANHOLE	4-INCH "Y" BRANCHES		No. of Permit		House Number		DATE OF PERMITS	
	Ground	Grade			North West	South East	North West	South East	North West	South East	North West	South East
		out 171.66 in 171.76	9.7 9.6	56+07								
57+00	181.4	172.00	9.6									
58+00	181.5	172.26	9.2									
59+00	182.3	172.52	9.8									
		182.5	9.8	59+50								
60+00	183.0	172.78	10.2									
61+00	184.0	173.04	11.0									
62+00	184.8	173.30	11.5			60+36		997707		1554 Kellogg		5-19-44
63+00	185.5	173.56	11.9	63+00								
64+00	185.8	173.82	12.0									
65+00	185.7	174.08	11.6									
66+00	185.3	174.34	11.0									
		185.0	10.4	66+35								
67+00	185.0	out 174.56 in 174.66 174.70	10.3 10.3									
68+00	184.0	174.96	9.0									
69+00	183.8	175.22	8.6									
70+00	181.5	175.48	6.0									
		180.0	4.3	70+75								
71+00	179.5	out 175.67 in 175.75	4.2 3.7									
72+00	179.5	176.08	3.4									
		179.5	3.4	72+23		4" P.V.C. 40 4" M.H. stub		9414167		10001 E Kellogg		2-2-44

12126 Tap 9901 E. Kellogg (Moose Club) Carter Libby 12-29-59 (69799.4)

B1295 - tap 10001 E. Kellogg (Moose - pool bath house) - Justice Libby 5-21-64

B1383 - tap 1000 E. 1st St 95 (Moose - swim pool) - Justice Libby 6-9-64

\* C16948 - tap 10225 E. Kellogg - Pizza Hut - 11-18-69 (M.H. Tap 70+75)

(no other info. on this tap - will be incl. in lat. dist. later)