




LAT. 5 SUB. 12 S.S. 22
UTILITY CONTRACTORS INC., JUNE 15 '59
BK. NO. K-65 PROJ. # C 86-98

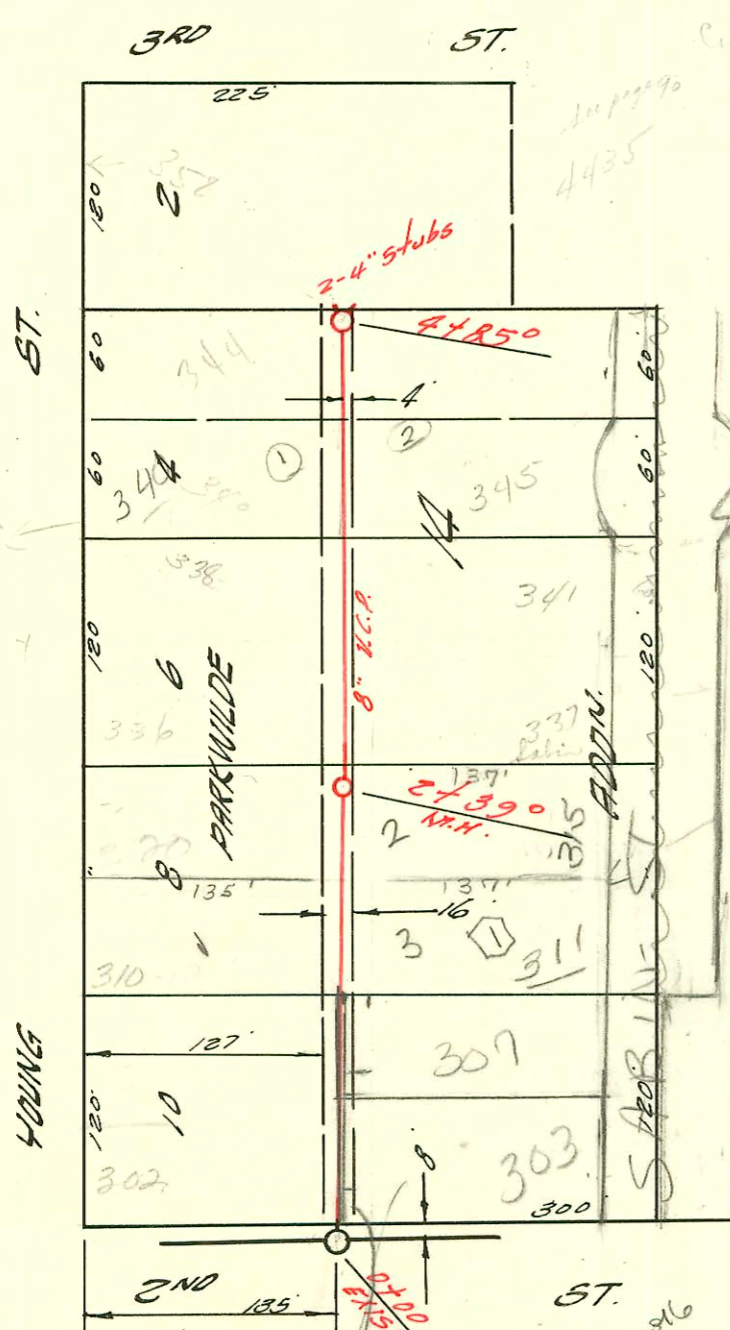


Cheslar D. Stephenson Add

ADD'L 2' ESM'T FOR 9.5' TAKEN AS PART OF LIS 2002-00846

LAT. 17 SUB. 10 S.S. 22
W. B. CARTER CONSTR. CO. JUNE 16, '59
BK. NO. K-56 PROJ. NO. C 27-34


1420 and 1426 Govt Private Easement Filed 10/25/59 1748 BR 12-4-59

14TH ST.

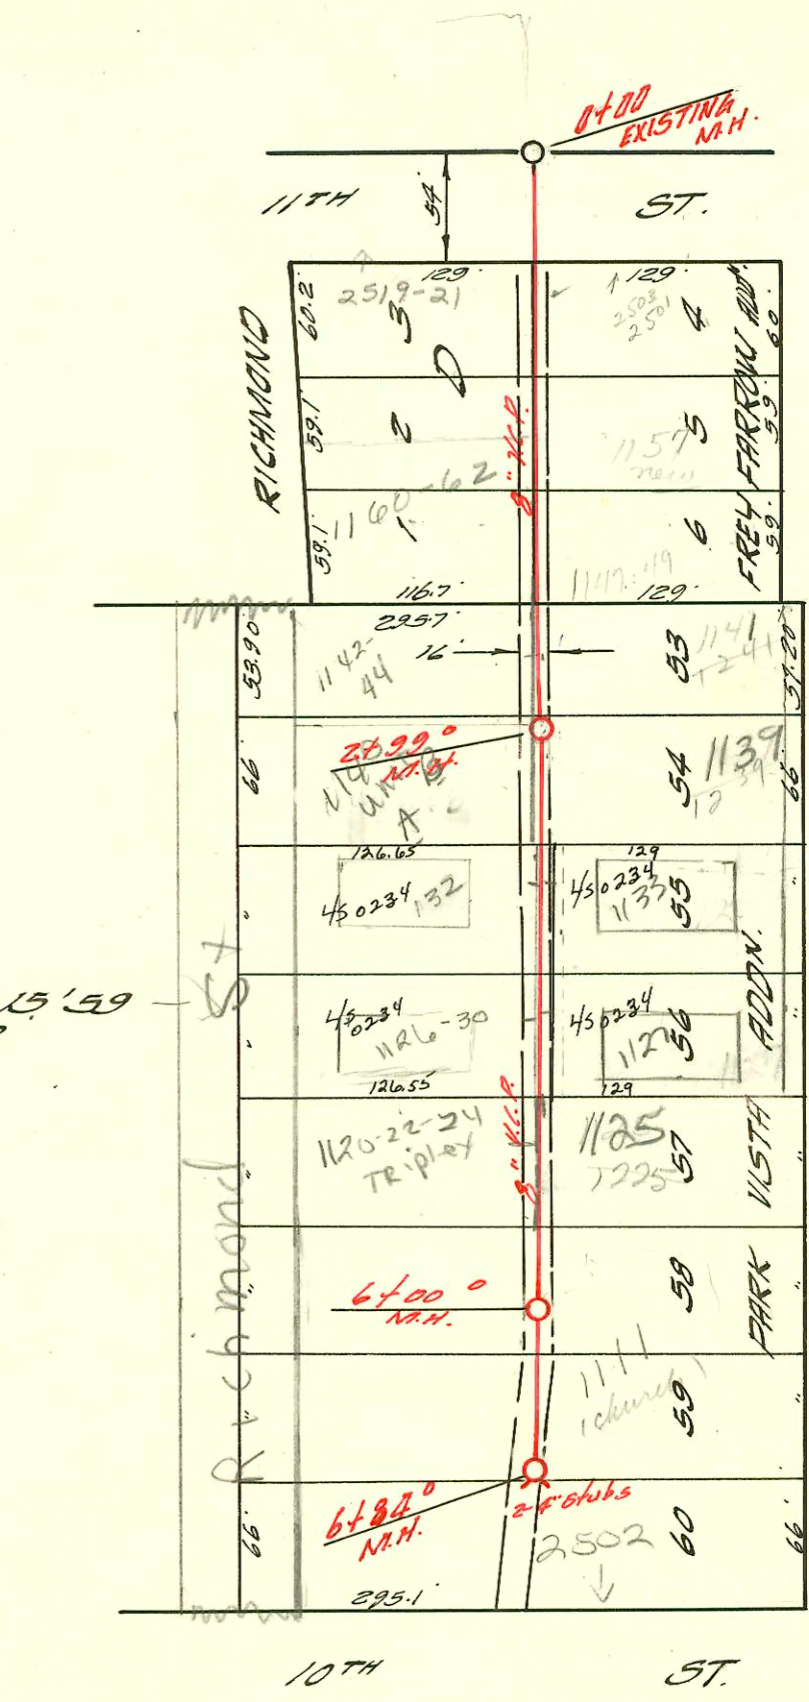

Neighbor had Rebutal Jacobs Add Replat 17-49

LAT. 60 SUB. 5 S.S. 22
W. B. CARTER CONSTR. CO. JUNE 16, '59
BK. NO. K-55 PROJ. NO. C 28-62

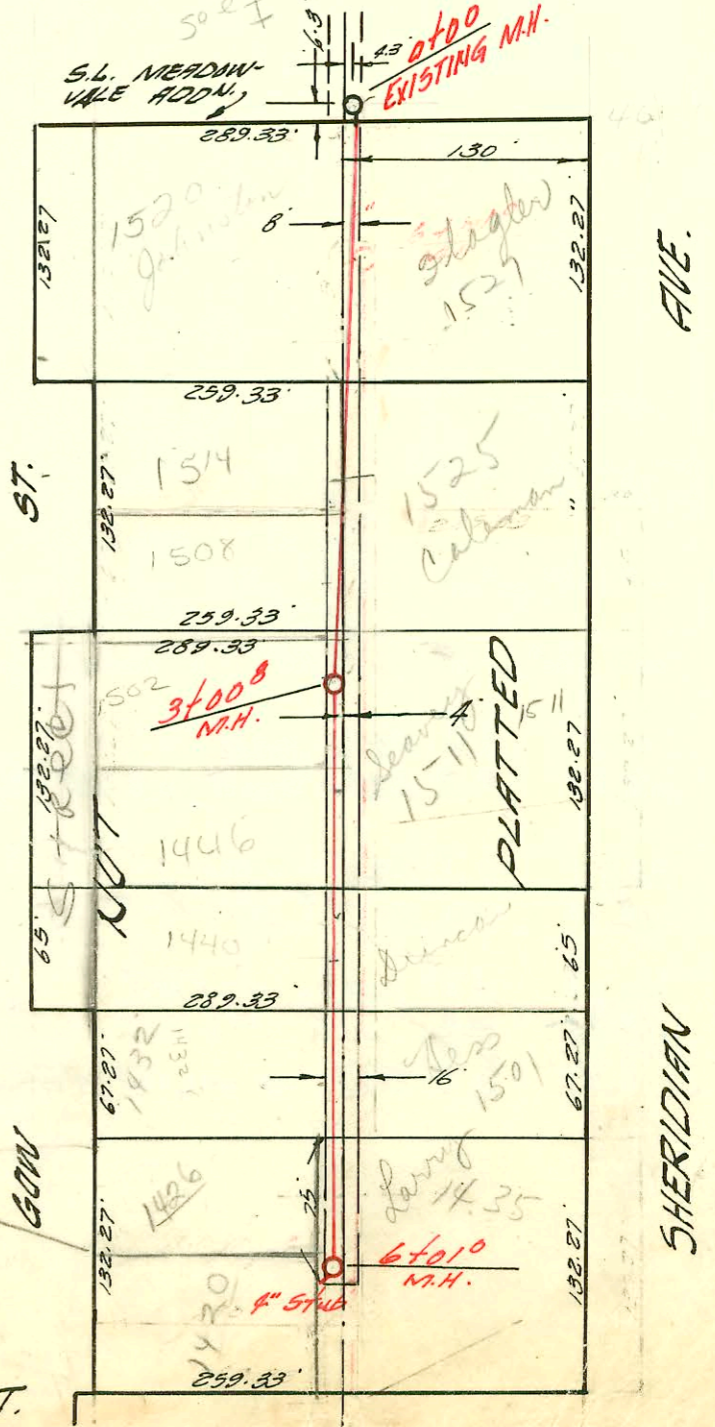

ST.

ST.

GOW

AVE.

SHERIDAN

CONSTRUCTION RECORD

SERVICE RECORD

STATION	ELEVATION		Depth	MANHOLE	4-INCH "Y" BRANCHES		No. of Permit		House Number		DATE OF PERMITS			
	Ground	Grade			North West	South East	North West	South East	North West	South East	North West	South East		
0400	116.9	108.94	8.0	Existing M.H.										
1400	116.8	109.34	6.5		+73° top 1+34.5 +82°	+71° 1+07.6 +30°	C17138	2519-21	2501-03 W. 11th		12-1-69			
2400	116.6	109.74	6.9		+97° top 1+80	+95°	C46420 C47010	2001-01800 1160-62 N. 1147.41 N.	W. 11th Richmond Meridian	8-30-74 10-15-74	7-19-01 10-15-74			
3400	117.1	110.14	7.0	3+99°	2+62°	2+81°	97-17107		1142-44 N Richmond		9-26-97			
4400	117.2	110.54	6.7		3+09° 3+82°	3+07° 3+80°	2001-05122 9819072	11314 75025	140 Richmond 112635 1127-31	1139 N Meridian 1239 N Meridian 1137 N Meridian	1-18-01 3-30-59	8-21-59 8-20-59		
5400	118.9	110.94	8.0		4+50°	+48°	98190917 98190907	98190897	112635 Richmond	1133-37 Meridian	10-7-98	10-7-98		
6400	119.3	111.34	8.0	6+00°	5+14° 5+70°	5+12° 5+68°	99-04179 1097		11202234 Richmond	1125 (new) Meridian	11-15-99	8-12-59		
	117.8	111.68	5.5	6+04°	6+35° 9' stubs	+33° S.E. & S.W.	98-4818 C4543	7	111 N. Meridian 2502 W. 11th		32648 8-21-67	6-15-59		
LAT. 60 SUB. 5 S.S. 22														
0400	118.6	109.30	9.3	Existing M.H.										
1400	118.9	109.70	9.2		0+66°	0+88°	2003 00145 12092	2003 00145 00062	302 N. Young	302 N. Sabin		1-21-03 31802		
2400	119.2	110.10	9.1		1+34.8 1+60.0 TAP	1+32.8 TAP 1+02.8	22645		310 Young	311 N Sabin		3-1-89		
3400	119.9	110.26	9.6	2+39°	2+08°	2+52°	20822	21690	315 N. Sabin		4-21-88	10-14-88 8-10-65		
4400	120.3	110.50	9.8		+85° 3+46.8	2+83°	B3916	B3917	336 N. Young 338 N. Young	337 N. Sabin		8-5-65		
5400	120.2	110.90	9.3		+29° +86°	+27° 3+85°	12289 10644	22966	341 N. Young	341 N. Sabin		1-31-67		
6400	119.0	111.29	7.8	4+85°	4+64°	+62°	23996 10667	22966	344 N. Young	345 N. Sabin		6-18-59	6-26-89	
LAT. 17 SUB. 10 S.S. 22														
0400	120.9	118.70	12.2	Existing M.H.										
1400	129.9	118.90	11.0		+87°	+25°	13743		1520 N. Gow			2-9-61		
2400	129.6	119.10	10.5		1+40.0 TAP 1+94°	+008° +92°	18119	1266	1541 N. Gow	1537 N. Sheridan		4-14-87	10-7-02 8-27-59	
3400	128.0	119.30	9.7	34008	2+50°	+48°	17882		1508 N. Gow			3-5-67		
4400	126.3	119.50	6.8		3+18° 3+56°	3+16°	17881	10696	1502 N. Gow	1511 N. Sheridan		3-3-87	6-25-59	
5400	124.9	119.70	5.2		4+40° 4+42.1	+38°	11367		1440 N. Gow	1505 N. Sheridan		8-31-59		
6400	124.7	119.90	4.8	6401°	5+01.8 5+41.1 TAP 5+58°	+24° +60°	C75401 3253	14076	1432 N. Gow	1501 N. Sheridan		4-19-79	5-6-81 12-4-81	4-17-61 7-16-59
					5+95.0 TAP 9' stubs	S.W.	24418	10872	1420 N. Gow			12-4-89		

Repair - 320 N. Young 11-22-78 - Langes - C69526 (2+08.9)

#10676 top - 310-12 N. Young S. Meridian P. by 6-22-59 (1+48) → C 23585 - Seal off 4-5-71

11315 Top 1241 N. Meridian Callison 8-25-59 2+38

12567 Top 1527 N. Sheridan Headpath 5-9-60 (0+82)

13736 Top 1159 N. Meridian Donaghy 1-6-61 (1+18)

2235 311 N. 358 N. Young (add old side) - Rep - (RWD) - 11/11/81