


LATERAL / SUB. S.S. 23
W.B. CARTER CONSTR. CO. AUG 11 '59
ADJ. NO. C 28-36 BK. 155



SCALE 1"=50'

→ Restico P/ly
Double Fing
work w/ P for Phil
4/11/97
BZ

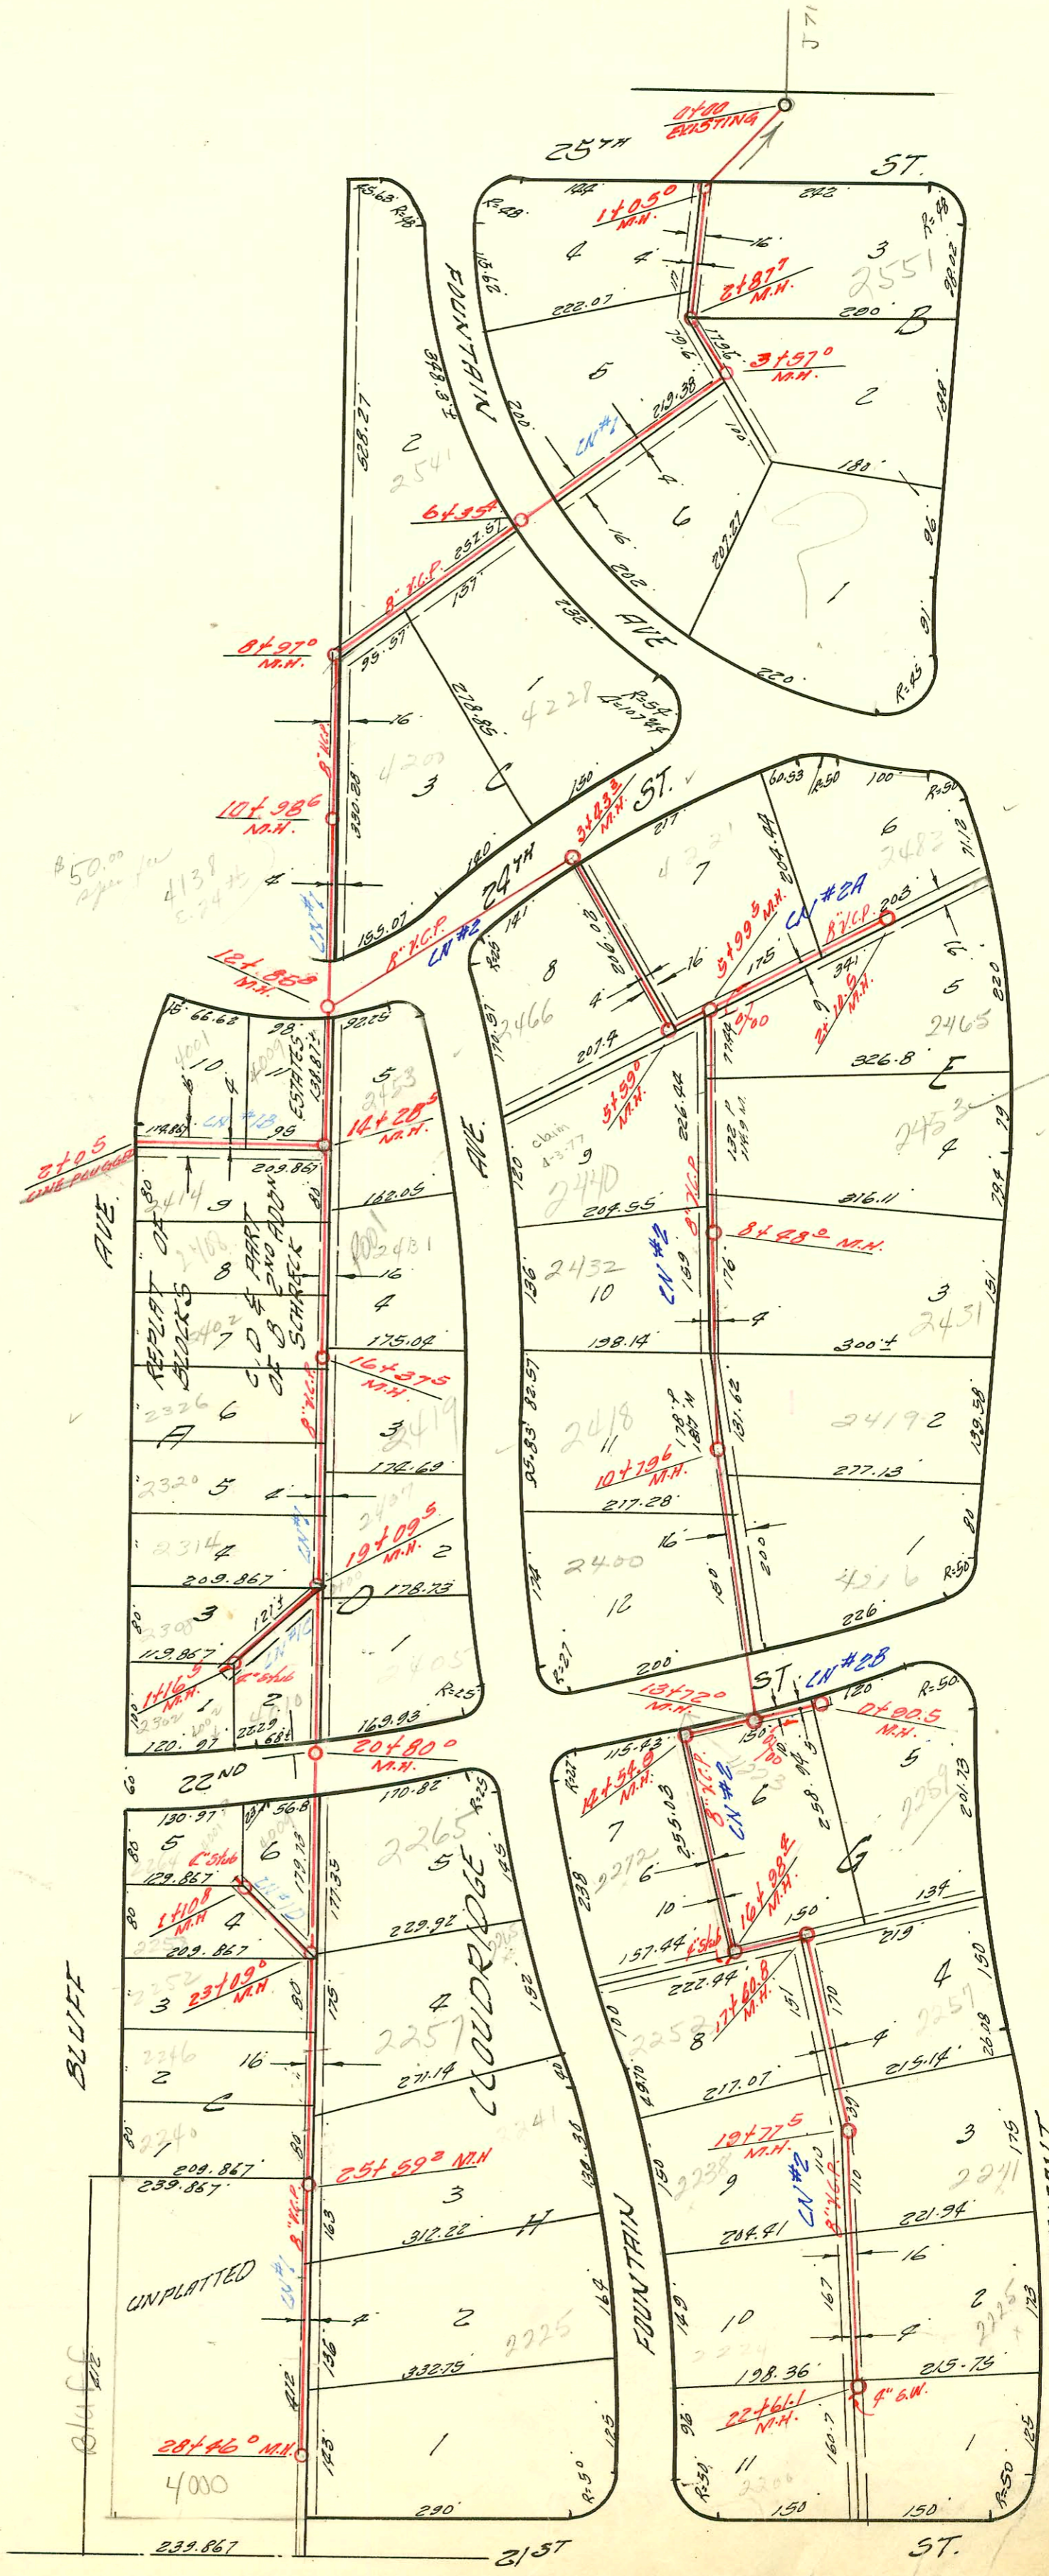